




PLAT OF SURVEY

- OF -

LOT 8 OF ROWENA PARK, A SUBDIVISION LOCATED IN SECTIONS,
 TOWN 1 NORTH, RANGE 17 EAST, WALWORTH COUNTY, WISCONSIN.


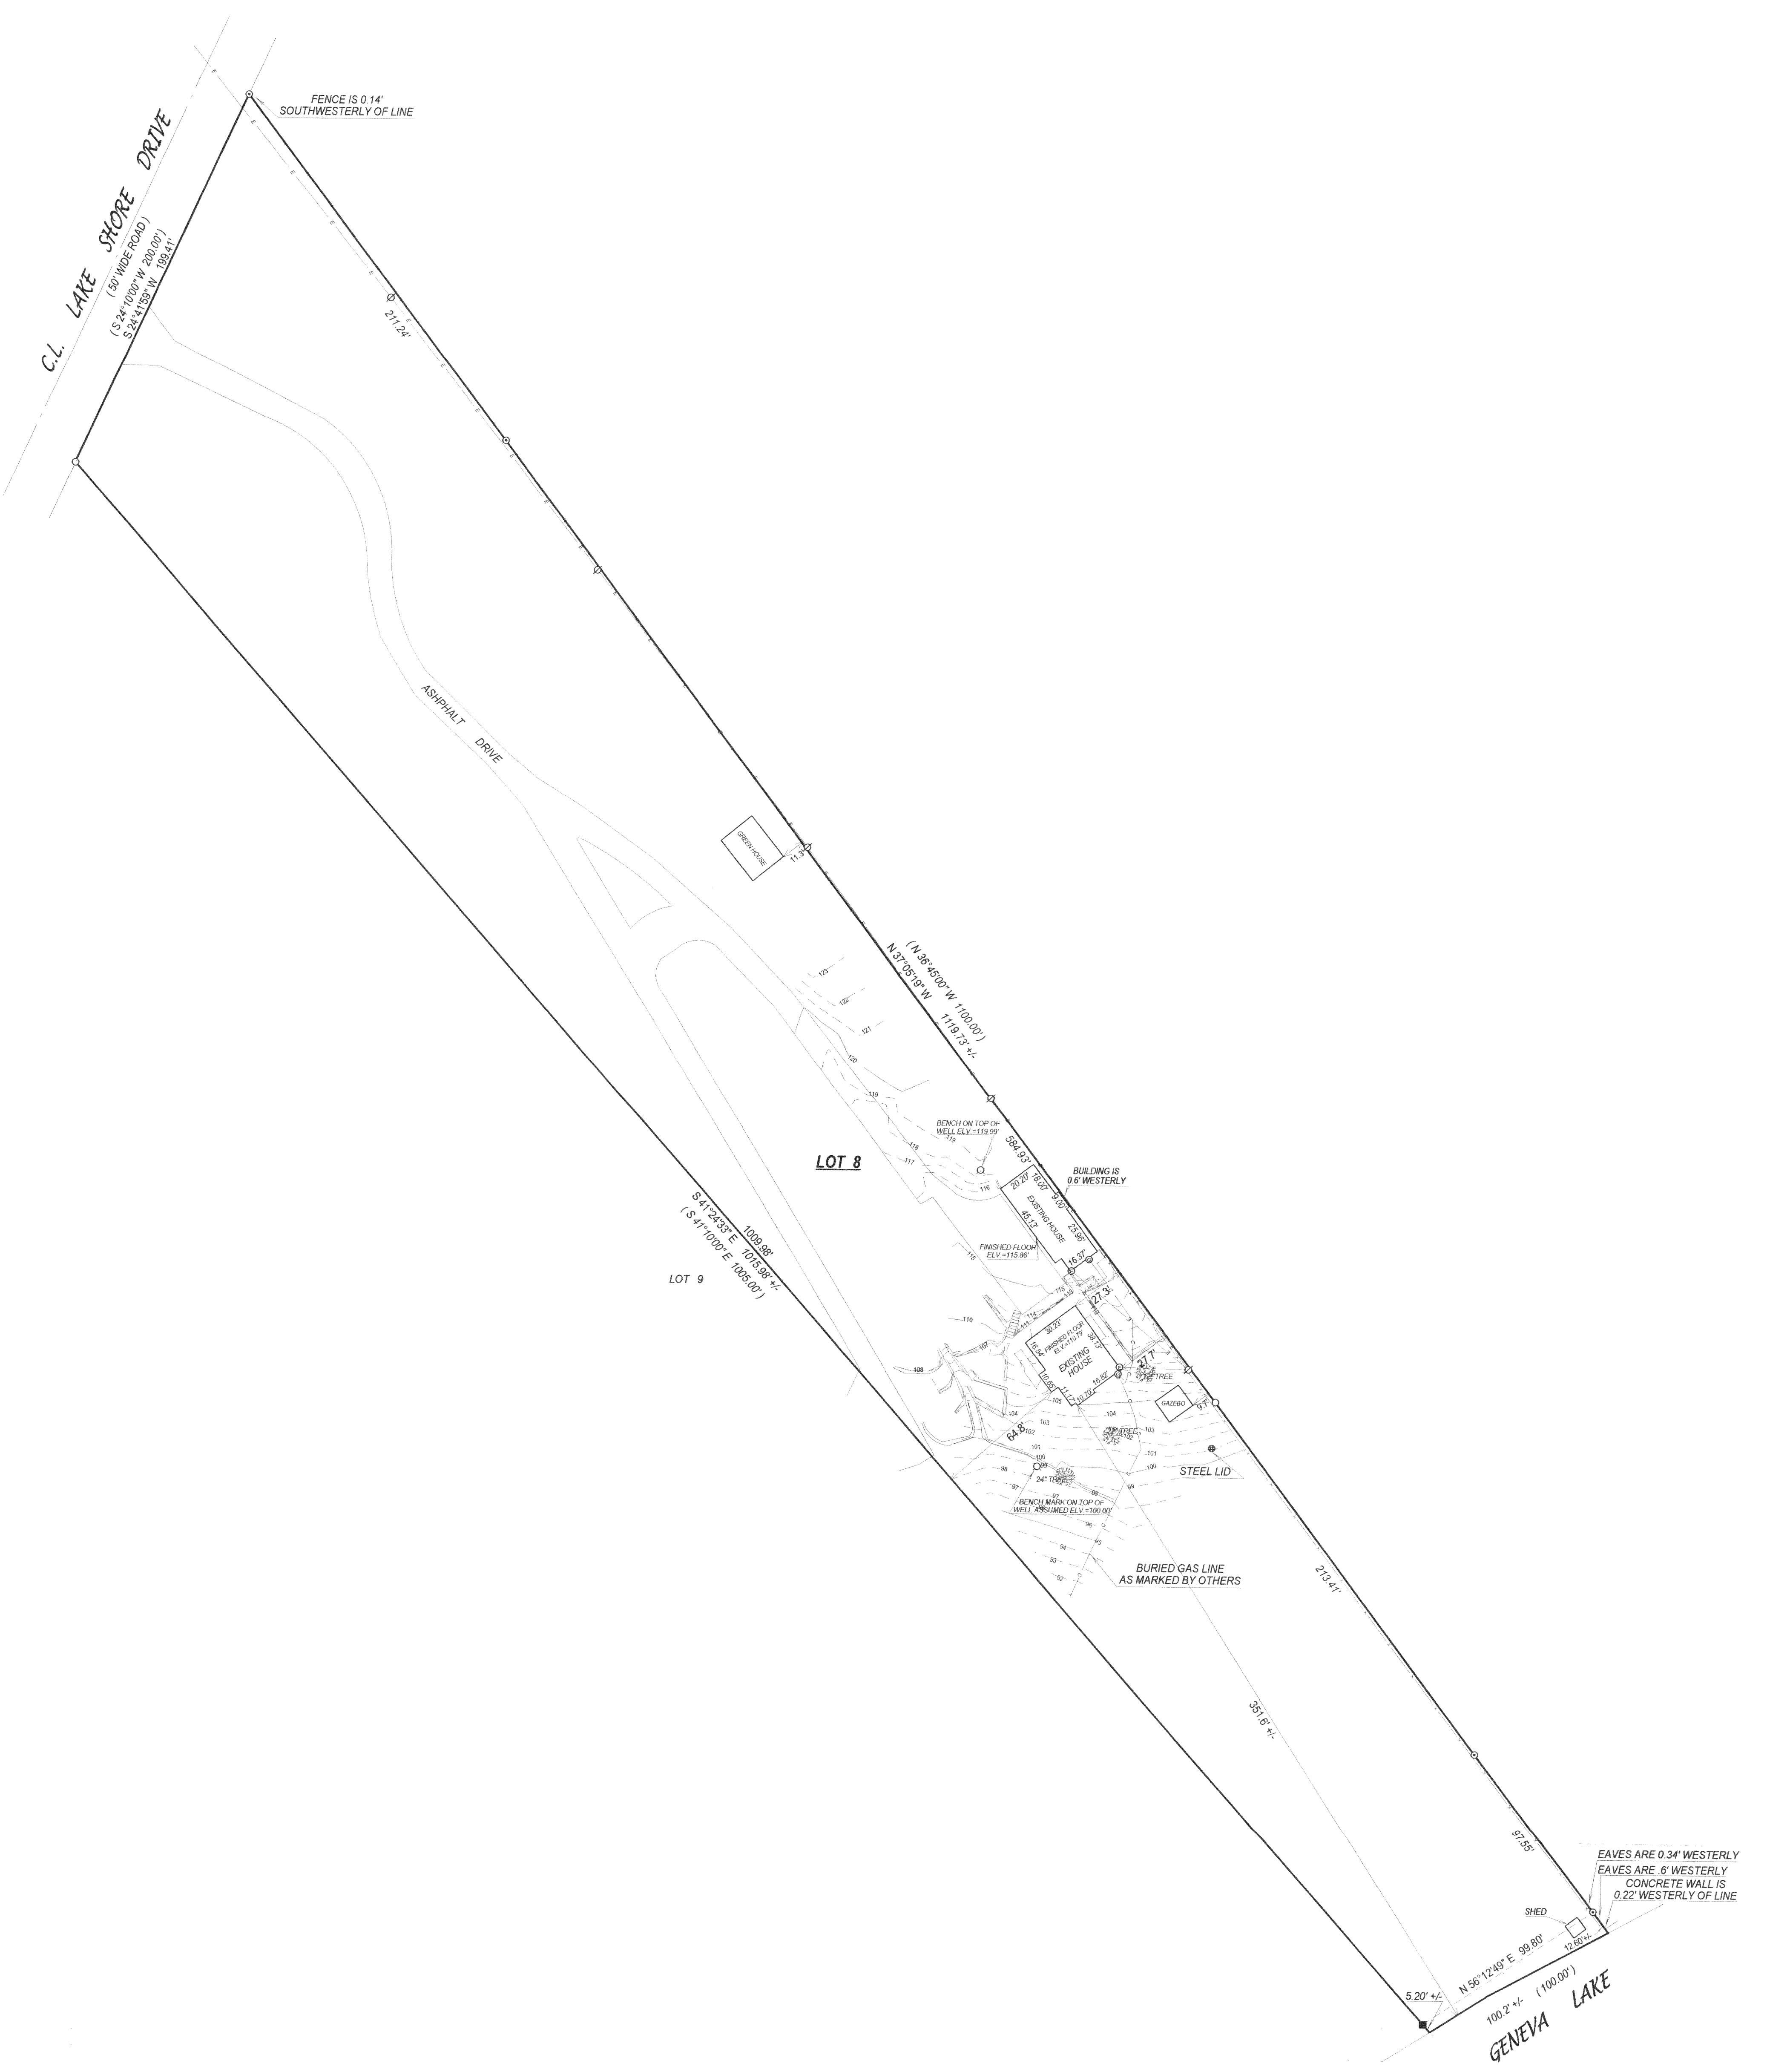


- = CONCRETE MONUMENT
 - ⊙ = POWER POLE
 - (E) = ELECTRIC METER
 - (G) = GAS METER
 - () = recorded as
 - = found iron bar
 - = found iron pipe
 - = set iron pipe
 - = set iron bar
- SCALE 1" = 40'

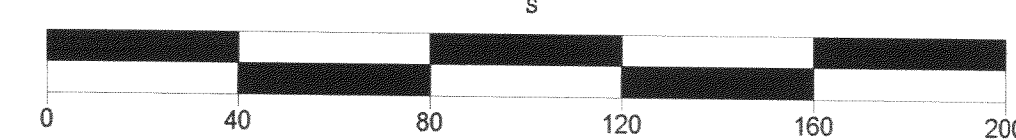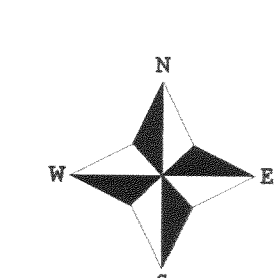

JOB # 04-481
 TAX ID # IRP00009

COMPARE LEGAL DESCRIPTION ABOVE AND DRAWING WITH DEED FOR BUILDING RESTRICTIONS AND EASEMENTS NOT SHOWN REFER TO DEED, ABSTRACT SOURCES AND LOCAL MUNICIPAL CODES. NOTIFY THE SURVEYOR IMMEDIATELY OF ANY DISCREPANCY.
 "I hereby certify that I have surveyed the above described property and that the above map, to the best of my knowledge and belief, is a true representation thereof and shows the size and location of all visible structures, apparent easements and encroachments if any."
 This survey is made for the present owners of the property, and those who purchase, mortgage, or guarantee the title thereto, within one year from the date hereof.

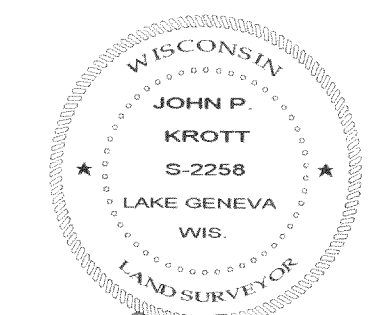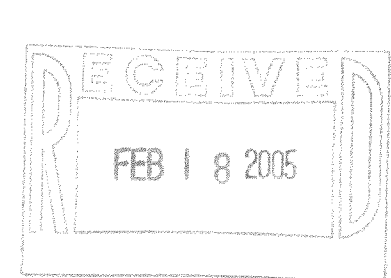

John P. Krott
 JOHN KROTT S - 2258
 Wisconsin Registered Land Surveyor
 (original if signed in red)

DATED THIS THE 24th DAY OF SEPTEMBER 2004.