
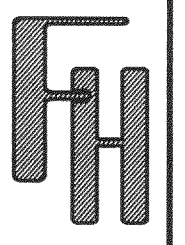


# PLAT OF SURVEY

## BUILDING PERMIT PLAT

UNIT 2  
SOUTH SHORE CLUB ON LAKE GENEVA  
A CONDOMINIUM  
REC. IN CAB. A, SLIDE 394, DOC. NO. 500527

LOCATED IN CERTIFIED SURVEY MAP 2631  
RECORDED IN VOL. 13 OF CERTIFIED SURVEYS  
ON PAGE 171, AS DOCUMENT NUMBER 311927  
BEING IN ALL 1/4'S OF NE 1/4 OF  
SECTION 18, TOWN 1 NORTH, RANGE 17 EAST  
WALWORTH COUNTY, WISCONSIN

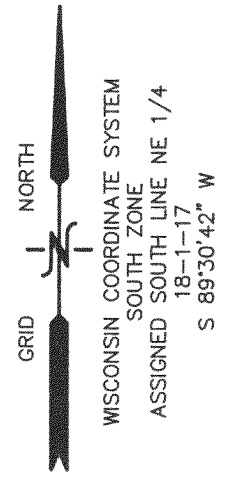



WORK ORDERED BY -  
TOM COWAN - GENE DARFLER, INC.  
506 EAST HIGHLAND AVENUE  
NAPERVILLE, IL 60540

FARRIS, HANSEN & ASSOCIATES, INC.  
ENGINEERING - ARCHITECTURE - SURVEYING  
7 RIDGWAY COURT P.O. BOX 437  
ELKHORN, WISCONSIN 53121  
OFFICE: (262) 723-2098 FAX: (262) 723-5886

REVISIONS  
09/14/2005  
SITE, GRADING,  
DRAINAGE, &  
EROSION  
CONTROL PLAN  
11/09/2005  
TO SHOW SIZE  
AND LOCATION  
OF AS-BUILT  
FOUNDATION

PROJECT NO.  
4161.02  
DATE:  
08/10/05  
SHEET NO.  
1 OF 1

- LEGEND
- XXX--- = EXISTING CONTOURS
  - XXX--- = PROPOSED CONTOURS
  - = TREE TO BE REMOVED
  - F.F. = FIRST FLOOR ELEVATION
  - T.F. = TOP OF FOUNDATION ELEVATION
  - G.E. = GARAGE ENTRY ELEVATION
  - BASE = BASEMENT ELEVEMENT

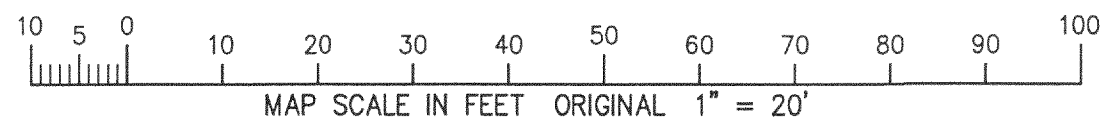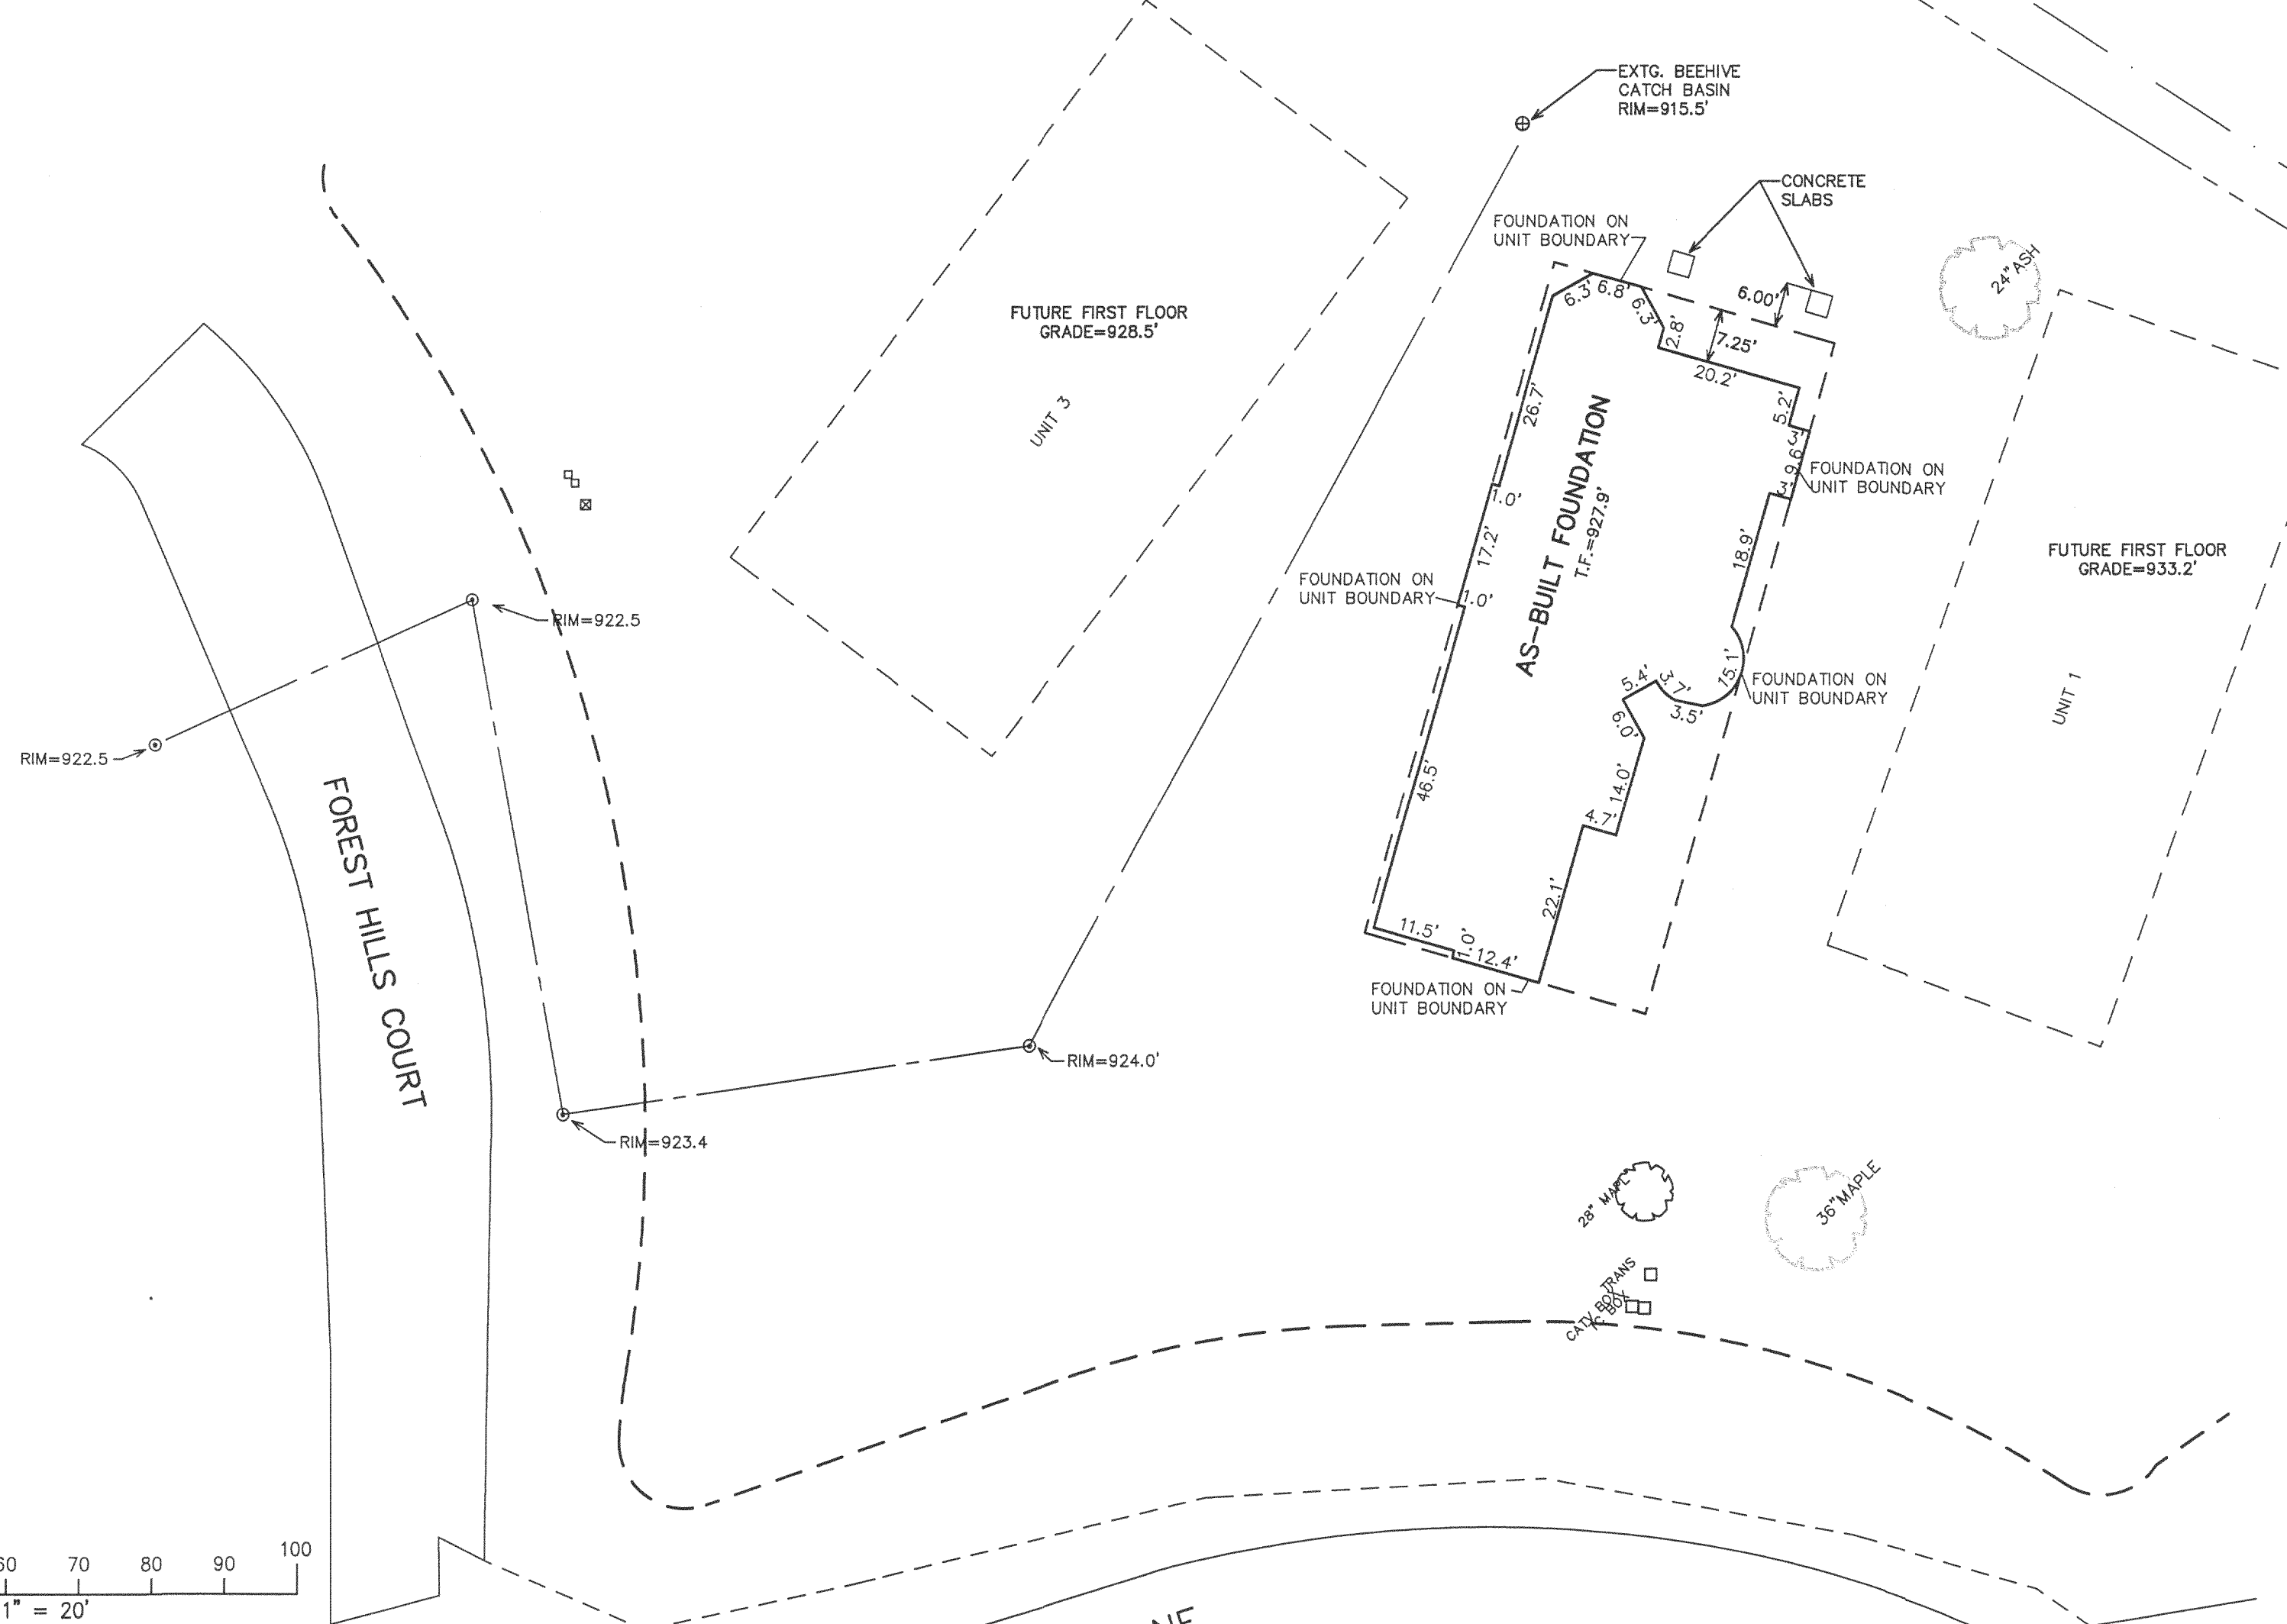

NOTE: COPIES OF THIS MAP TO WHICH THE FOLLOWING CERTIFICATE WILL APPLY SHOW SURVEYOR'S ORIGINAL SEAL AND SIGNATURE IN RED INK. COPIES BY ANY OTHER MEANS MAY HAVE ALTERATIONS WHICH DO NOT REPRESENT THE SURVEYOR'S WORK PRODUCT.


I HEREBY CERTIFY THAT THE ABOVE DESCRIBED PROPERTY HAS BEEN SURVEYED UNDER MY DIRECTION AND THAT THE ABOVE MAP IS A TRUE REPRESENTATION THEREOF AND SHOWS THE SIZE AND LOCATION OF THE PROPERTY AND ITS EXTERIOR BOUNDARIES. THIS SURVEY IS MADE FOR THE USE OF THE PRESENT OWNERS OF THE PROPERTY, AND ALSO THOSE WHO PURCHASE, MORTGAGE, OR GUARANTEE THE TITLE THERETO WITHIN ONE YEAR FROM THE DATE HEREOF.

DATED: AUGUST 10, 2005

REVISED 10-03-2005

REVISED 11-09-2005  
TO SHOW SIZE & LOCATION OF  
AS BUILT FOUNDATION

PETER S. GORDON R.L.S. 2101

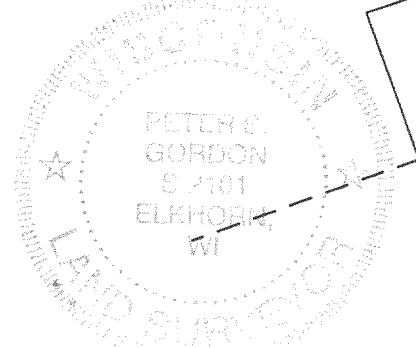

155C-2

117-2618

11/9/2005 X:\Projects\161\INDV\LOTS\Lot\_2\Draw\AS-BUILT

AUG 0 9 2005