


DETAIL OF SECTION A-B SHOWING LOCATION OF BUILDINGS

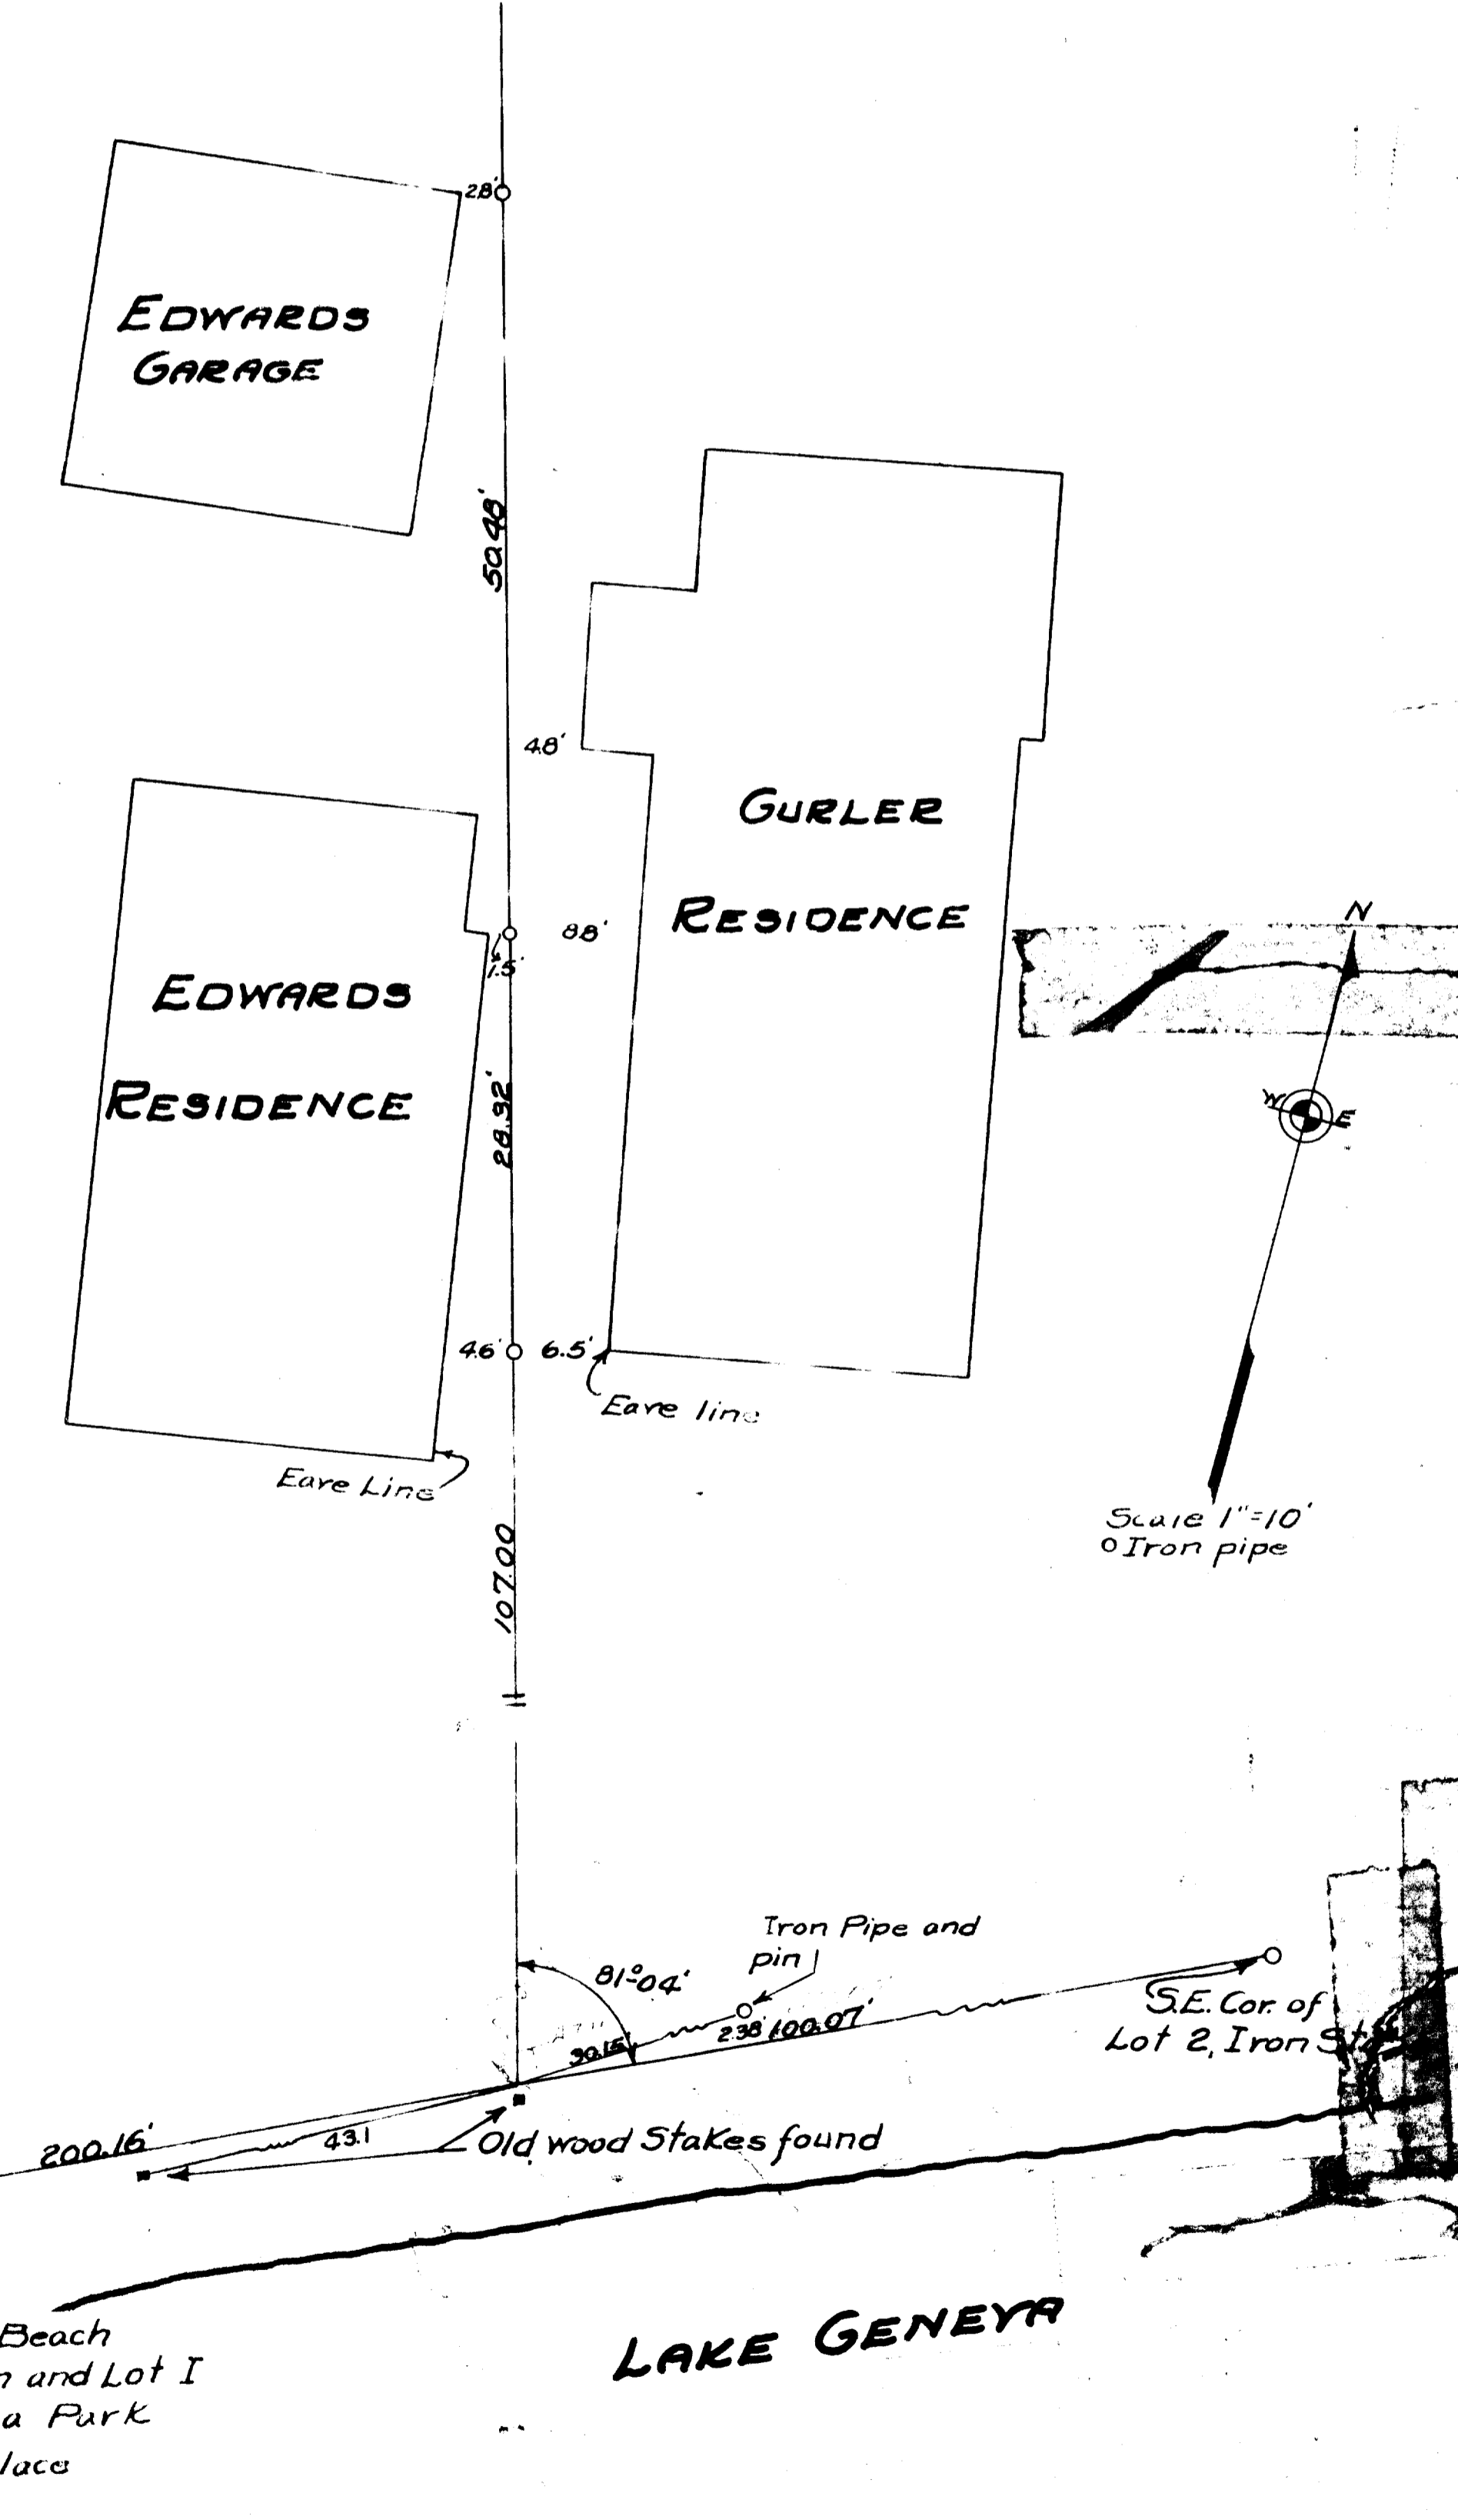

SURVEY OF LOTS 2, 3, 4 & 5 OF ROWENA PARK LOCATED IN SECTION 5, T1N, R17E

JANUARY 10, 1934
 Lloyd S. Jensen
 COUNTY SURVEYOR

117-3-1
 117-3-1