


ABELL  
SURVEYING & MAPPING

1140 SEQUOIA STREET • DELAVAN, WISCONSIN 53115  
262-728-6737

CERTIFIED SURVEY MAP NO. 815

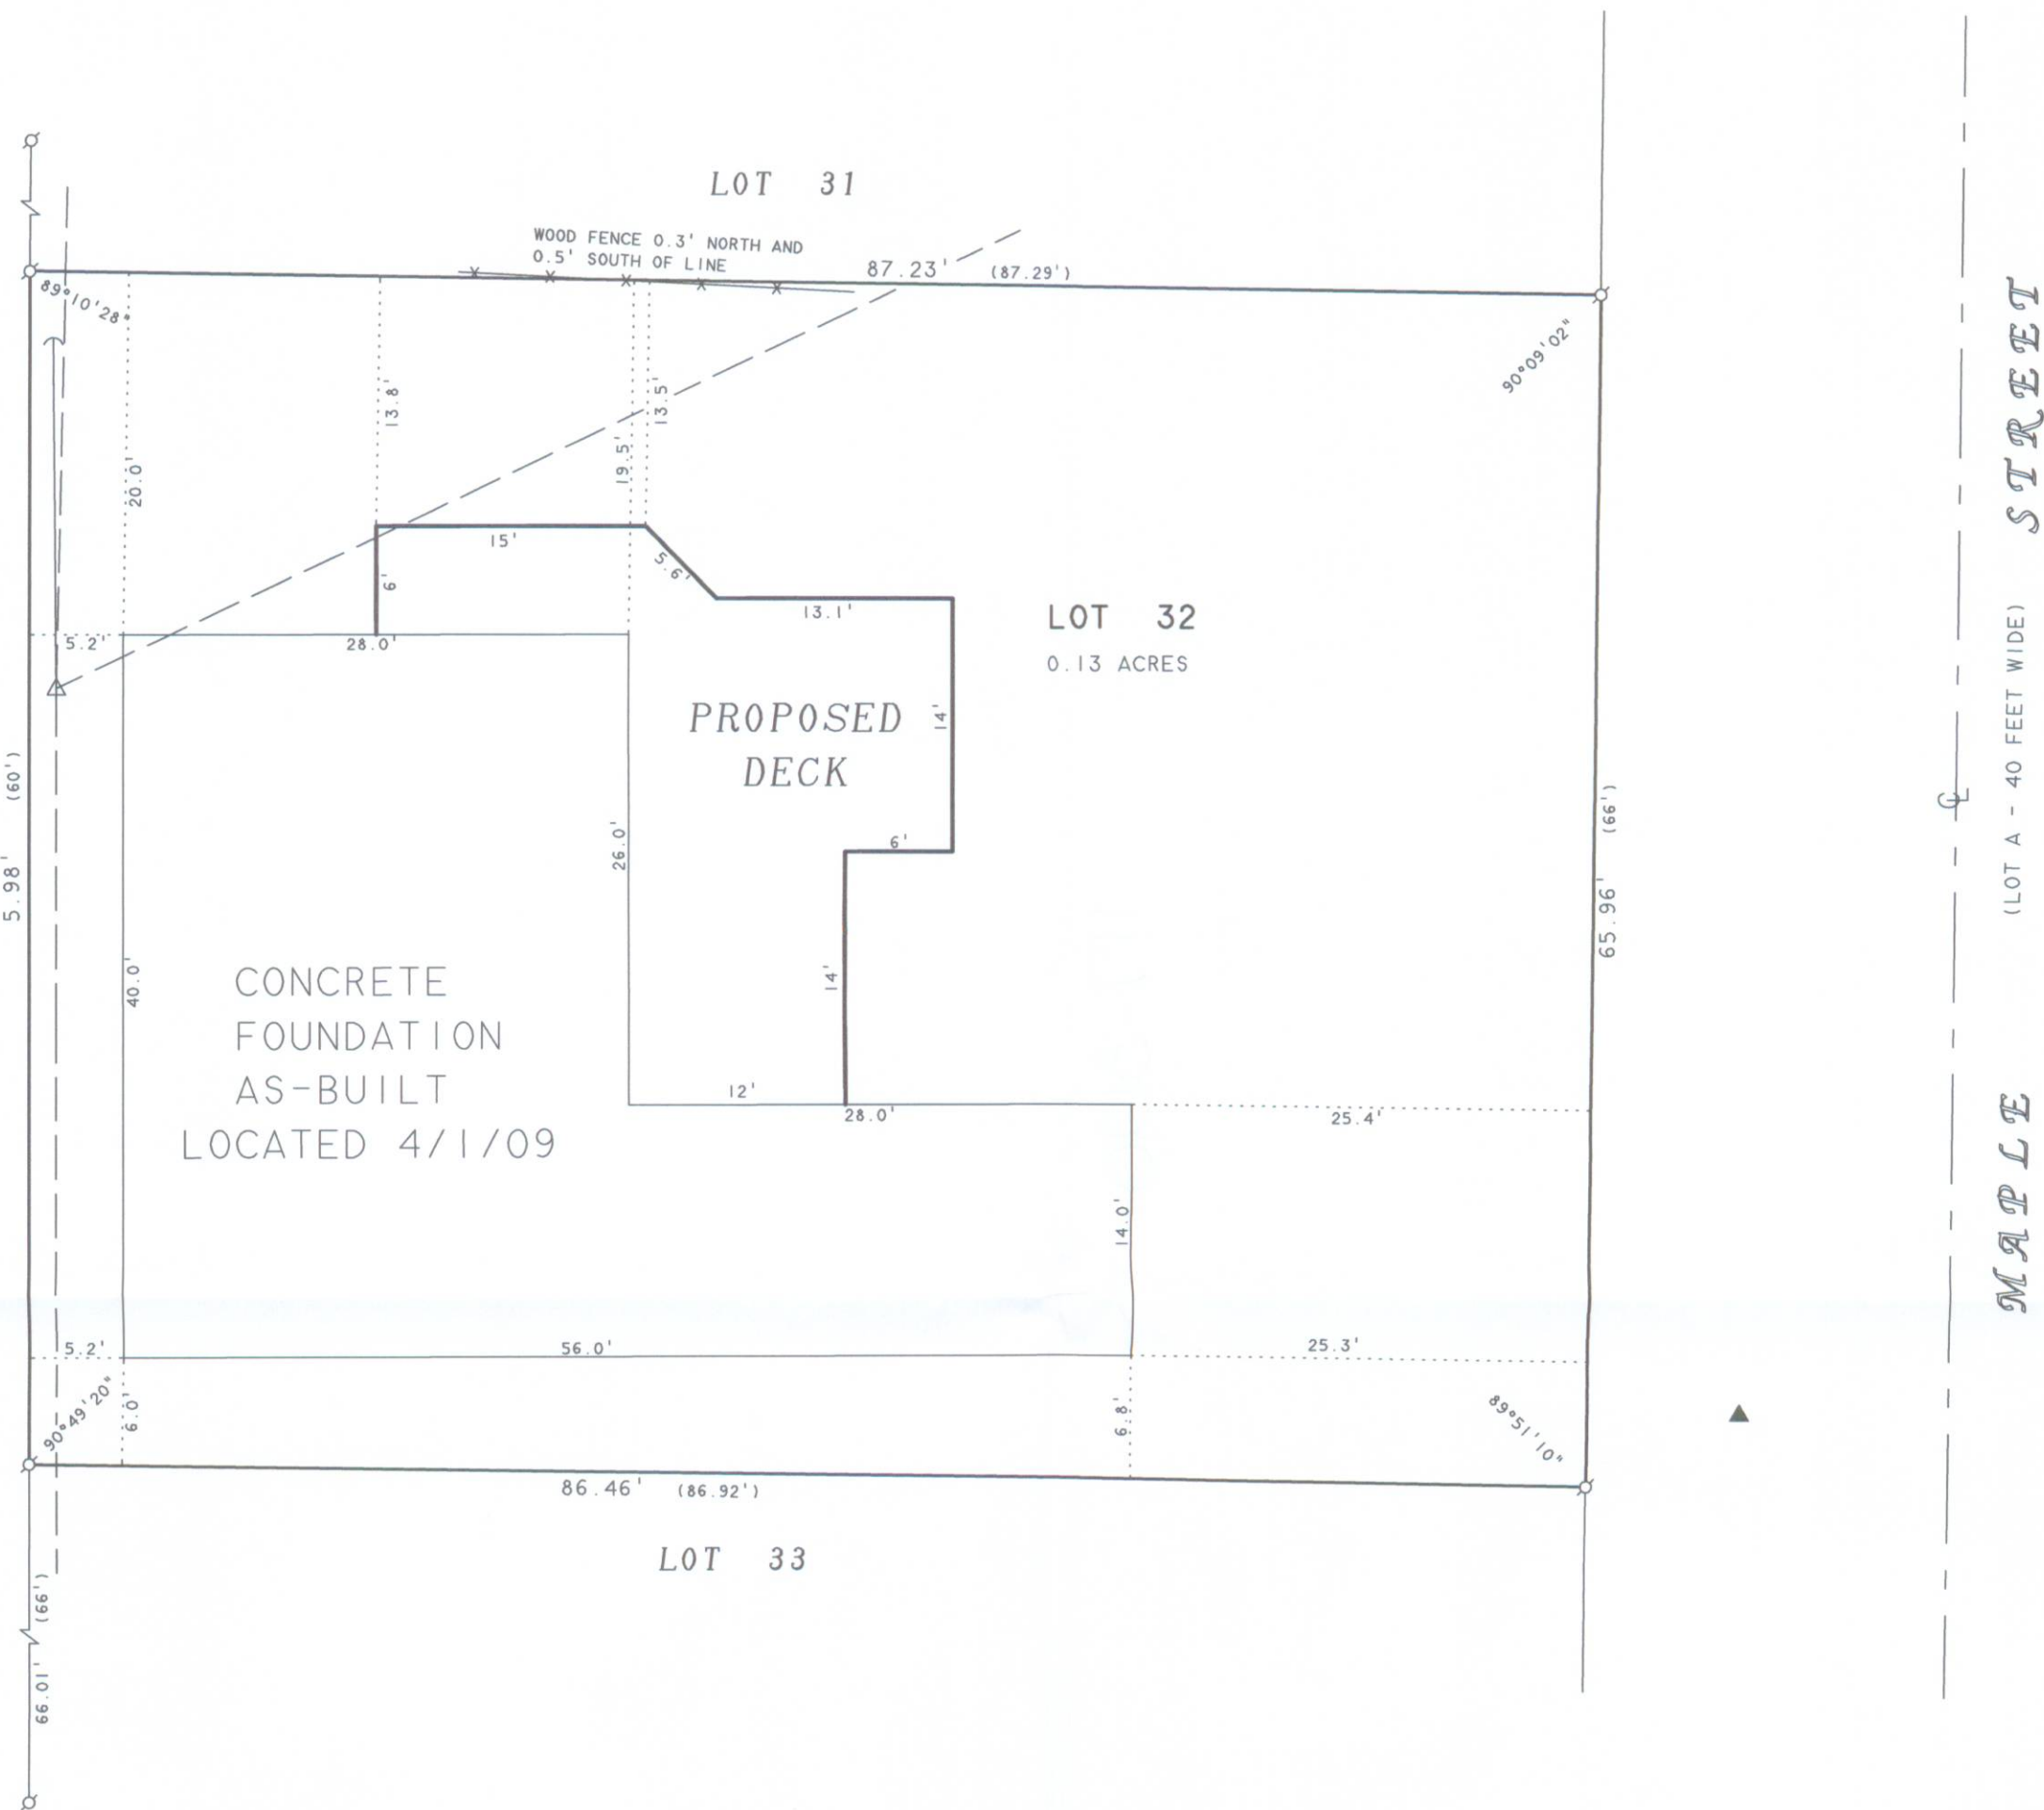

PLAT OF SURVEY OF


LOT 32 OF ROBINSONS 2nd SUBDIVISION,  
LOCATED IN T1N, R17E, TOWN OF LINN,  
WALWORTH COUNTY, WISCONSIN.



SCALE 1" = 10'

LEGEND

- - IRON PIPE FOUND
- △ - UTILITY POLE
- — — - OVERHEAD UTILITY LINES
- — — - GUYWIRE
- x — x — - WOOD FENCE
- ▲ - UNDERGROUND GAS SIGN
- ( ) - RECORDED AS

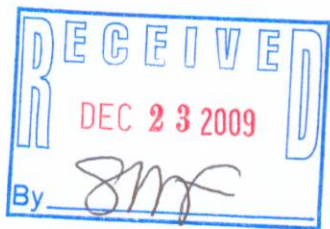

I HEREBY CERTIFY THAT I HAVE SURVEYED THE ABOVE DESCRIBED PROPERTY AND THAT THE ABOVE MAP IS A TRUE REPRESENTATION THEREOF AND SHOWS THE SIZE AND LOCATION OF THE PROPERTY, ITS EXTERIOR BOUNDARIES, THE LOCATION OF ALL VISIBLE STRUCTURES AND DIMENSIONS OF ALL PRINCIPAL BUILDINGS THEREON, BOUNDARY FENCES, APPARENT EASEMENTS, ROADWAYS AND VISIBLE ENCROACHMENTS, IF ANY, TO THE BEST OF MY KNOWLEDGE AND BELIEF.

THIS SURVEY IS MADE FOR THE USE OF THE PRESENT OWNERS OF THE PROPERTY, AND ALSO THOSE WHO PURCHASE, MORTGAGE, OR GUARANTEE THE TITLE THERETO WITHIN ONE (1) YEAR FROM DATE HEREON.

*David F. Abell*

DAVID F. ABELL  
WISCONSIN REGISTERED LAND SURVEYOR, S-1596

ORDERED BY: STURG TAGGART  
WISCONSIN HOMES OF LAKE GENEVA  
98 E. MAIN STREET  
LAKE GENEVA, WI 53147

REVISED: MAY 14, 2009 TO SHOW THE PROPOSED DECK.

April 2, 2009

DATE: April 2, 2009 JOB NUMBER - 08029D

NOTE: THIS IS NOT A CERTIFIED COPY UNLESS SEALED.

IRB2-26A

177-3120