

SCALE - 1"=30'

LEGEND

- ⊙ - IRON PIPE FOUND
- - IRON ROD FOUND
- () - RECORDED AS


SURVEYED BY:
 ABELL SURVEYING & MAPPING
 1140 SEQUOIA STREET
 DELAVAN, WI. 53115
 414-728-6737

PLAT OF SURVEY OF

LOTS 30-32 OF THE BIRCHES 2nd ADDITION, LOCATED IN T1N,R17E, WALWORTH COUNTY, WISCONSIN.

OWNER: GEORGE & JUDY WEYROUGH

ORDERED BY: ANCHOR SAVINGS & LOAN
 P.O. BOX 508
 LAKE GENEVA, WI. 53147

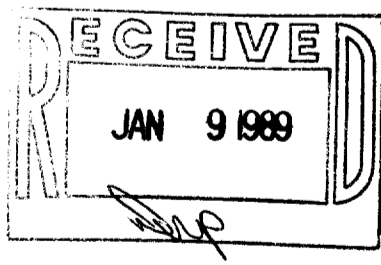

I HEREBY CERTIFY THAT I HAVE SURVEYED THE ABOVE DESCRIBED PROPERTY AND THAT THE ABOVE MAP IS A TRUE REPRESENTATION THEREOF AND SHOWS THE SIZE AND LOCATION OF THE PROPERTY, ITS EXTERIOR BOUNDARIES, THE LOCATION OF ALL VISIBLE STRUCTURES AND DIMENSIONS OF ALL PRINCIPAL BUILDINGS THEREON, BOUNDARIES FENCES, APPARENT EASEMENTS, ROADWAYS AND VISIBLE ENCROACHMENTS, IF ANY, TO THE BEST OF MY KNOWLEDGE AND BELIEF.

THIS SURVEY IS MADE FOR THE USE OF THE PRESENT OWNERS OF THE PROPERTY, AND ALSO THOSE WHO PURCHASE, MORTGAGE, OR GUARANTEE THE TITLE THERETO WITHIN ONE (1) YEAR FROM DATE HEREOF.

David F. Abell

DAVID F. ABELL
 WISCONSIN REGISTERED LAND SURVEYOR, S-1596

November 16, 1988

DATE: _____ JOB NUMBER - 88259
 NOTE: THIS IS NOT A CERTIFIED COPY UNLESS SEALED.