
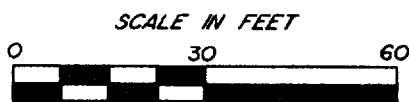
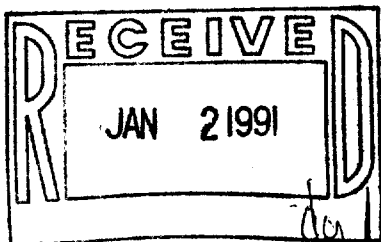


WALWORTH COUNTY
SURVEYING & MAPPING
LAKE GENEVA, WISCONSIN
414-248-0505

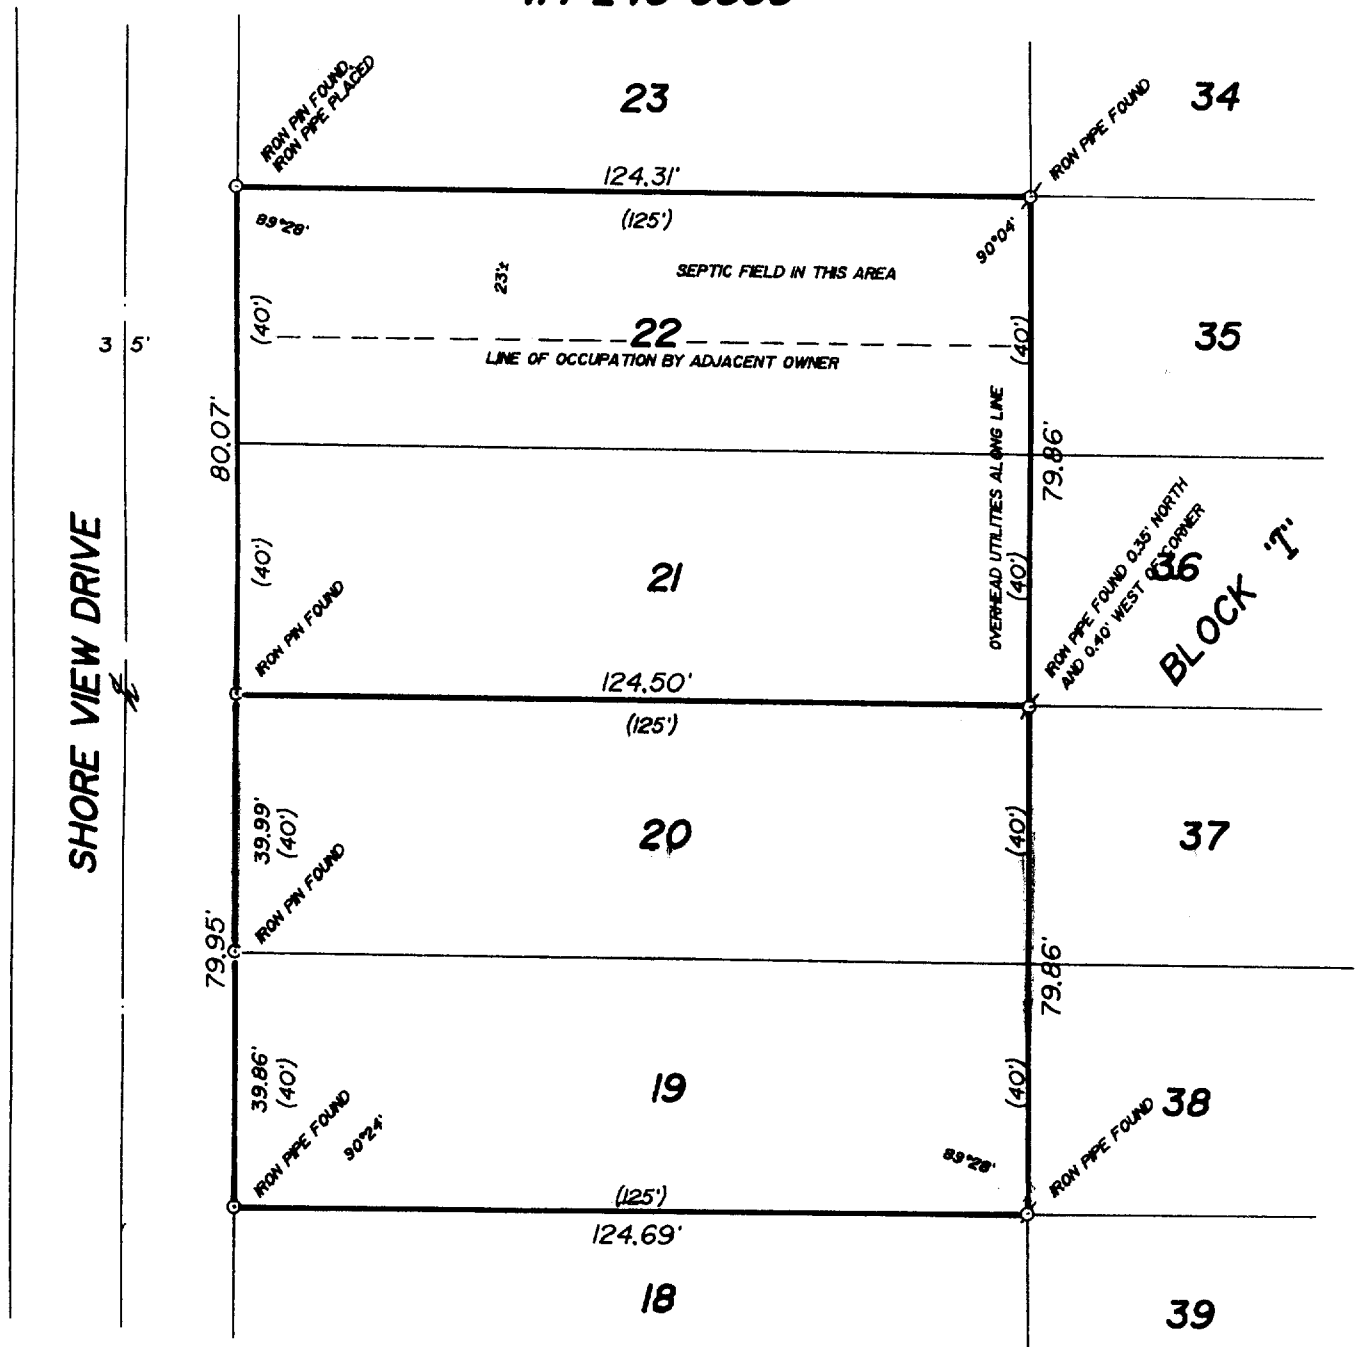

PLAT OF SURVEY OF

LOTS 19-22. BLOCK I OF CISCO BEACH, LOCATED
IN T 1 N, R 17 E, WALWORTH COUNTY, WISCONSIN.

ORDERED BY: MADELINE WAHLGREN
10106 WEST PARKVIEW
PALOS PARK, ILLINOIS.
60464

I HEREBY CERTIFY THAT I HAVE SURVEYED THE ABOVE DESCRIBED PROPERTY AND THAT THE ABOVE MAP IS A TRUE REPRESENTATION THEREOF AND SHOWS THE SIZE AND LOCATION OF THE PROPERTY, ITS EXTERIOR BOUNDARIES, THE LOCATION OF ALL VISIBLE STRUCTURES AND DIMENSIONS OF ALL PRINCIPAL BUILDINGS THEREON, BOUNDARY FENCES, APPARENT EASEMENTS AND ROADWAYS AND VISIBLE ENCROACHMENTS, IF ANY, TO THE BEST OF MY KNOWLEDGE AND BELIEF.

THIS SURVEY IS MADE FOR THE USE OF THE PRESENT OWNERS OF THE PROPERTY AND ALSO THOSE WHO PURCHASE, MORTGAGE OR GUARANTEE THE TITLE THERETO WITHIN ONE (1) YEAR FROM DATE HEREOF.

Robert M. Baerenwald
ROBERT M. BAERENWALD
WISCONSIN REGISTERED LAND SURVEYOR, S-1508




Oct. 18, 1989
DATE: OCT 18 1989

NOTE: THIS IS NOT A CERTIFIED COPY UNLESS SEALED

Survey# 117-1015

TAX KEY# ICI 00200
ICI 00200C
ICI 00200D

WALWORTH COUNTY
SURVEYING & MAPPING
LAKE GENEVA, WISCONSIN
414-248-0505

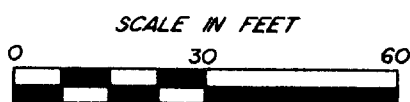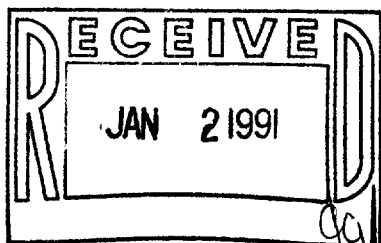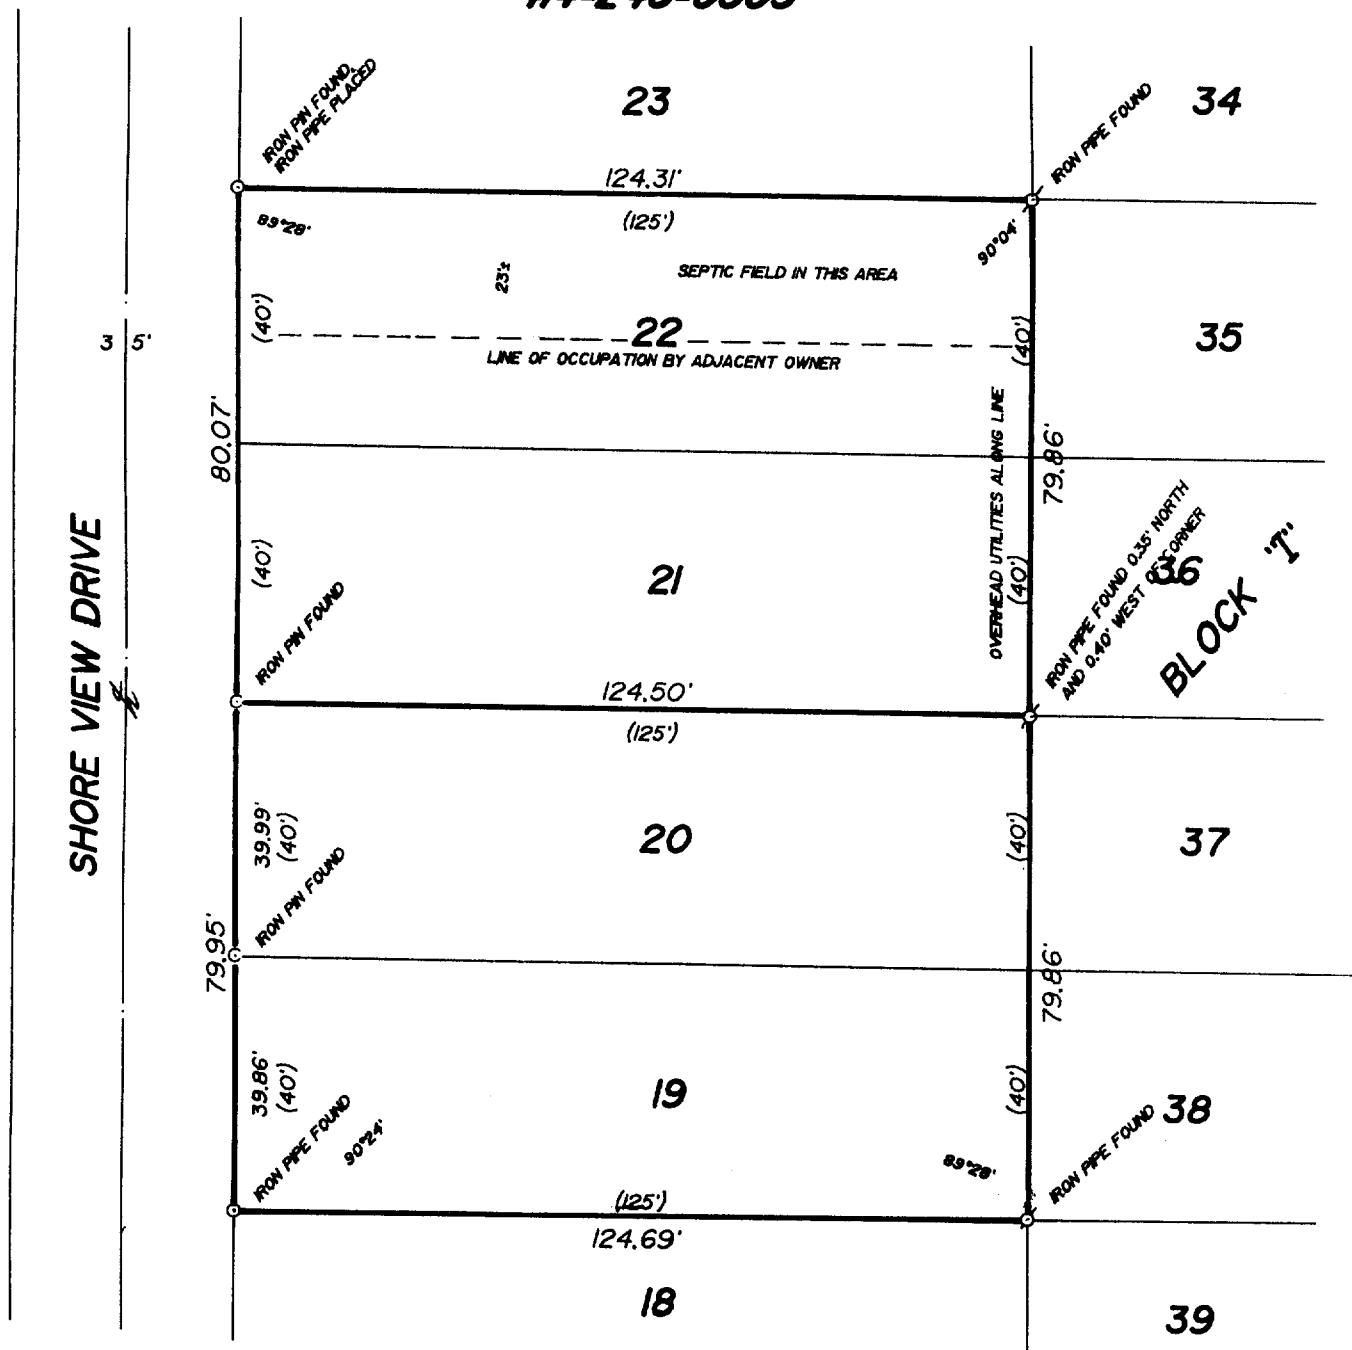

PLAT OF SURVEY OF

LOTS 19-22. BLOCK I OF CISCO BEACH, LOCATED
IN T 1 N, R 17 E, WALWORTH COUNTY, WISCONSIN.

ORDERED BY: MADELINE WAHLGREN
10106 WEST PARKVIEW
PALOS PARK, ILLINOIS.
60464

I HEREBY CERTIFY THAT I HAVE SURVEYED THE ABOVE DESCRIBED PROPERTY AND THAT THE ABOVE MAP IS A TRUE REPRESENTATION THEREOF AND SHOWS THE SIZE AND LOCATION OF THE PROPERTY, ITS EXTERIOR BOUNDARIES, THE LOCATION OF ALL VISIBLE STRUCTURES AND DIMENSIONS OF ALL PRINCIPAL BUILDINGS THEREON, BOUNDARY FENCES, APPARENT EASEMENTS AND ROADWAYS AND VISIBLE ENCROACHMENTS, IF ANY, TO THE BEST OF MY KNOWLEDGE AND BELIEF.

THIS SURVEY IS MADE FOR THE USE OF THE PRESENT OWNERS OF THE PROPERTY AND ALSO THOSE WHO PURCHASE, MORTGAGE OR GUARANTEE THE TITLE THERETO WITHIN ONE (1) YEAR FROM DATE HEREOF.



Robert M. Baerenwald
ROBERT M. BAERENWALD
WISCONSIN REGISTERED LAND SURVEYOR, S-1508

Oct. 15, 1989
DATE: _____ JOB NO: 2047

NOTE: THIS IS NOT A CERTIFIED COPY UNLESS SEALED

WALWORTH COUNTY
SURVEYING & MAPPING
LAKE GENEVA, WISCONSIN
414-248-0505


SHORE VIEW DRIVE

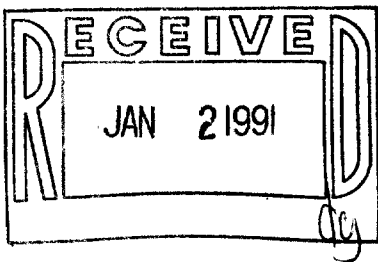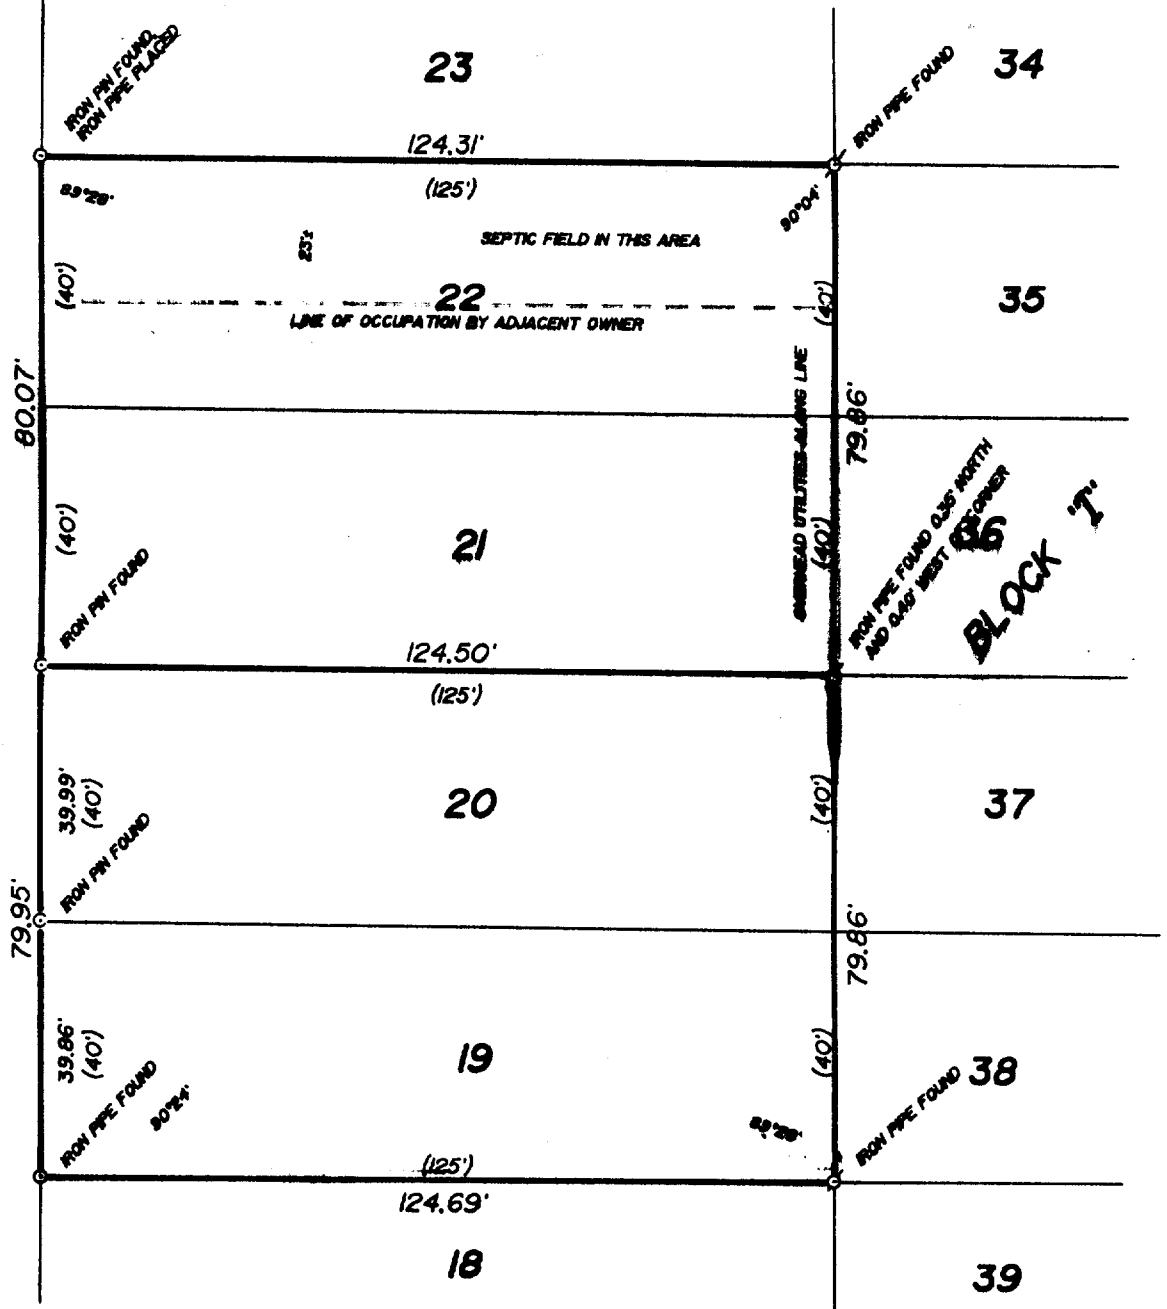

PLAT OF SURVEY OF

LOTS 19-22. BLOCK I OF CISCO BEACH, LOCATED
IN T 1 N, R 17 E, WALWORTH COUNTY, WISCONSIN.

ORDERED BY: MADELINE WAHLGREN
10106 WEST PARKVIEW
PALOS PARK, ILLINOIS
60464

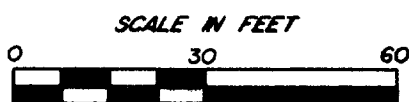

I HEREBY CERTIFY THAT I HAVE SURVEYED THE ABOVE DESCRIBED PROPERTY AND THAT THE ABOVE MAP IS A TRUE REPRESENTATION THEREOF AND SHOWS THE SIZE AND LOCATION OF THE PROPERTY, ITS EXTERIOR BOUNDARIES, THE LOCATION OF ALL VISIBLE STRUCTURES AND DIMENSIONS OF ALL PRINCIPAL BUILDINGS THEREON, BOUNDARY FENCES, APPARENT EASEMENTS AND ROADWAYS AND VISIBLE ENCROACHMENTS, IF ANY, TO THE BEST OF MY KNOWLEDGE AND BELIEF.

THIS SURVEY IS MADE FOR THE USE OF THE PRESENT OWNERS OF THE PROPERTY AND ALSO THESE OWNERS PURCHASE, WARRANT OR GUARANTEE THE TITLE THEREIN WITHIN ONE (1) YEAR FROM DATE HEREOF.

Robert M. Bannard
ROBERT M. BANNARD
WISCONSIN REGISTERED LAND SURVEYOR 5-1888

DATE *Oct. 18, 1989*
JOB NO. 2047

NOTE: THIS IS NOT A GUARANTEED COPY UNLESS SEALED