




SCALE 1"=30'
● = CONCR. MONUMENT

SHORE VIEW DRIVE

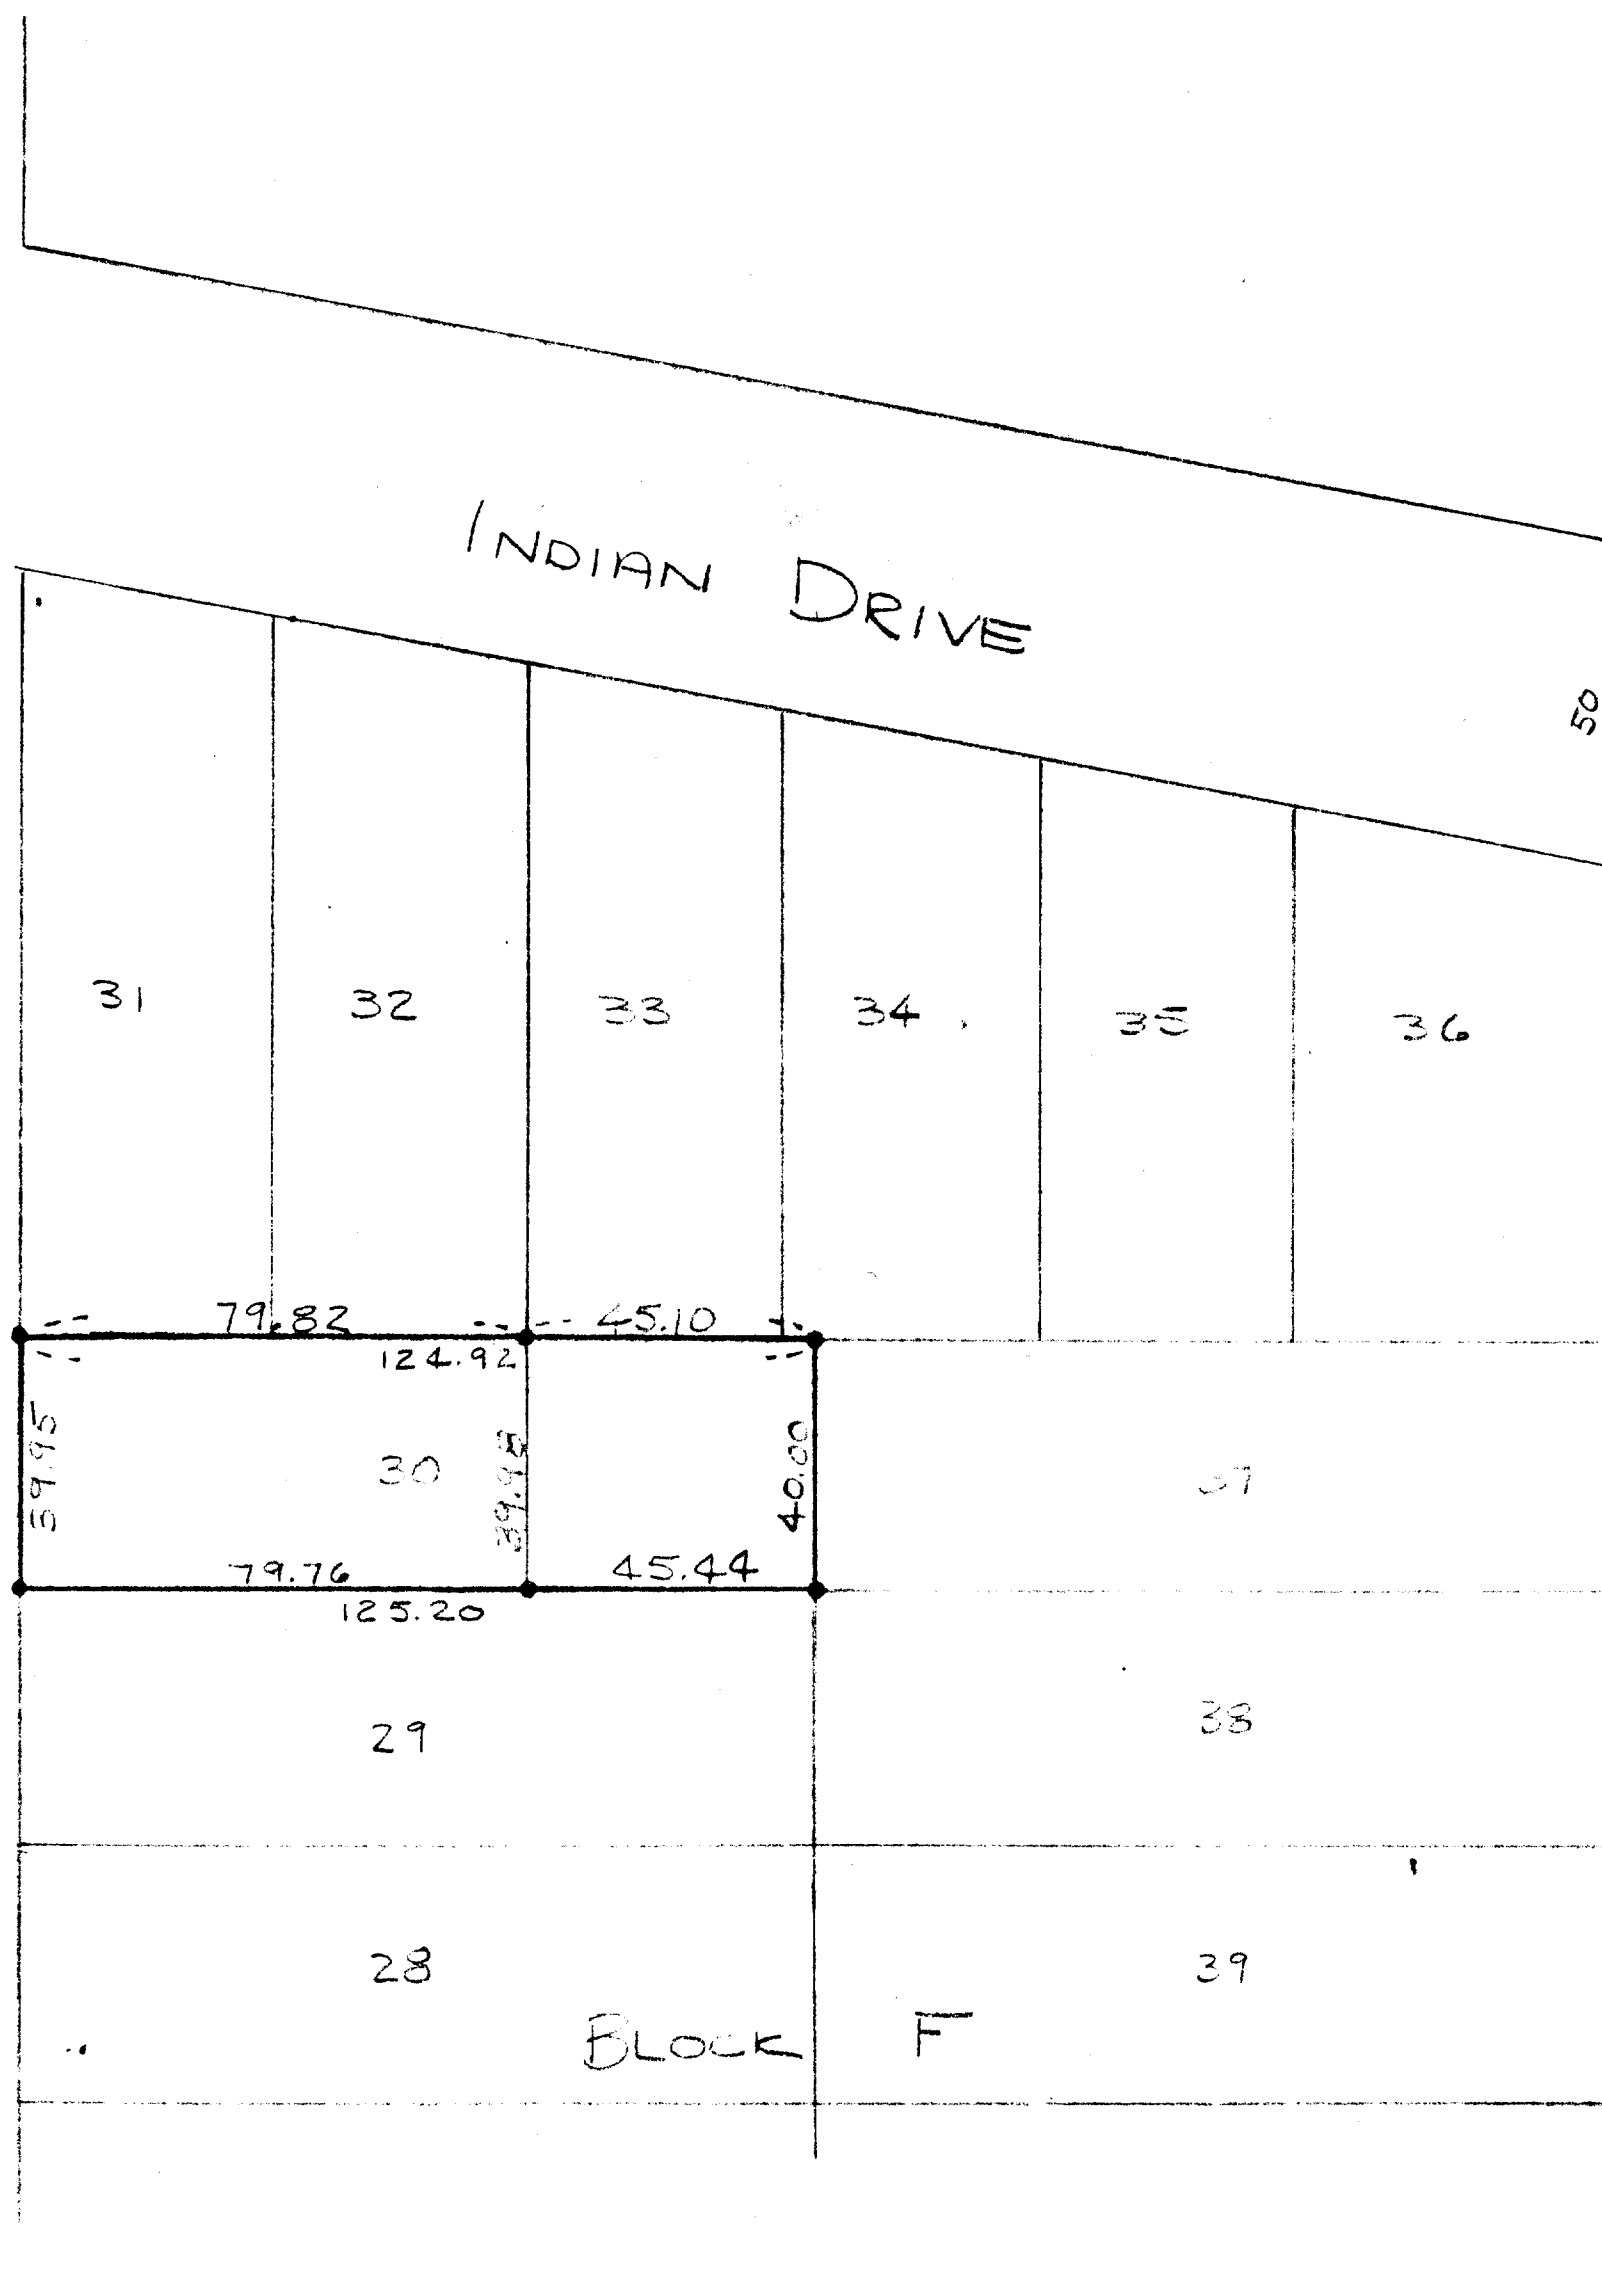

GREENLEAF DRIVE

PLAT OF SURVEY OF LOT 30 OF
BLOCK F OF CISCO BEACH, LOCATED
IN SECTION 5, T14N R17E, WALWORTH
COUNTY, WISCONSIN.

JULY, 1950

Lloyd L. Jensen
COUNTY SURVEYOR