



WALWORTH COUNTY
SURVEYING & MAPPING
LAKE GENEVA, WISCONSIN

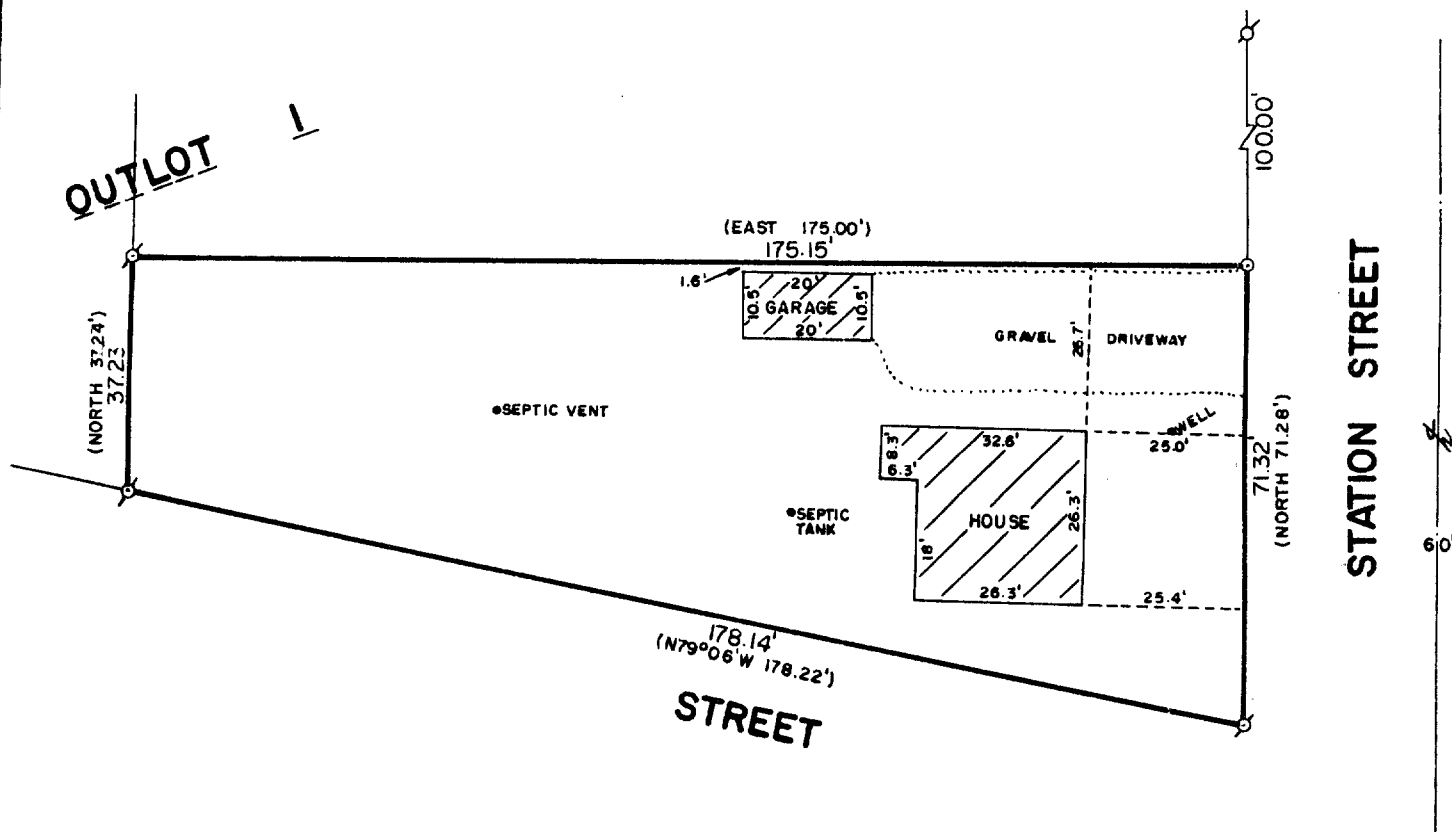

PLAT OF SURVEY OF

A PART OF OUTLOT 1 OF THE VILLAGE OF ZENDA, A
SUBDIVISION LOCATED IN THE SOUTHEAST 1/4 OF
SECTION 28, T 1 N, R 17 E, WALWORTH COUNTY,
WISCONSIN, DESCRIBED AS FOLLOWS: BEGINNING
AT THE SOUTHEAST CORNER OF SAID OUTLOT 1,
THENCE N79°06'W 178.22 FEET; THENCE NORTH
37.24 FEET; THENCE EAST 175.00 FEET; THENCE
SOUTH 71.28 FEET TO THE PLACE OF BEGINNING,
CONTAINING 0.22 ACRES OF LAND.

ORDERED BY: MIKRUT REALTY
RT. 5, BOX 453
LAKE GENEVA, WISCONSIN
53147

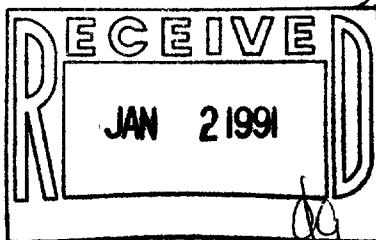

SCALE: 1"=30'

x - IRON PIPE FOUND
o - IRON ROD PLACED
() - RECORDED AS

I HEREBY CERTIFY THAT I HAVE SURVEYED THE ABOVE DESCRIBED PROPERTY AND THAT THE ABOVE
MAP IS A TRUE REPRESENTATION THEREOF AND SHOWS THE SIZE AND LOCATION OF THE PROPERTY,
ITS EXTERIOR BOUNDARIES, THE LOCATION OF ALL VISIBLE STRUCTURES AND DIMENSIONS OF ALL
PRINCIPAL BUILDINGS THEREON, BOUNDARY FENCES, APPARENT EASEMENTS AND ROADWAYS AND
VISIBLE ENCROACHMENTS, IF ANY.

THIS SURVEY IS MADE FOR THE EXCLUSIVE USE OF THE PRESENT OWNERS OF THE PROPERTY, AND
ALSO THOSE WHO PURCHASE, MORTGAGE, OR GUARANTEE THE TITLE THERETO WITHIN ONE (1) YEAR
FROM DATE HEREOF.

Robert M. Baerenwald
ROBERT M. BAERENWALD
WISCONSIN REGISTERED LAND SURVEYOR, S-1508

DATE *Jan. 15, 1989*
JOB NO. 1822

NOTE: THIS IS NOT A CERTIFIED COPY UNLESS SEALED.

Survey # 117-1033

TAX KEY # IZ 00031