



WALWORTH COUNTY
SURVEYING & MAPPING
727 HENRY STREET
LAKE GENEVA, WISCONSIN
414-248-0505

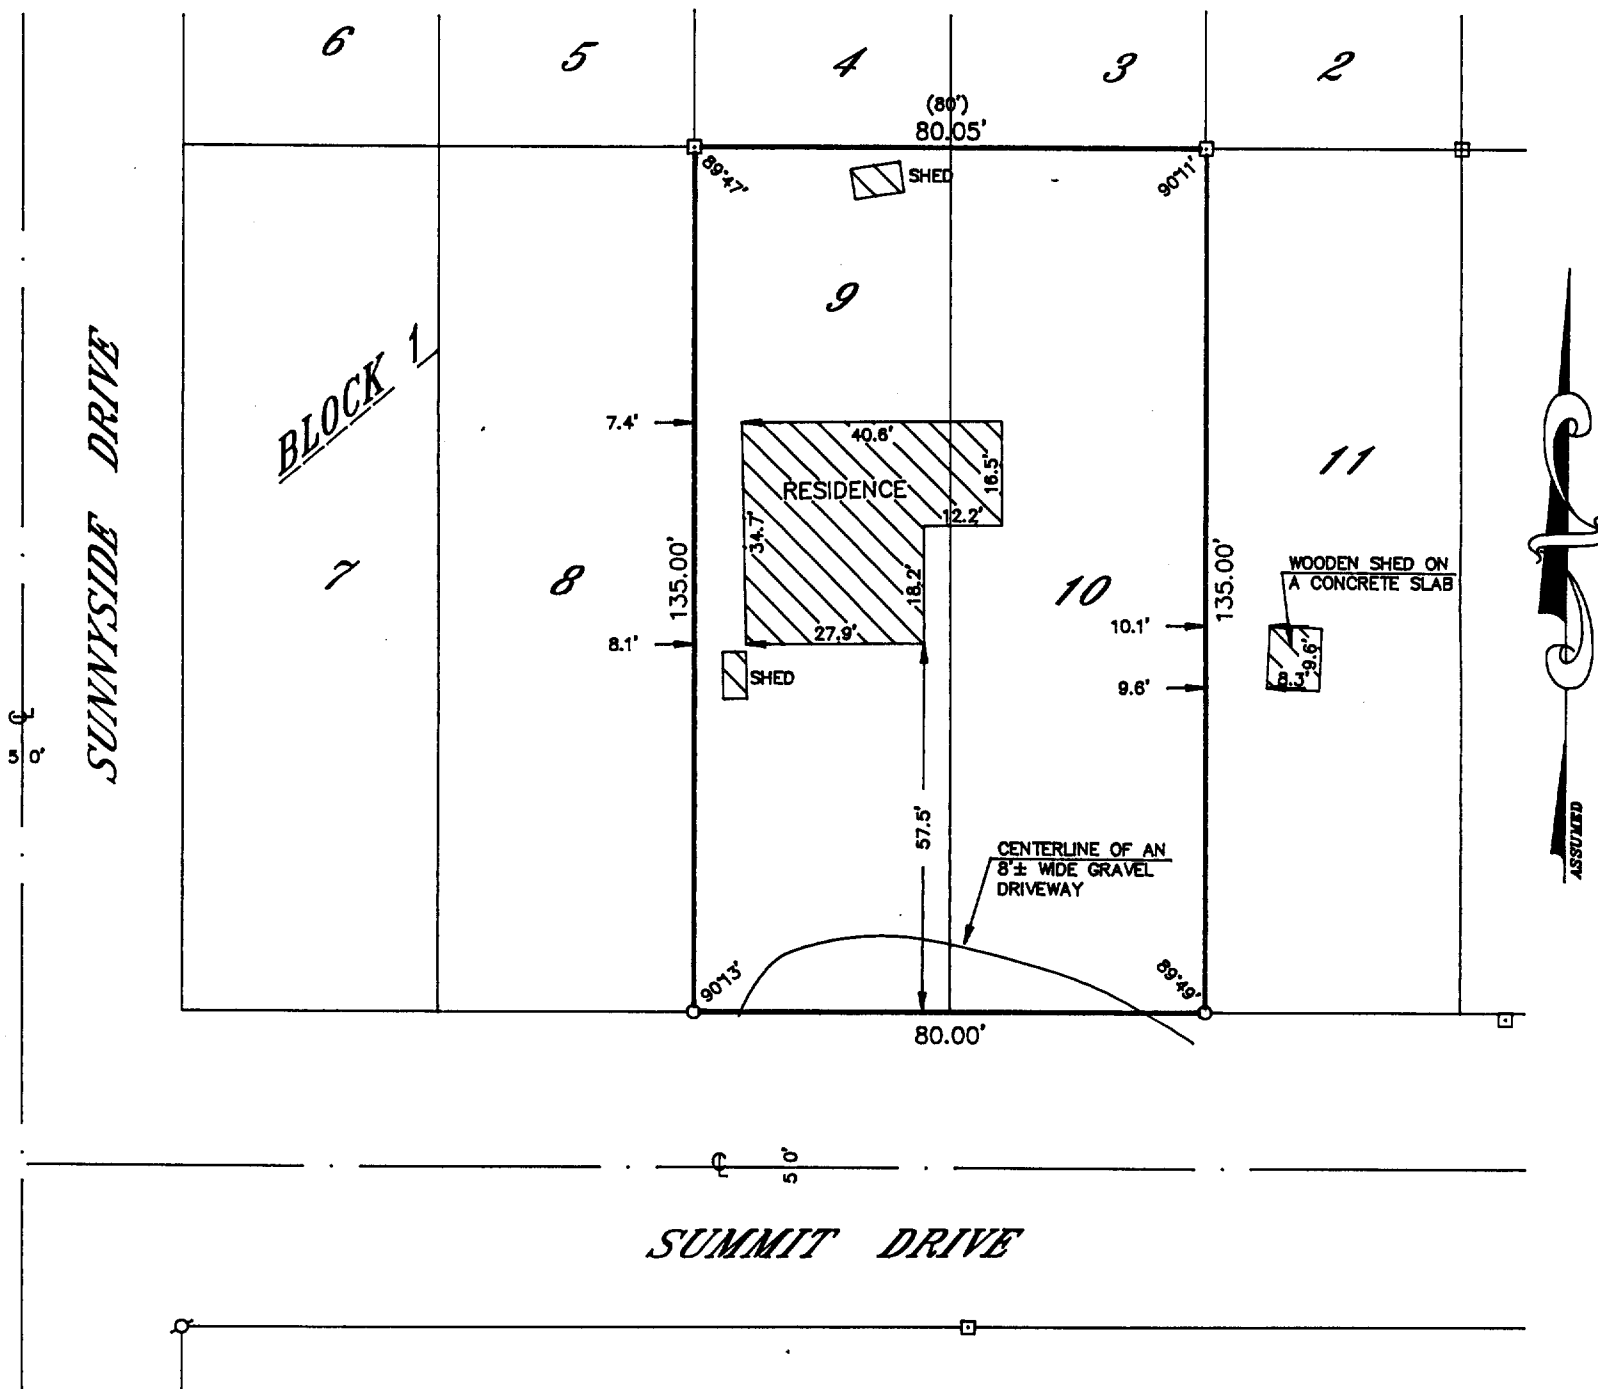

PLAT OF SURVEY OF

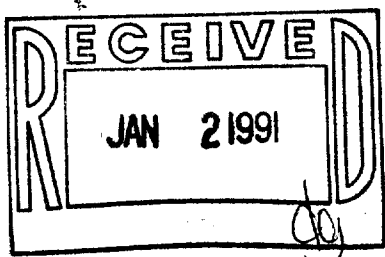

LOTS NINE (9) AND TEN (10) IN BLOCK ONE (1) IN THE
SUBDIVISION KNOWN AS MAPLE HILLS A, TOWN OF LINN,
SITUATED IN SECTION 18, TOWN ONE NORTH, RANGE 17
EAST, WALWORTH COUNTY, WISCONSIN.

ORDERED BY: ROBERT A. ARMSTRONG, JR., LTD. INC.
1605 COLONIAL PARKWAY-SUITE 2B
IVERNESS, ILLINOIS 60067

GRAPHIC SCALE



(IN FEET)

1 inch = 30 ft.

- ⊙ - IRON PIPE FOUND
- - IRON PIPE PLACED
- () - RECORDED AS
- - IRON BAR FOUND

I HEREBY CERTIFY THAT I HAVE SURVEYED THE ABOVE DESCRIBED
PROPERTY AND THAT THE ABOVE MAP IS A TRUE REPRESENTATION
THEREOF AND SHOWS THE SIZE AND LOCATION OF THE PROPERTY,
ITS EXTERIOR BOUNDARIES, THE LOCATION OF ALL VISIBLE STRUCTURES
AND DIMENSIONS OF ALL PRINCIPAL BUILDINGS THEREON, BOUNDARY
FENCES, APPARENT EASEMENTS, ROADWAYS AND VISIBLE ENCROACH-
MENTS, IF ANY, TO THE BEST OF MY KNOWLEDGE AND BELIEF.

THIS SURVEY IS MADE FOR THE USE OF THE PRESENT OWNERS OF
THE PROPERTY AND ALSO THOSE WHO PURCHASE, MORTGAGE OR
GUARANTEE THE TITLE THERETO WITHIN ONE (1) YEAR FROM DATE
HEREOF.

Robert M. Baerenwald
ROBERT M. BAERENWALD
WISCONSIN REGISTERED LAND SURVEYOR, S-1508

DATE *June 29, 1990*
JOB NO. 2559

NOTE: THIS IS NOT A CERTIFIED COPY UNLESS SEALED.

117-1041

IMH 00009