



WALWORTH COUNTY
SURVEYING & MAPPING
727 HENRY STREET
LAKE GENEVA, WISCONSIN
414-248-0505

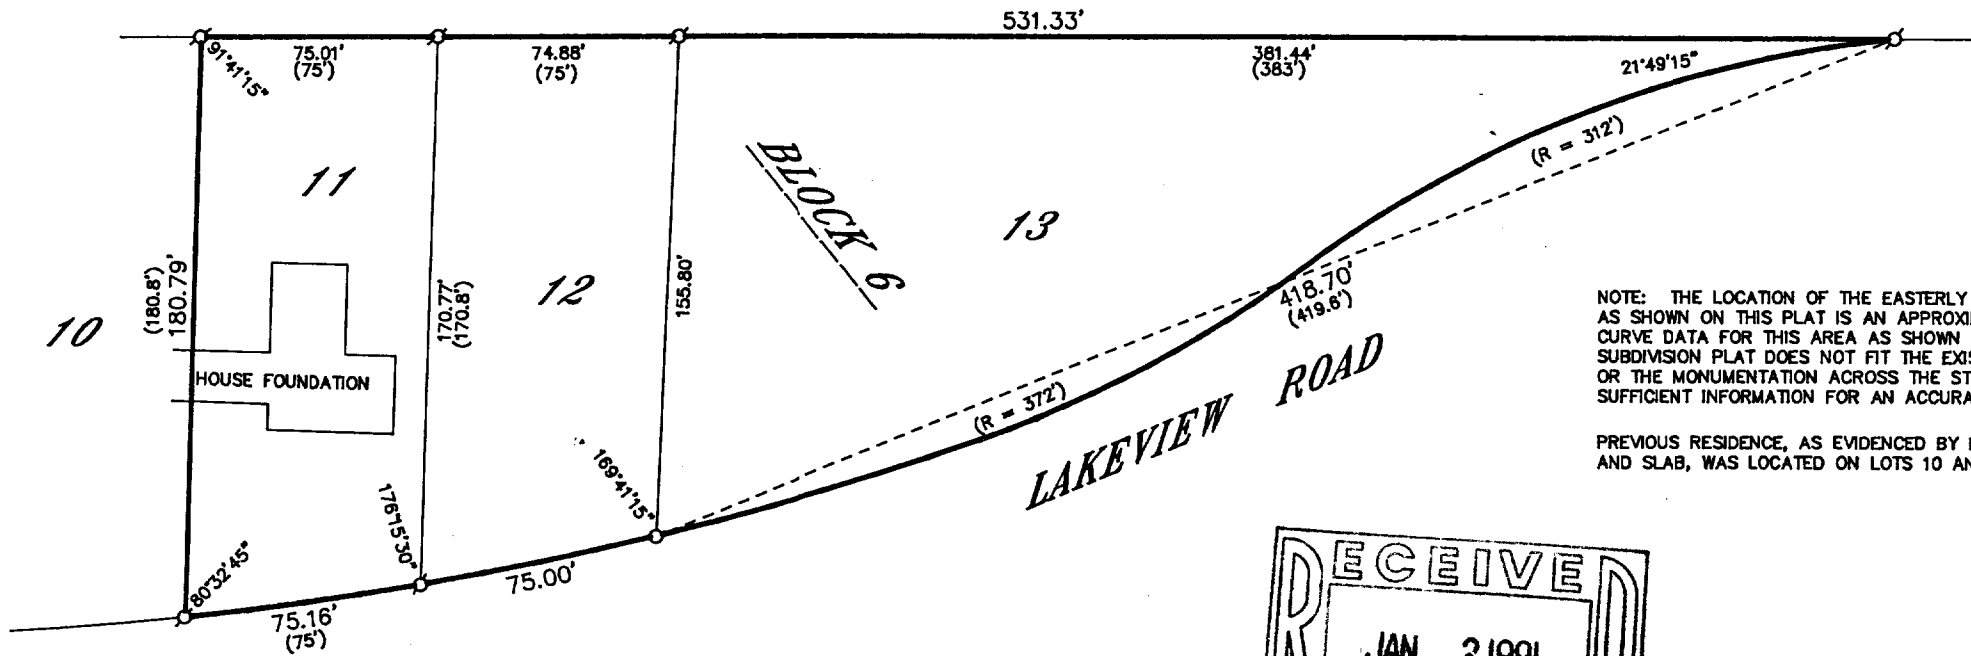

NOTE: THE LOCATION OF THE EASTERLY LINE OF LOT 13 AS SHOWN ON THIS PLAT IS AN APPROXIMATION ONLY. THE CURVE DATA FOR THIS AREA AS SHOWN ON THE RECORDED SUBDIVISION PLAT DOES NOT FIT THE EXISTING PAVEMENT OR THE MONUMENTATION ACROSS THE STREET AND LACKS SUFFICIENT INFORMATION FOR AN ACCURATE RETRACEMENT.

PREVIOUS RESIDENCE, AS EVIDENCED BY EXISTING FOUNDATION AND SLAB, WAS LOCATED ON LOTS 10 AND 11.

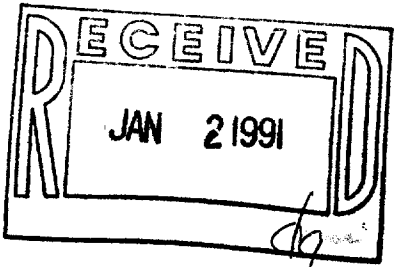

GRAPHIC SCALE



(IN FEET)
1 inch = 60 ft.

LEGEND

- ⊕ - IRON PIPE FOUND
- - IRON PIPE PLACED
- () - RECORDED AS

PLAT OF SURVEY OF

LOTS 11, 12 AND 13, BLOCK 6 OF WOODDALE ADDITION, LOCATED IN T 1 N, R 17 E, WALWORTH COUNTY, WISCONSIN.

ORDERED BY: COLDWELL BANKER
GENEVA LAKES AREA REALTORS
838 MAIN STREET
LAKE GENEVA, WISCONSIN
53147

I HEREBY CERTIFY THAT I HAVE SURVEYED THE ABOVE DESCRIBED PROPERTY AND THAT THE ABOVE MAP IS A TRUE REPRESENTATION THEREOF AND SHOWS THE SIZE AND LOCATION OF THE PROPERTY, ITS EXTERIOR BOUNDARIES, THE LOCATION OF ALL VISIBLE STRUCTURES AND DIMENSIONS OF ALL PRINCIPAL BUILDINGS THEREON, BOUNDARY FENCES, APPARENT EASEMENTS, ROADWAYS AND VISIBLE ENCROACHMENTS, IF ANY, TO THE BEST OF MY KNOWLEDGE AND BELIEF.

THIS SURVEY IS MADE FOR THE USE OF THE PRESENT OWNERS OF THE PROPERTY AND ALSO THOSE WHO PURCHASE, MORTGAGE OR GUARANTEE THE TITLE THERETO WITHIN ONE (1) YEAR FROM DATE HEREOF.

Robert M. Baerenwald
ROBERT M. BAERENWALD
WISCONSIN REGISTERED LAND SURVEYOR, S-1508

April 15, 1990
DATE JOB NO. 2437

NOTE: THIS IS NOT A CERTIFIED COPY UNLESS SEALED.

117-1046

IW 000 SSA
IW 000 SS B