
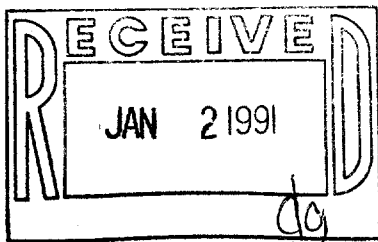


GENEVA LAKE

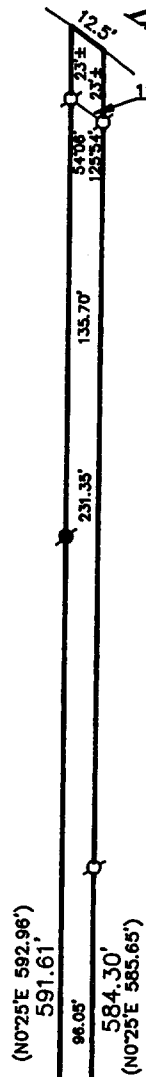

DETAIL SCALE
1" = 30'

Block 3

CONCRETE SLAB

RESIDENCE

DRIVEWAY

Curve Data:

- $R=51'$
- $CH=57.41'$ ($CH=570'21"E\ 57.39'$)
- $CH=53.50'$ ($CH=N43'48"E\ 53.39'$)
- $CH=56.41'$ ($CH=S21'11"E\ 56.41'$)
- $CH=86.00'$ ($CH=S40'38"E\ 86.20'$)
- $CH=101.46'$ ($CH=N14'28"E\ 59.69'$)
- $CH=52'28"E\ 44.32'$ ($CH=39.69'$)

Distances and Bearings:

- $27.1'$
- $8.47'$ ($S40'29"E$)
- $36.93'$ ($S84'04"E\ 36.59'$)
- $26.6'$
- $26.1'$
- $13.1'$
- $32.9'$
- $13.1'$
- $26.3'$
- $31.9'$
- $26.8'$
- $27'$
- $28'$
- $13.7'$
- $36.9'$
- $13.1'$
- $26.1'$
- $6.6'$
- $6.6'$
- $7.7'$
- $27.1'$

Radius Data:

- $R=112'$
- $R=320'$

BLOCK 3, TRINKE ESTATES, ALSO THE ENTIRE WESTERN 12'3" STRIP
WEST OF LOT 1, BLOCK 1, TRINKE ESTATES, T 1 N, R 17 E, WALWORTH
COUNTY.

- I HEREBY CERTIFY THAT I HAVE SURVEYED THE ABOVE DESCRIBED PROPERTY AND THAT THE ABOVE MAP IS A TRUE REPRESENTATION THEREOF AND SHOWS THE SIZE AND LOCATION OF THE PROPERTY, ITS EXTERIOR BOUNDARIES, THE LOCATION OF ALL VISIBLE STRUCTURES AND DIMENSIONS OF ALL PRINCIPAL BUILDINGS THEREON, BOUNDARY FENCES, APPARENT EASEMENTS, ROADWAYS AND VISIBLE ENCROACHMENTS, IF ANY, TO THE BEST OF MY KNOWLEDGE AND BELIEF.

THIS SURVEY IS MADE FOR THE USE OF THE PRESENT OWNERS OF THE PROPERTY AND ALSO THOSE WHO PURCHASE, MORTGAGE OR GUARANTEE THE TITLE THERETO WITHIN ONE (1) YEAR FROM DATE HEREOF.

Robert M. Baerenwald
ROBERT M. BAERENWALD
WISCONSIN REGISTERED LAND SURVEYOR, S-1508

DATE June 19, 1990 JOB NO. 1611

NOTE: THIS IS NOT A CERTIFIED COPY UNLESS SEALED.