


WALWORTH COUNTY
SURVEYING & MAPPING
LAKE GENEVA, WISCONSIN

GENEVA LAKE

PLAT OF SURVEY OF

LOT 1 OF CERTIFIED SURVEY MAP NO. 1450,
TOWN OF LINN, WALWORTH COUNTY, WISCONSIN,
ACCORDING TO THE RECORDED PLAT THEREOF IN
VOLUME 6 OF CERTIFIED SURVEYS ON PAGE 354
AS DOCUMENT NO. 122117.

ORDERED BY: COLDWELL BANKER
GENEVA LAKES AREA REALTORS
838 MAIN STREET
LAKE GENEVA, WISCONSIN
53147

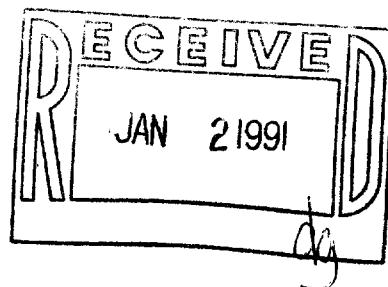

SCALE: 1"=60'

♂ - IRON PIPE FOUND
● - CONCRETE MONUMENT FOUND

I HEREBY CERTIFY THAT I HAVE SURVEYED THE ABOVE DESCRIBED PROPERTY AND THAT THE ABOVE
MAP IS A TRUE REPRESENTATION THEREOF AND SHOWS THE SIZE AND LOCATION OF THE PROPERTY,
ITS EXTERIOR BOUNDARIES, THE LOCATION OF ALL VISIBLE STRUCTURES AND DIMENSIONS OF ALL
PRINCIPAL BUILDINGS THEREON, BOUNDARY FENCES, APPARENT EASEMENTS AND ROADWAYS AND
VISIBLE ENCROACHMENTS, IF ANY.

THIS SURVEY IS MADE FOR THE EXCLUSIVE USE OF THE PRESENT OWNERS OF THE PROPERTY, AND
ALSO THOSE WHO PURCHASE, MORTGAGE, OR GUARANTEE THE TITLE THERETO WITHIN ONE (1) YEAR
FROM DATE HEREOF.

Robert M. Baerenwald
ROBERT M. BAERENWALD
WISCONSIN REGISTERED LAND SURVEYOR, S-1508

DATE *Aug. 3, 1989* JOB NO. 2099


NOTE: THIS IS NOT A CERTIFIED COPY UNLESS SEALED.

LOT 3, C. S. M. NO. 1381

LOT 1
69,047 SQ. FT.

LORAMOOR
DRIVE

LOT 2

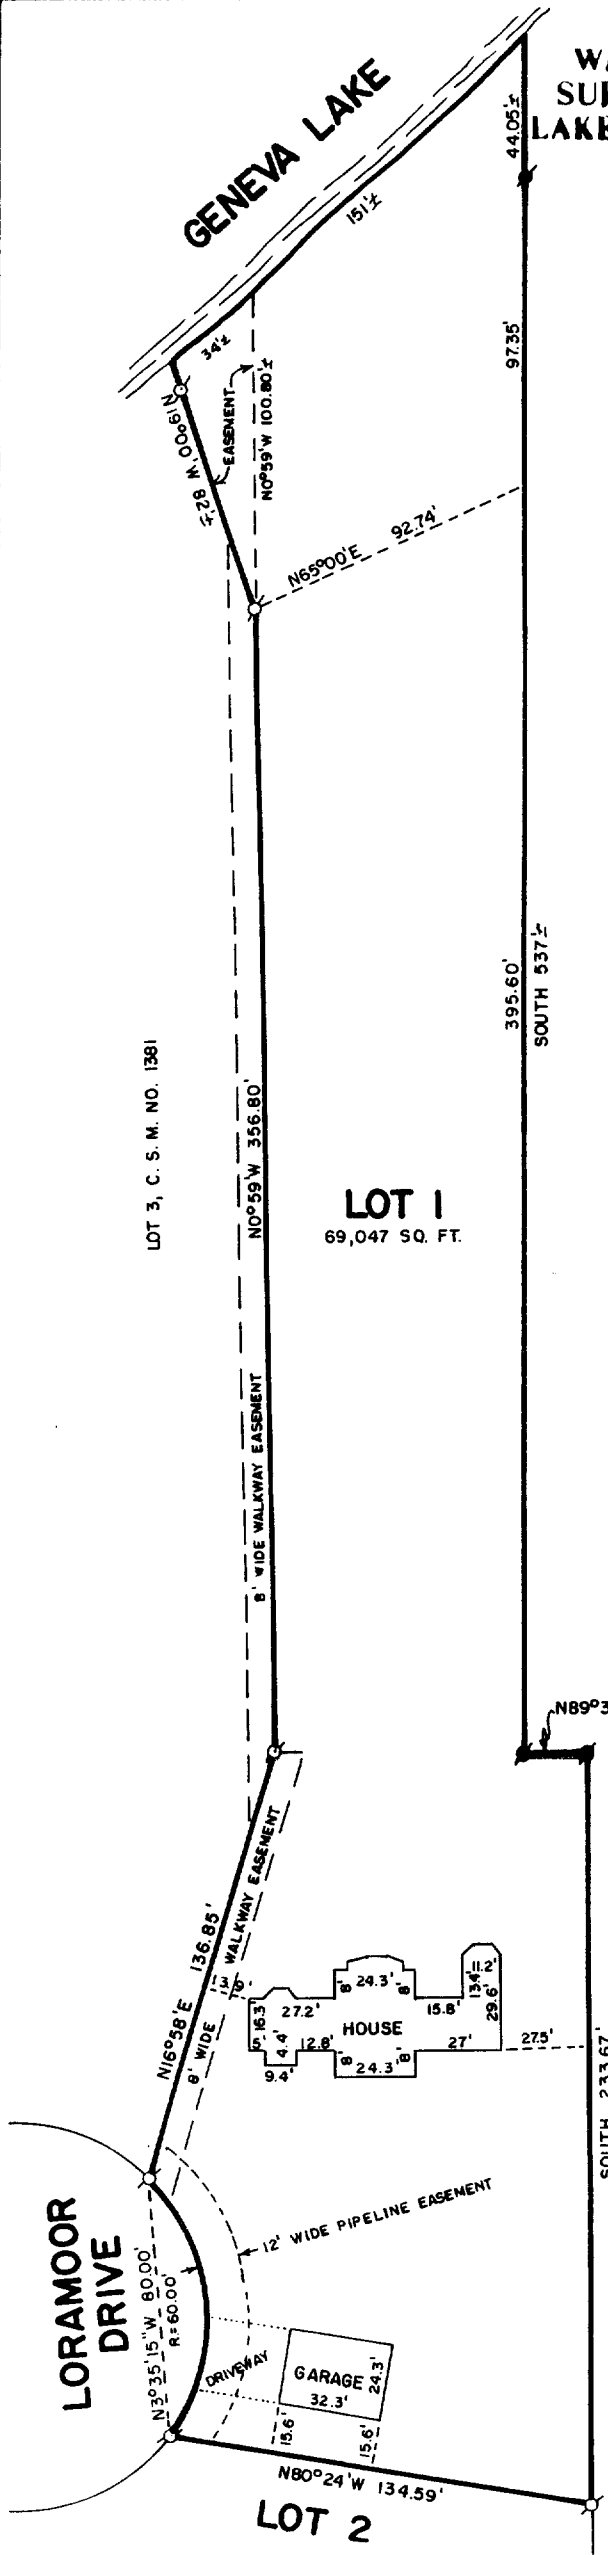

117-1050

TA 14500001