

GENEVA
LAKE

ONE FOOT CONTOURS & TREE LOCATION

ON LOT 2 OF C.S.M. NO 1906 AND
ADJOINING LOT LINE ADJUSTMENT
LOCATED IN THE NW 1/4 OF THE NW 1/4 OF
SECTION 17, T1N, R17E, TOWN OF LINN,
WALWORTH COUNTY, WISCONSIN

ORDERED BY: PETER VANDERVELD
790 S. LAKE SHORE DR.
LAKE GENEVA, WI 53147
248-9357



BEARINGS REFERENCED
TO C.S.M. NO. 1906

LOT 2

LOT 1

LOT 3

UNPLATTED
LAND

FIRST FLOOR ELEVATIONS

SHOP-SHED - 874.39
GAME ROOM - 875.75
POOL AREA - 877.80


Copyright © 1990 by Jensen Surveying & Mapping S.C.

All rights reserved. No part of this survey plat may be reproduced or transmitted in any form by any means - graphic, electronic, or mechanical, including photocopying, tracing, or information storage and retrieval systems - without permission in writing from Thomas P.A. Jensen, Jensen Surveying & Mapping S.C.


Note: This survey plat is not certified unless signed and sealed in red ink.

NOTE: PARENTHESES INDICATE RECORDED DIMENSION

I, Thomas P.A. Jensen, Wisconsin Registered Land Surveyor, do hereby certify that this survey was performed by me, or under my direction, in full compliance with the owner's agent's instructions and Chapter H-E 7 of the Wisconsin Administrative Code "Minimum Standards For Property Surveys"; and that this map is an accurate representation thereof to the best of my knowledge and belief.

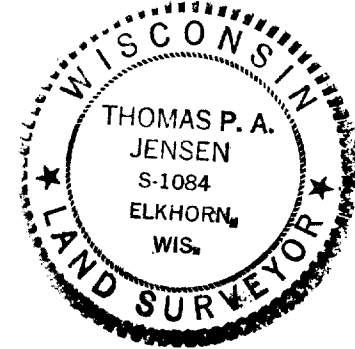

Thomas P.A. Jensen R.L.S-1084
Jensen Surveying & Mapping S.C.

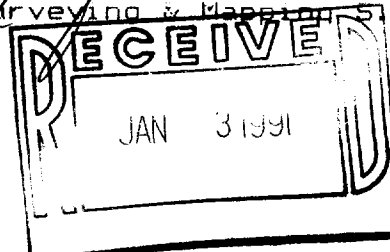

1990 .002

Sheet no. 1 of 1 sheets.

Job reference number

1990 .002


Legend

- FOUND CONCRETE MONUMENT
- FOUND IRON PIPE
- FOUND RAILROAD SPIKE
- DECIDUOUS TREE
- CONIFEROUS TREE
- CONCRETE SURFACE
- BLACKTOP SURFACE

JENSEN SURVEYING & MAPPING S.C.
45 South Wisconsin Street P.O. Box 322
Elkhorn, Wisconsin 53121
(414) 723-3434



Scale: 1" = 20'

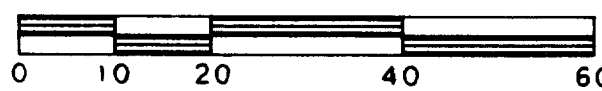

Mapping date: FEB. 1, 1990

Revisions: _____

117-1066

JA 201200002