

JENSEN SURVEYING & MAPPING S.C.
45 South Wisconsin Street P.O. Box 382
Elkhorn, Wisconsin 53121
(414) 788-3484



BEARINGS REFERENCED
TO THE NORTH LINE
OF EAST ROADWAY
ASSUMED AS WEST

SCALE: 1" = 30'


LEGEND

• - FOUND IRON PIPE
• - SET 1" x 24" IRON PIPE
() - RECORDED DIMENSION

PLAT OF SURVEY LOTS 1 AND 26, BLOCK 4 OF SUNSET HILLS, A SUBDIVISION LOCATED IN THE NE 1/4 OF THE NW 1/4 AND THE SE 1/4 OF THE NW 1/4 OF SECTION 4, T1N, R17E, WALWORTH COUNTY, WISCONSIN

ORDERED BY: DANIEL CONNELLY
RT. 4 BOX 111A
LAKE GENEVA, WI 53147
(414) 245-6786

MAPPING DATE: AUGUST 29, 1990

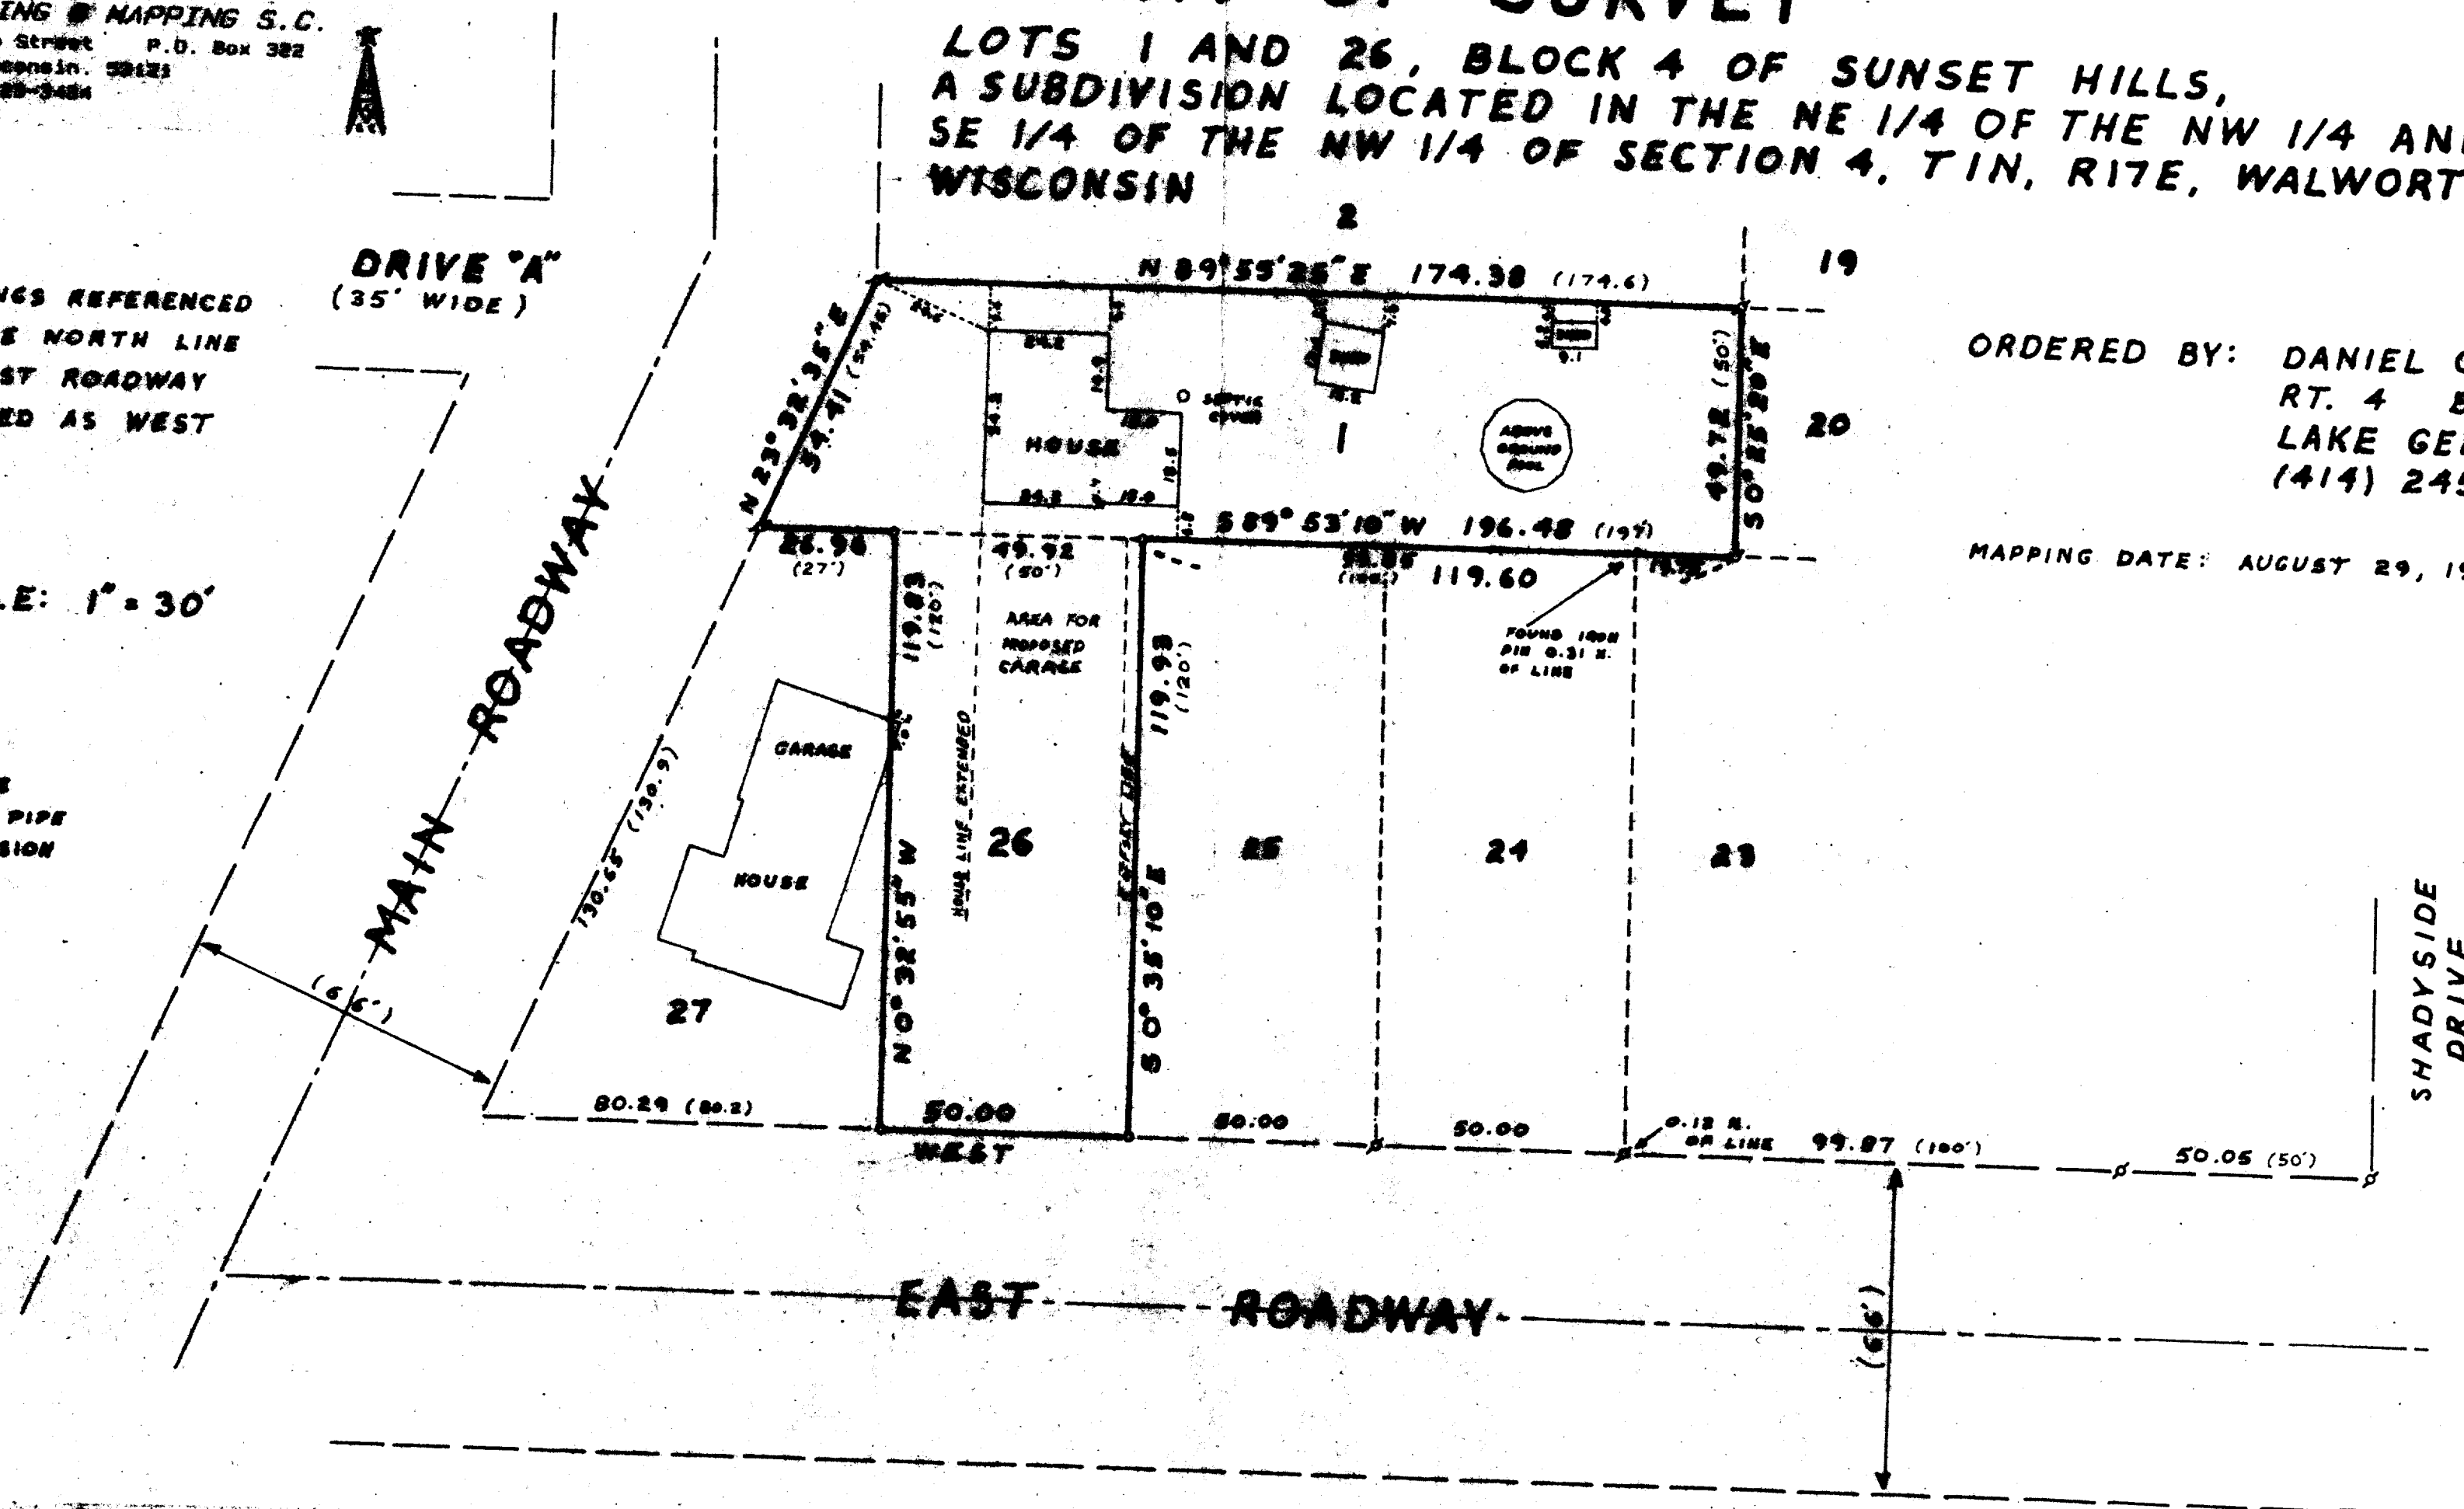


Note: This survey plat is not certified
unless signed and sealed in red ink.

Copyright © 1990 by Jensen Surveying & Mapping S.C.

All rights reserved. No part of this survey plat may be
reproduced or transmitted in any form by any means - graphic,
electronic, or mechanical, including photocopying, tracing, or
information storage and retrieval systems - without permission in
writing from Thomas P.A. Jensen, Jensen Surveying & Mapping S.C.

I, Thomas P.A. Jensen, Wisconsin Registered Land Surveyor,
do hereby certify that this survey was performed by me, or under
my direction, in full compliance with the owner's/agent's instru-
ctions and Chapter A-E 7 of the Wisconsin Administrative Code
"Minimum Standards For Property Surveys"; and that this map is
an accurate representation thereof to the best of my knowledge
and belief.

Thomas P.A. Jensen R.L.S-1084
Jensen Surveying & Mapping S.C.

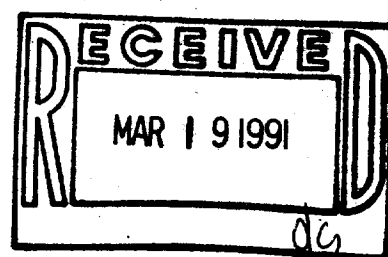

1990.124

117-1069

ISH 00036
ISH 00055