



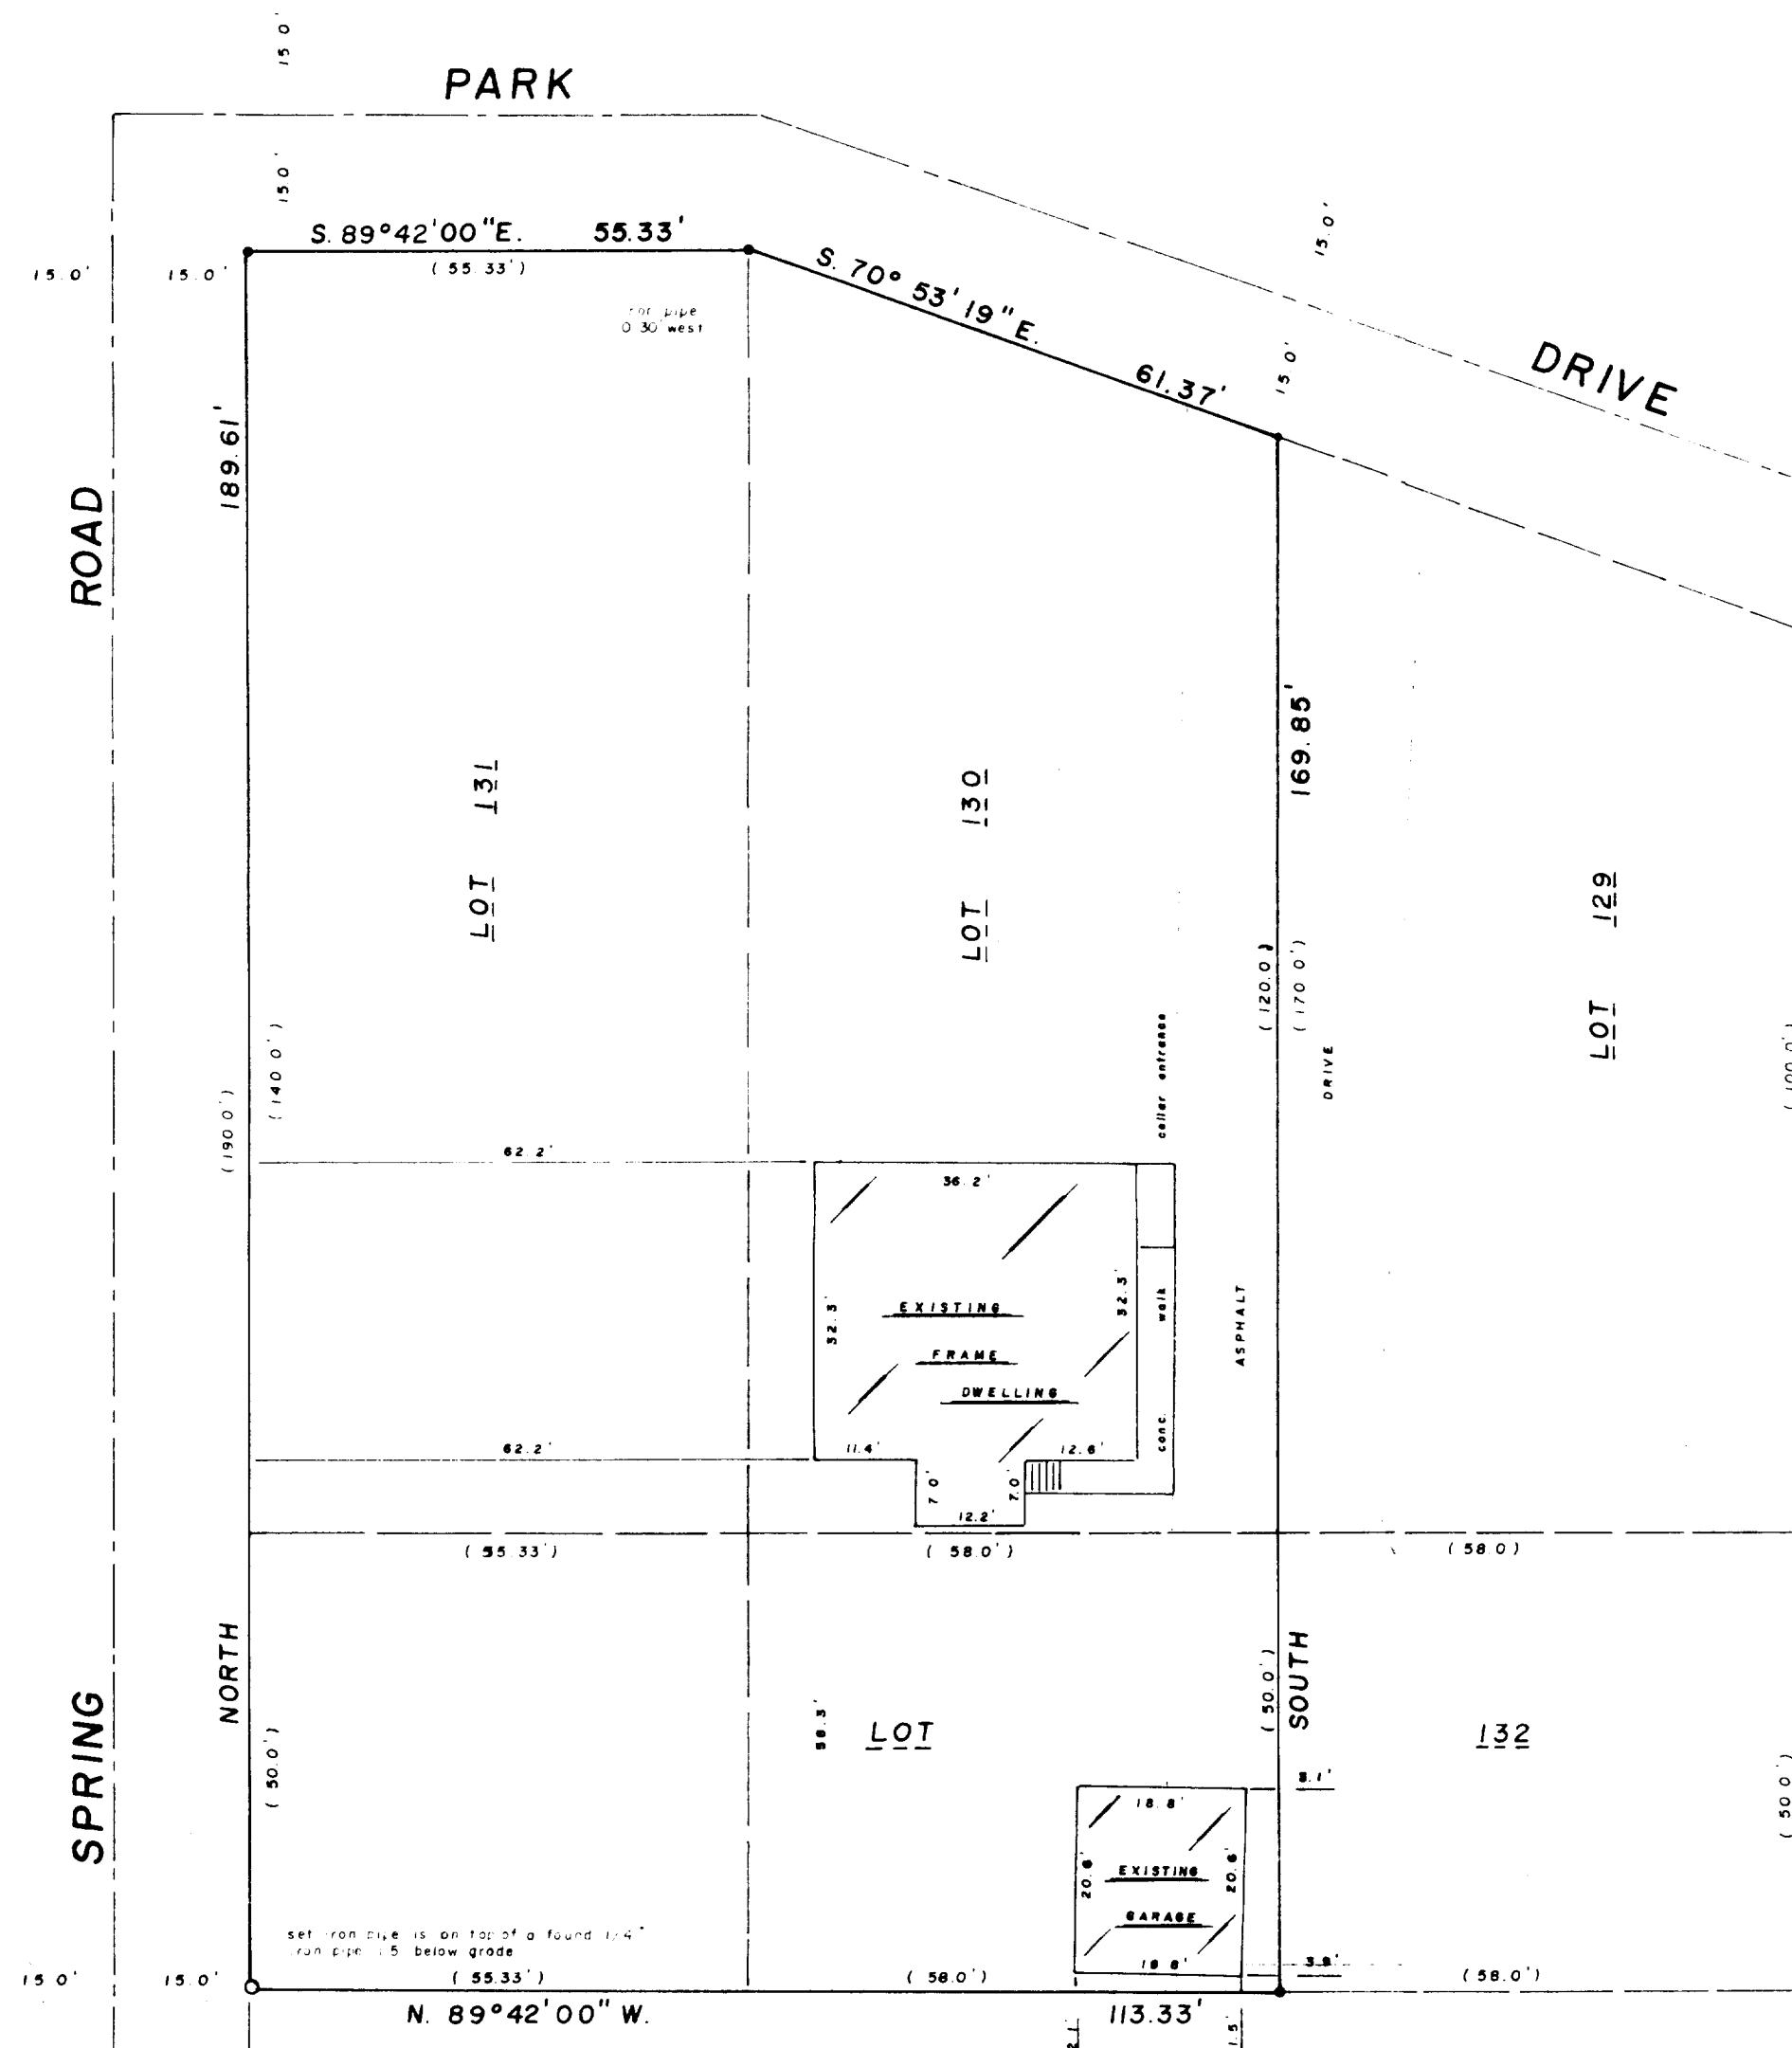

**EXISTING LEGAL DESCRIPTION
AS PER VOLUME 370, PAGE 42**

Lot One Hundred Thirty (130) and that portion of Lot One Hundred Thirty-two (132) lying directly South of Lot One Hundred Thirty (130) and being fifty-eight (58') feet East and West by fifty (50') feet North and South in the subdivision known as "Lake Geneva Beach", which is a portion of Lot Four (4), Section Eleven (11), Township One (1) North, Range Seventeen (17) East, Town of Linn, County of Walworth, State of Wisconsin.

Also: Lot One Hundred Thirty-one (131) and that portion of Lot One Hundred Thirty-two (132) lying directly South of Lot One Hundred Thirty-one (131) and being 55.33 feet East and West by fifty (50') feet North and South in the subdivision known as "Lake Geneva Beach" which is a portion of Lot Four (4), Section Eleven (11), Township One (1) North, Range Seventeen (17) East, Town of Linn, County of Walworth, State of Wisconsin.

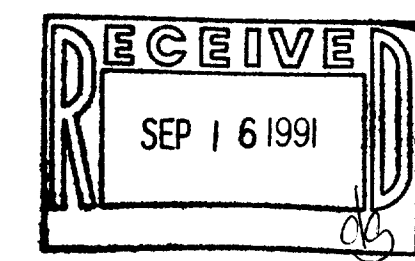

- LEGEND**
- + CHISEL CUT IN CONCRETE
 - PK NAIL
 - FOUND IRON PIPE - 1 1/4"
 - FOUND IRON PIPE - 1 1/2"
 - SET IRON PIPE - 1"
 - FOUND BRASS CAPPED MONUMENT
 - FOUND CONCRETE MONUMENT
 - FENCE
 - () RECORDED AS
 - EXISTING GROUND ELEVATION
 - PROPOSED ELEVATION
 - PROPOSED DRAINAGE PATTERN

"I hereby certify that I have surveyed the above described property and that the above map is a true representation thereof and shows the size and location of the property, its exterior boundaries, the location of all visible structures and dimensions of all principal buildings thereon, boundary fences, apparent easements, roadways and visible encroachments, if any.

"This survey is made for the use of the present owners of the property, and also those who purchase, mortgage, or guarantee the title thereto within one year from date hereof."

NO MONUMENTATION HAS BEEN WAIVED IN ACCORDANCE WITH A-E 701(2) OF THE WISCONSIN ADMINISTRATIVE CODE

Patrick R. Schuster
WISCONSIN REGISTERED LAND SURVEYOR

PLAT OF SURVEY FOR MARILYN POLULACH		
Lot 130 and Lot 131 and part of Lot 132, Lake Geneva Subdivision, situated in Section 11, Township 1 North, Range 17 East, Town of Linn, Walworth County, Wisconsin.		
DATE 9/12/91	Baxter & Woodman of Wisconsin 326 NORTH PINE STREET / BURLINGTON, WI 53105 414/763-7834 FAX: 414/763-2509	JOB NO. 91168
SCALE 1" = 20'		CHECKED
DRAWN prs		SHEET 1 OF 1
REVISED		

ILCB 00118
ILCB 00119