

KOLB LAND CONSULTING, INC.  
LAND SURVEYING SUBDIVIDING LAND PLANNING


929 WILLIAMS STREET LAKE GENEVA, WISCONSIN 53147 414-248-3697



SCALE 1"=50'

LEGEND

- Ø IRON PIPE FOUND
- IRON ROD FOUND
- IRON PIPE SET
- ( ) AS RECORDED

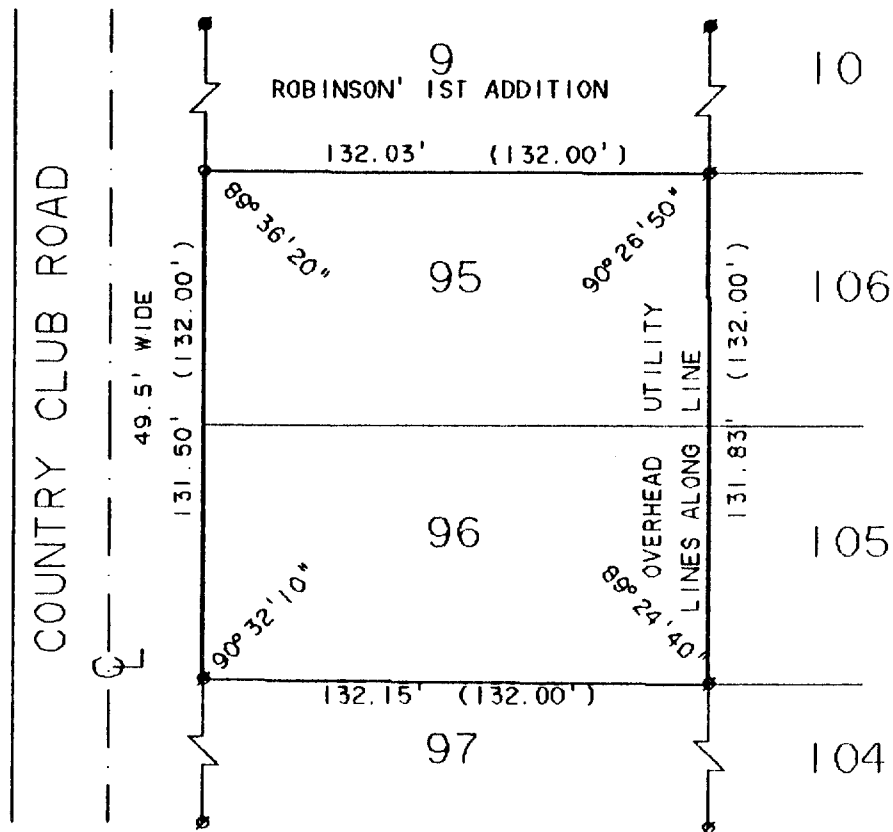


PLAT OF SURVEY OF

LOTS 95 AND 96 OF ROBINSON'S THIRD  
ADDITION LOCATED IN SECTION 14, T 1 N.  
R 17 E, TOWN OF LINN, WALWORTH COUNTY,  
WISCONSIN.

ORDERED BY:  
SAM ARGENTO  
ROUTE 1, BOX 354  
LAKE GENEVA, WI. 53147

I HEREBY CERTIFY THAT I HAVE SURVEYED THE  
ABOVE DESCRIBED PROPERTY AND THAT THE ABOVE  
MAP IS A TRUE REPRESENTATION THEREOF AND  
SHOWS THE SIZE AND LOCATION OF THE PROPERTY,  
ITS EXTERIOR BOUNDARIES, THE LOCATION OF ALL  
VISIBLE STRUCTURES AND DIMENSIONS OF ALL  
PRINCIPAL BUILDINGS THEREON, BOUNDARY FENCES,  
APPARENT EASEMENTS, ROADWAYS AND VISIBLE  
ENCROACHMENTS, IF ANY, TO THE BEST OF MY  
KNOWLEDGE AND BELIEF.  
THIS SURVEY IS MADE FOR THE USE OF THE  
PRESENT OWNERS OF THE PROPERTY AND ALSO  
THOSE WHO PURCHASE, MORTGAGE OR GUARANTEE  
THE TITLE THERETO WITHIN ONE (1) YEAR FROM  
DATE HEREON.

SURVEY IS NOT VALID UNLESS SURVEYOR'S SIGNATURE  
IS IN RED.

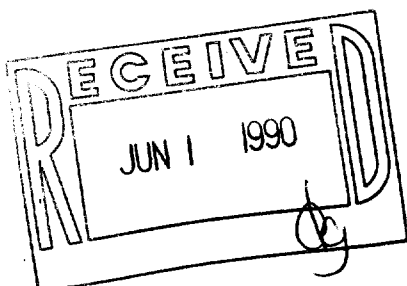

HAROLD H. KOLB  
WISCONSIN REGISTERED LAND SURVEYOR, S-107  
DATE AUG. 24, 1989  
REVISED \_\_\_\_\_  
REVISED \_\_\_\_\_

117-1083

IRB3 00075  
IRB3 00075A