


SCALE 1" = 20'
o = IRON PIPE

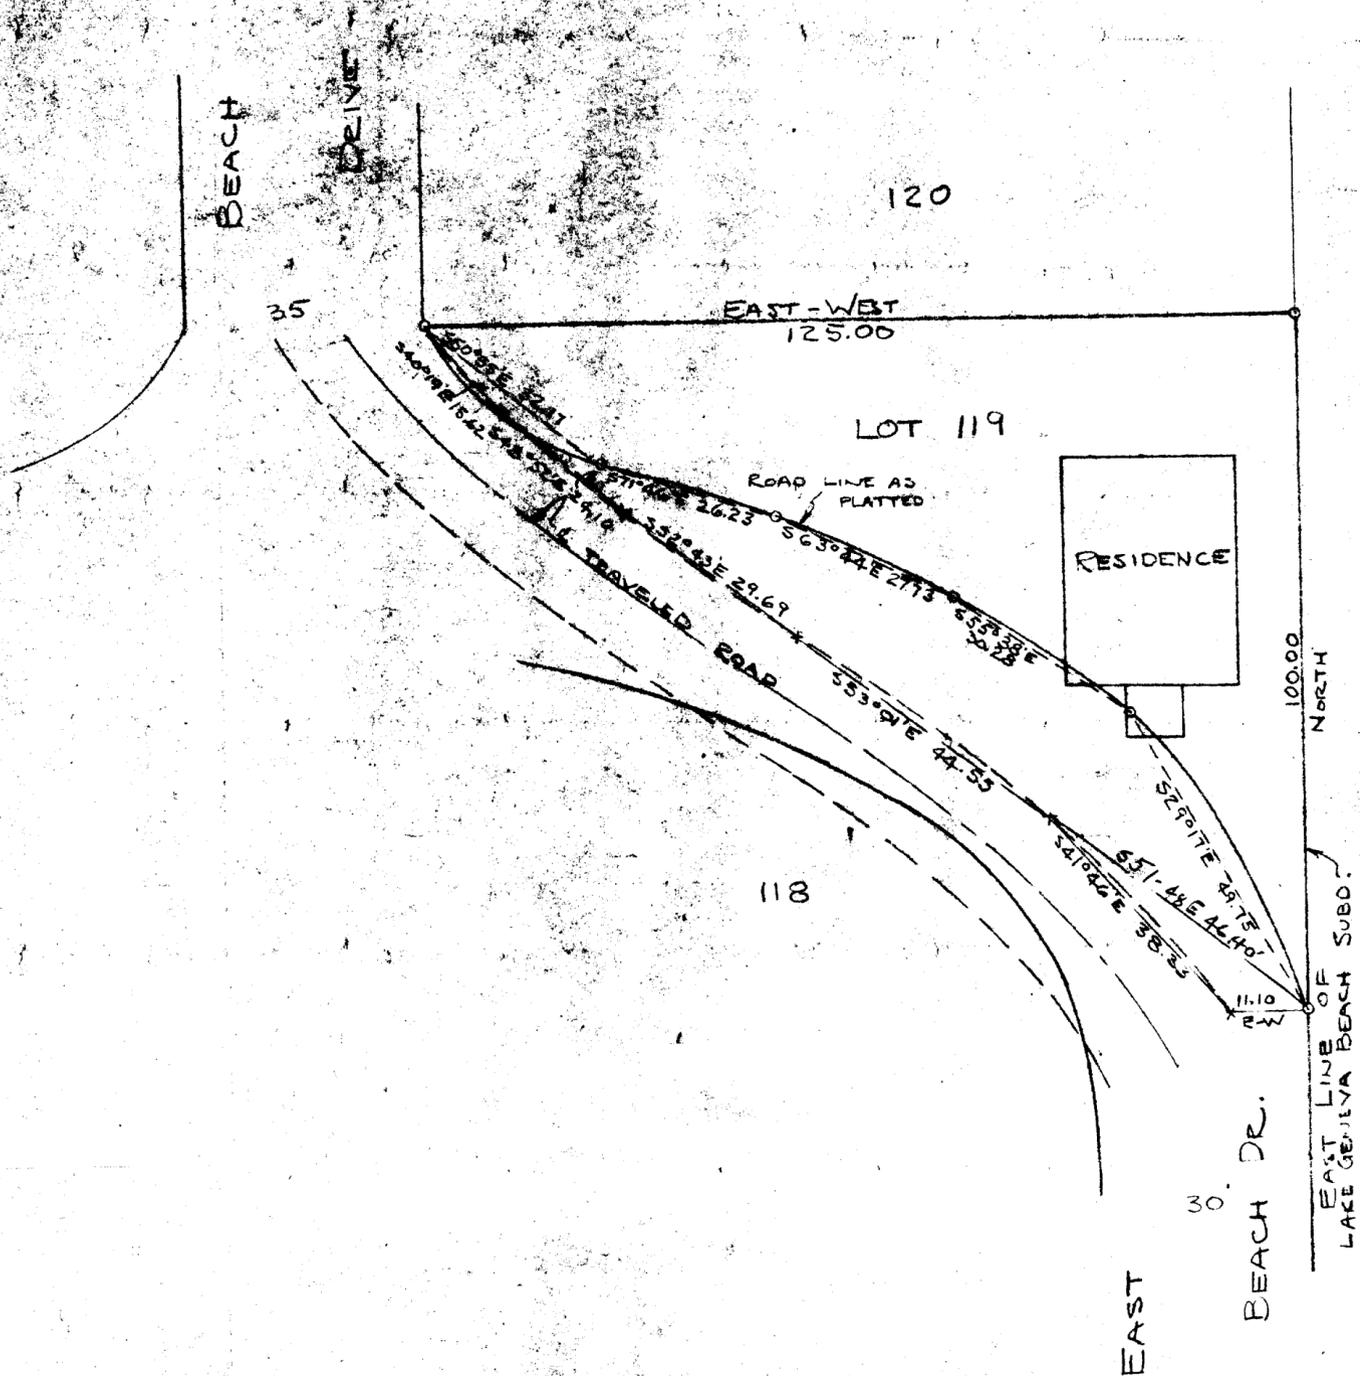

PLAT OF SURVEY OF LOT 119 AND PART OF SUBDIVISION
ROAD TO SOUTHWEST OF LOT, ALL IN LAKE GENEVA
BEACH SUBDIVISION IN TOWN OF WALKWORTH CO., WIS.

MARCH, 1951

Lloyd L. Jensen
COUNTY SURVEYOR

ILGB-109