


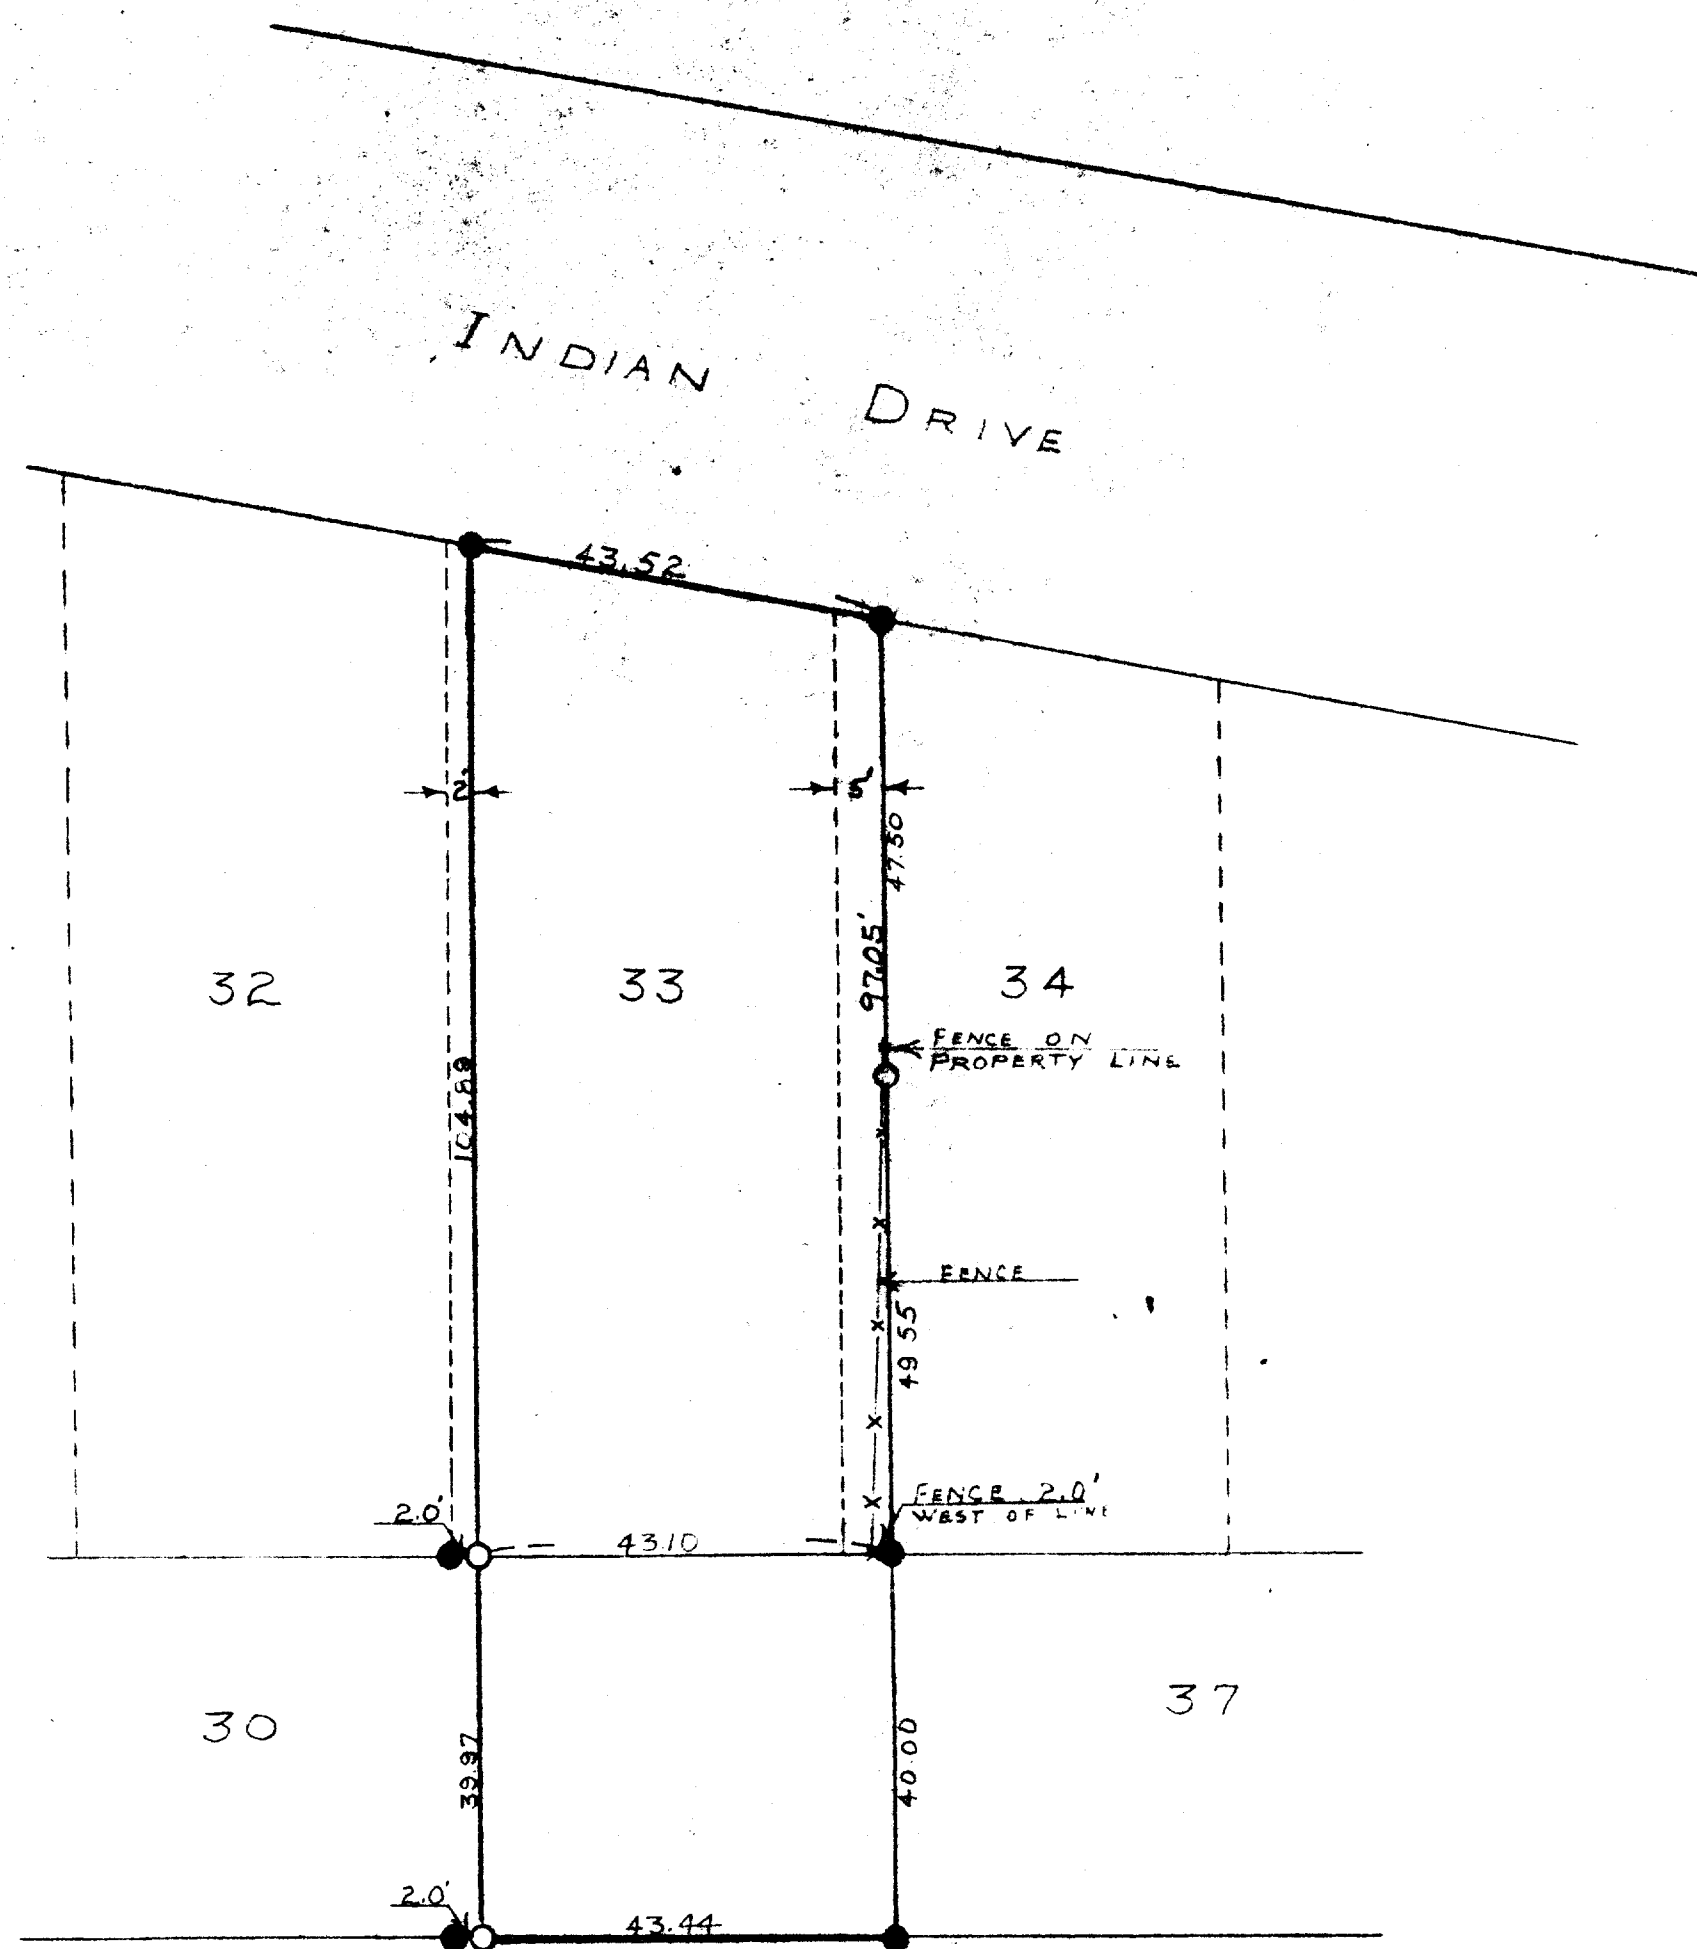

SCALE - 1" = 20'
 ● = CONC. MONUMENT
 ○ = IRON PIPE

PLAT OF SURVEY OF LOT 33 EXCEPT THE WEST 2 FEET; AND THE
 WEST 5 FEET OF LOT 34 IN CISCO BEACH, A SUBDIVISION LOCATED
 IN THE SOUTHEAST 1/4 OF SECTION 5, T19N R17E OF WALWORTH
 COUNTY, WISCONSIN
 SEPT. 1951

Lloyd L. Jensen
 COUNTY SURVEYOR

*Block
 F*

ICI-133