


ABELL
SURVEYING & MAPPING
DELAVER, WISCONSIN 53115
414-728-6737



SCALE 1"=40'

LEGEND

- - IRON PIPE FOUND
- - IRON ROD FOUND
- - CONCRETE MONUMENT FOUND
- △ - UTILITY POLE

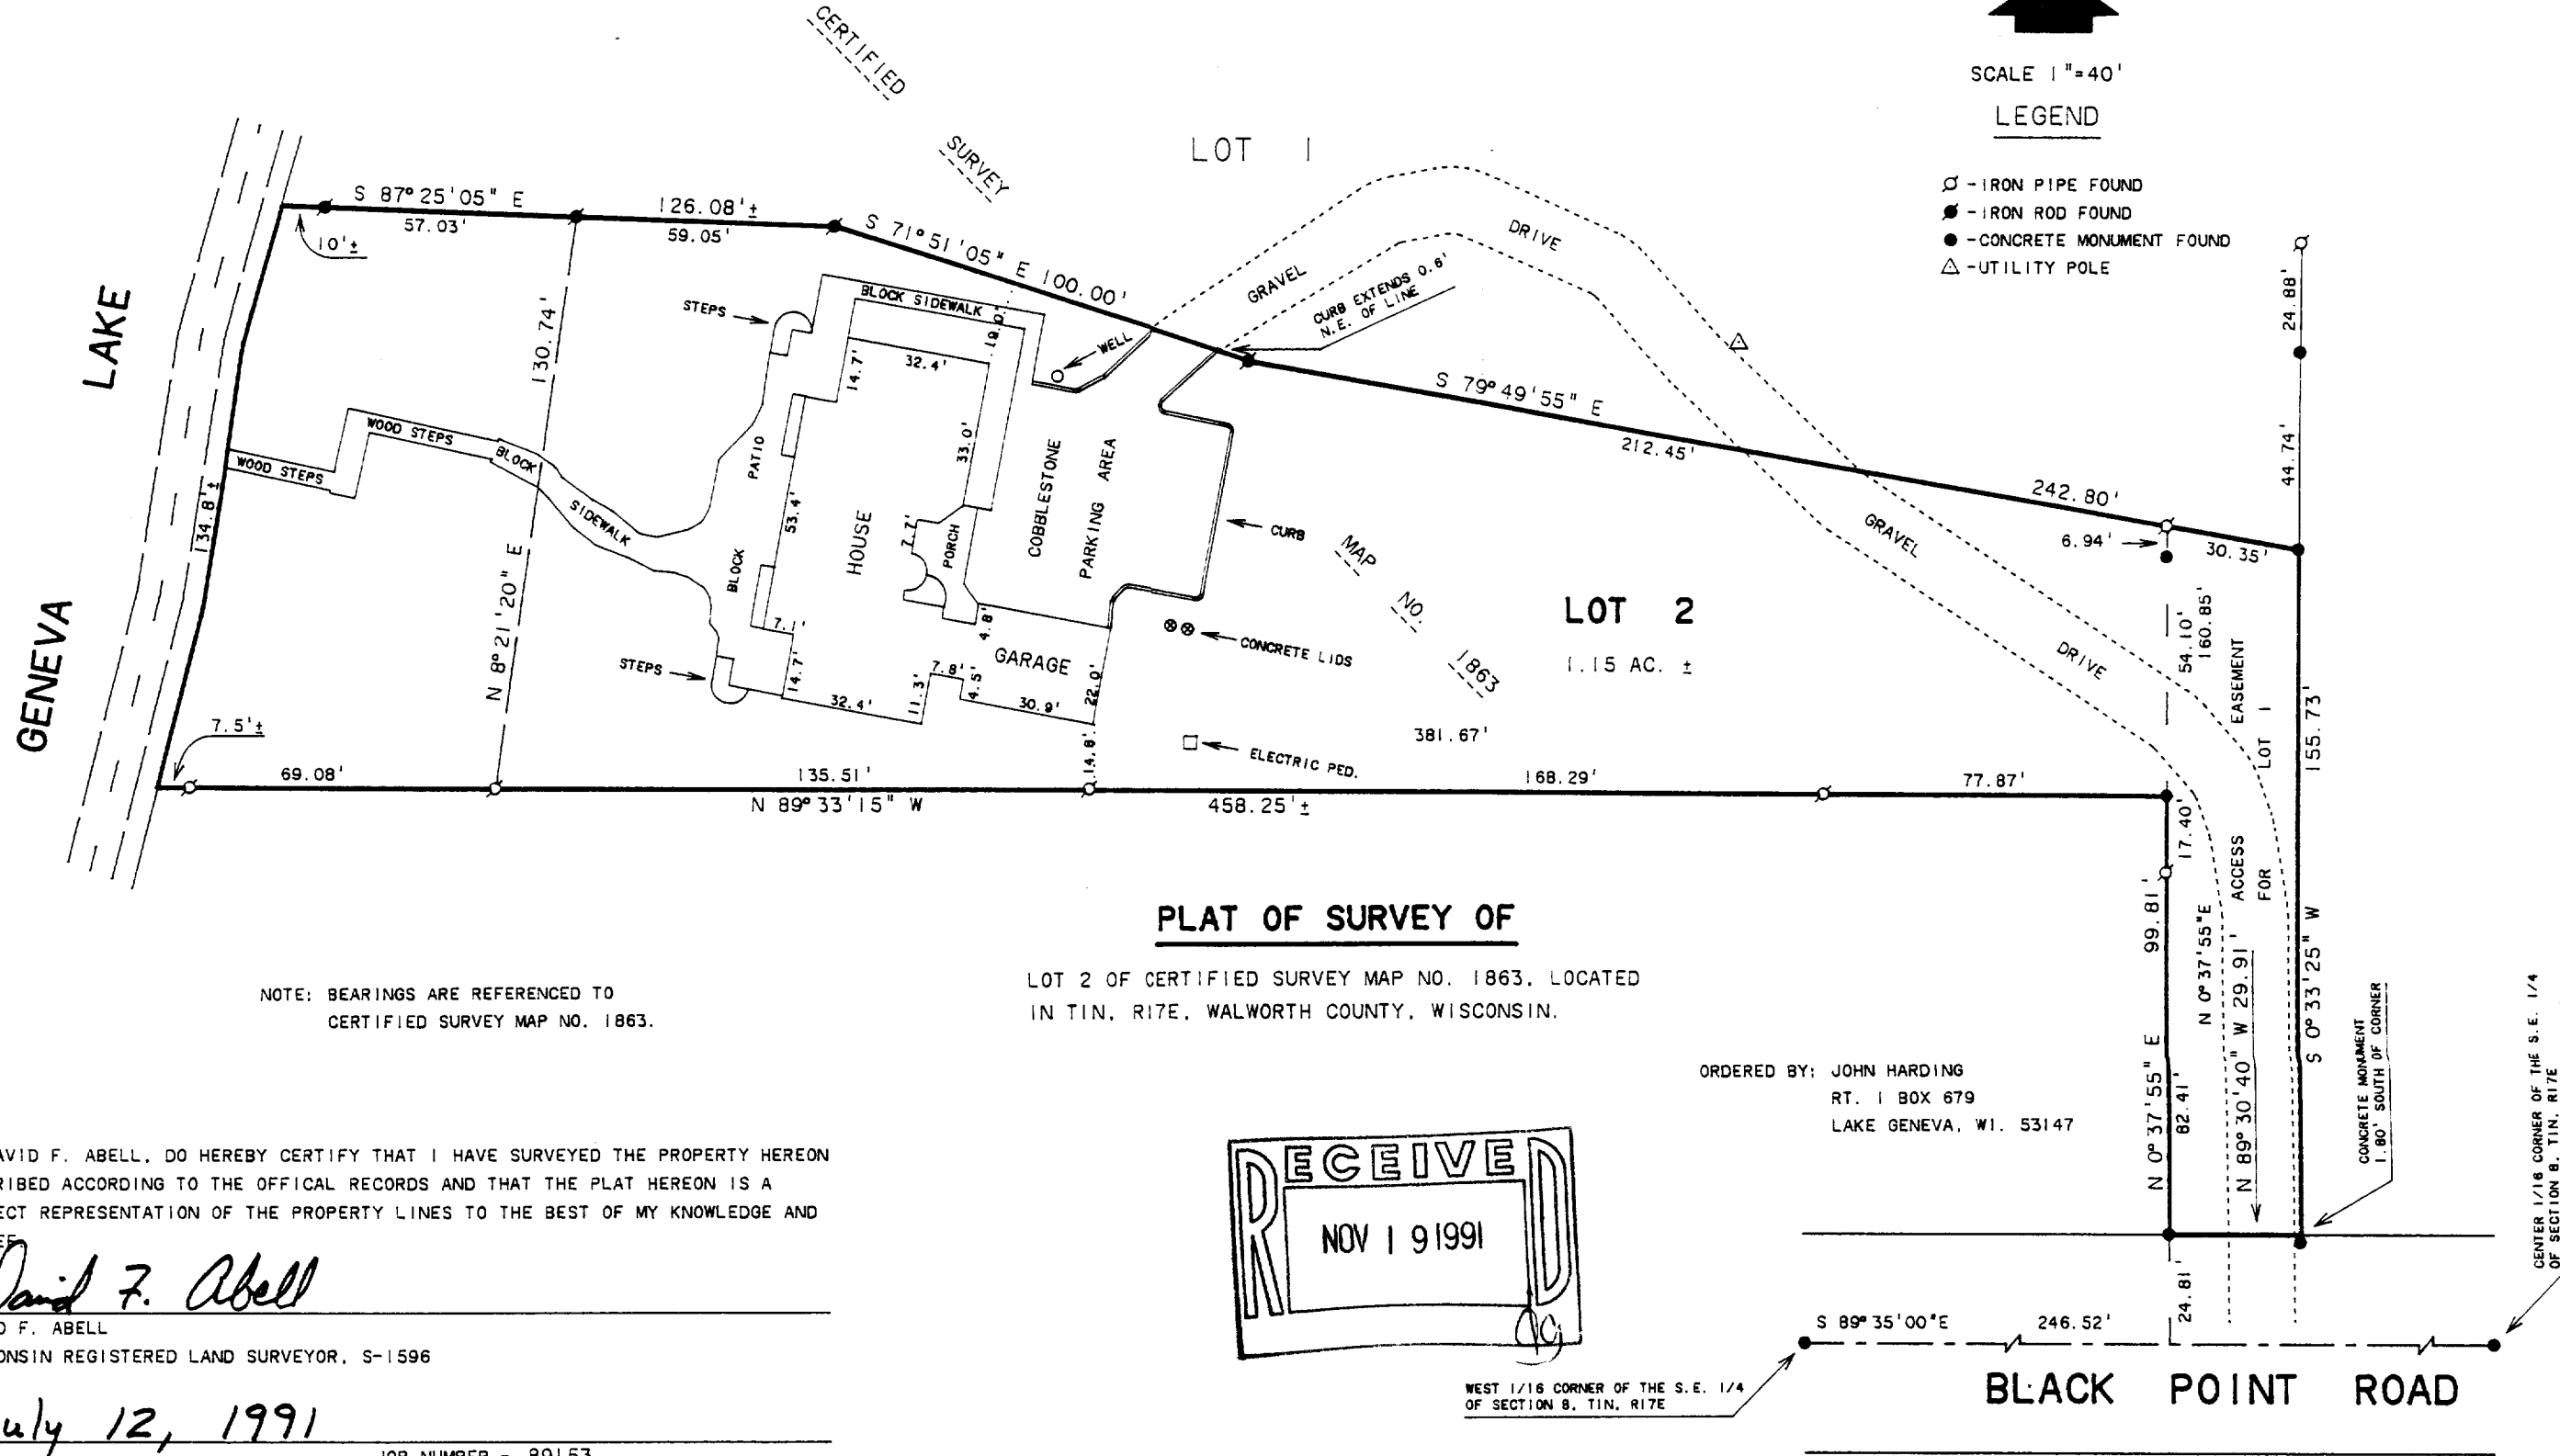


NOTE: BEARINGS ARE REFERENCED TO
CERTIFIED SURVEY MAP NO. 1863.

PLAT OF SURVEY OF

LOT 2 OF CERTIFIED SURVEY MAP NO. 1863, LOCATED
IN T1N, R17E, WALWORTH COUNTY, WISCONSIN.

ORDERED BY: JOHN HARDING
RT. 1 BOX 679
LAKE GENEVA, WI. 53147

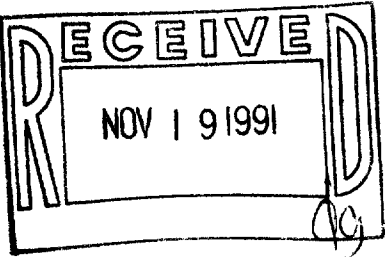

I, DAVID F. ABELL, DO HEREBY CERTIFY THAT I HAVE SURVEYED THE PROPERTY HEREON
DESCRIBED ACCORDING TO THE OFFICIAL RECORDS AND THAT THE PLAT HEREON IS A
CORRECT REPRESENTATION OF THE PROPERTY LINES TO THE BEST OF MY KNOWLEDGE AND
BELIEF.

David F. Abell

DAVID F. ABELL
WISCONSIN REGISTERED LAND SURVEYOR, S-1596

July 12, 1991

DATE JOB NUMBER - 89153

NOTE: THIS IS NOT A CERTIFIED COPY UNLESS SEALED.

IA1863-2