

# PLAT OF SURVEY

The East  $\frac{1}{2}$  of Lot 9, Block 3 of Rowena Park, a subdivision located in the West  $\frac{1}{2}$  of Section 5, T 1 N, R 17 E, Walworth County, Wisconsin

JENSEN SURVEYING & MAPPING S.C.  
45 South Wisconsin Street P.O. Box 322  
Elkhorn, Wisconsin 53121  
(414) 723-3434



Ordered by: Gordy Downing  
c/o Thorson, Davies & Johnson  
135 W. Geneva St.  
Elkhorn, WI 53121

CERTIFIED SURVEY MAP NO. 1260

(N 88° 02' 40" E 287.64)  
N 88° 02' 00" E

143.78

143.78

LOT 5

LOT

7

214.50 (214.80)

LOT

9

CERTIFIED SURVEY MAP NO. 20


295.28  
N 2° 36' W

N 2° 35' 30" W

728.32

S 2° 35' 00" E 727.97 (729')

LOT 10

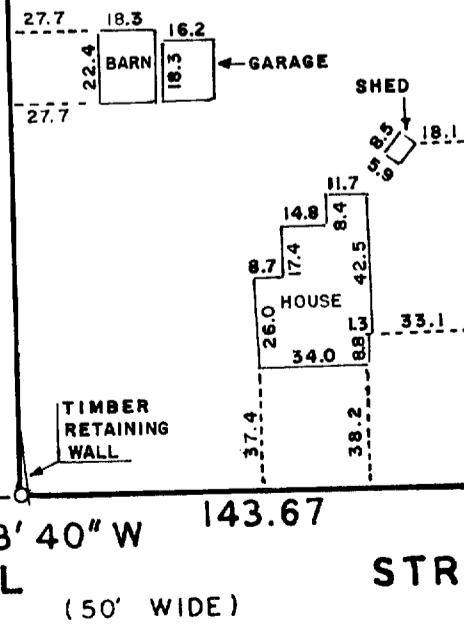

Bearings are referenced to the east line of Certified Survey Map No. 20 recorded as N 2° 36' W

SCALE: 1" = 60'

Mapping Date: April 10, 1991


## LEGEND



- ♂ - Found iron pipe
- - Found iron rod
- - Set iron pipe, 1" X 24"
- ( ) Recorded dimension

Copyright © 1991 by Jensen Surveying & Mapping S.C.

All rights reserved. No part of this survey plat may be reproduced or transmitted in any form by any means - graphic, electronic, or mechanical, including photocopying, tracing, or information storage and retrieval systems - without permission in writing from Thomas P.A. Jensen, Jensen Surveying & Mapping S.C.

I, Thomas P.A. Jensen, Wisconsin Registered Land Surveyor, do hereby certify that this survey was performed by me, or under my direction, in full compliance with the owner's/agent's instructions and Chapter A-E 7 of the Wisconsin Administrative Code "Minimum Standards For Property Surveys"; and that this map is an accurate representation thereof to the best of my knowledge and belief.

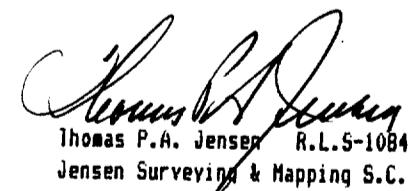  
Thomas P.A. Jensen R.L.S-1084  
Jensen Surveying & Mapping S.C.

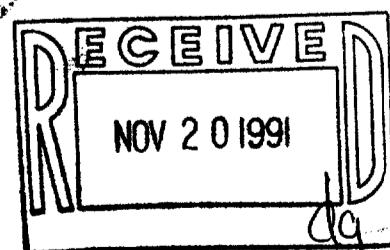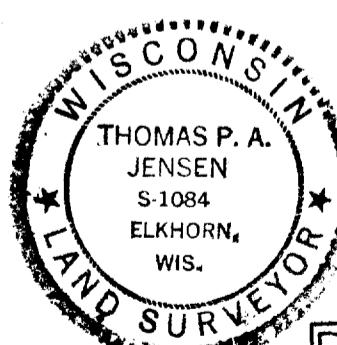

Note: This survey plat is not certified unless signed and sealed in red ink.

1991.055

17-1121

IRP-38