


LOCATED IN PART OF LOT 1
BONNIE BRAE SUBDIVISION
LINN TOWNSHIP
WALWORTH COUNTY, WISCONSIN


SOUTHEAST LINE ASSIGNED BEARING
S 20° 34' 10" E
AS PLATS OF RECORD

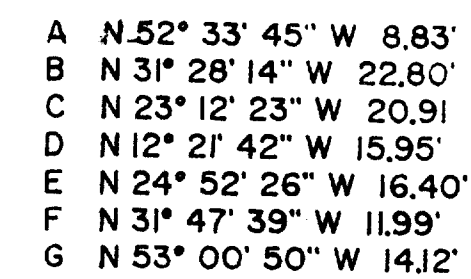

○ = IRON PIPE STAKE FOUND
 ● = IRON REBAR STAKE SET
 □ = BARRE GRANITE BOUND FOUND
 (XXX) = RECORDED AS
 ⊗ = CONCRETE BOUND FOUND
 ● = IRON REBAR STAKE FOUND

I HEREBY CERTIFY THAT THIS MAP IS A TRUE
AND ACCURATE REPRESENTATION OF THE BOUNDARY LINES
AND LOCATION OF IMPROVEMENTS SHOWN TO THE BEST OF MY
PROFESSIONAL KNOWLEDGE AND BELIEF.

DATED: 09/13/92

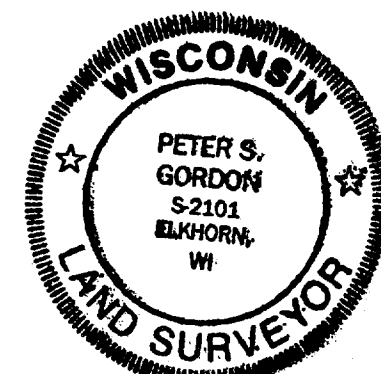

LEGAL DESCRIPTION OF LAND TO BECOME
APPURTENANT TO LANDS OWNED BY ROBERT B. MOORE
IN SECTIONS 3 AND 4, TOWN 1 NORTH, RANGE 17 EAST
WALWORTH COUNTY, WISCONSIN

A PART OF PARCEL "B" LOCATED IN LOT 1 OF BONNIE BRAE SUBDIVISION WHICH LIES IN SECTION 3 AND 4, TOWNSHIP 1 NORTH, RANGE 17, EAST, WALNORTH COUNTY, WISCONSIN DESCRIBED AS:

COMMENCING AT POINT THAT IS SOUTH 060DG 24MIN 48SEC EAST 411.44 FEET FROM A BARRE GRANITE MONUMENT, SAID POINT BEING THE EAST LINE OF BOWMAN BRAN SUBDIVISION AND THE SHORE OF GENOVA LAKE, THENCE NORTH 00DG 24MIN 48SEC WEST 411.44 FEET, THENCE NORTH 12DG 24MIN 48SEC WEST 78.12 FEET TO THE POINT OF BEGINNING, 12DG 24MIN 48SEC WEST 127.51 FEET TO THE POINT OF BEGINNING, 13DG 06MIN 46SEC WEST 28.62 FEET, THENCE NORTH 53DG 06MIN 50SEC EAST 14.12 FEET, THENCE NORTH 31DG 47MIN 39SEC WEST 11.95 FEET, THENCE NORTH 12DG 24MIN 48SEC WEST 140 FEET, THENCE NORTH 12DG 24MIN 42SEC WEST 15.95 FEET, THENCE NORTH 35DG 35SEC WEST 20.91 FEET, THENCE NORTH 33DG 28MIN 14SEC WEST 22.80 FEET, THENCE NORTH 52DG 30MIN 45SEC WEST 8.83 FEET, THENCE NORTH 16DG 42MIN 55SEC EAST 10.00 FEET, THENCE NORTH 01DG 08MIN EAST 127.51 FEET TO THE POINT OF BEGINNING. CONTAINING 6497 SQUARE FEET MORE OR LESS. (End of legal description.)

[illegible]

Star Key No. 122 0003151

FLAT OF SURVEY
LOCATED IN PART OF LOT 1
BONNIE BRAE SUBDIVISION
LINN TOWNSHIP
WALWORTH COUNTY, WISCONSIN

ORDERED BY:
BILL HAYES

FARRIS, HANSEN & ASSOCIATES, INC.
Engineering, Architecture, Surveying
7 Ridgway Court P.O. Box 437
ELKHORN, WISCONSIN 53121
Office: (414) 723-2096
Fax: (414) 723-5886

VISIONS

PROJECT NO
3629
DATE
11/10/92
PROJECT NO

TBR-3D