



ASSUMED

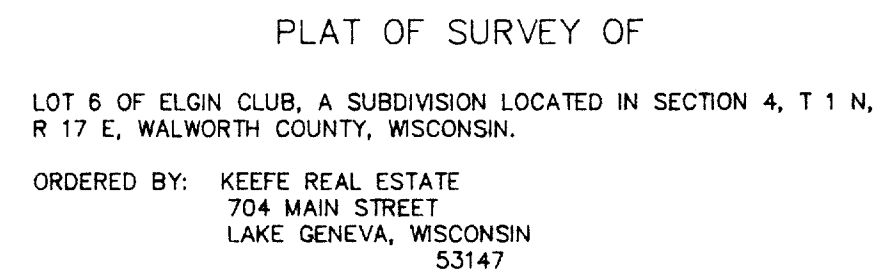

Category	20	0	10	20	40
No	~45%	~35%	~25%	~15%	~10%
Yes	~10%	~20%	~30%	~40%	~50%
Don't know	~15%	~25%	~35%	~45%	~55%
No answer	~30%	~20%	~10%	~0%	~0%

♂-IRON PIPE FOUND
 ○-IRON PIPE PLACED
 ●-STONE MONUMENT FOUND
 ()-RECORDED AS
 + -CUT CROSS IN CONCRETE

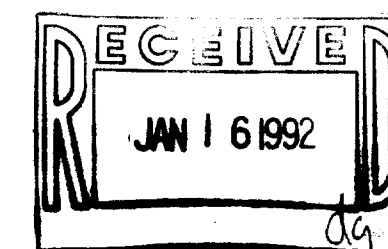

NOTE: THIS IS NOT A CERTIFIED COPY UNLESS SEALED.