


**SURVEYING & SUBDIVIDING
DELAN, WISCONSIN 53115**



George T. Dunham
George T. Dunham, Surveyor

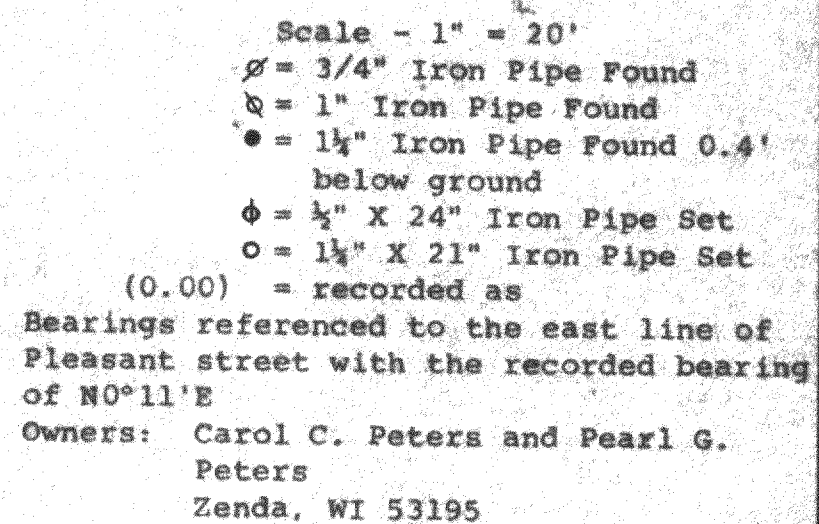