
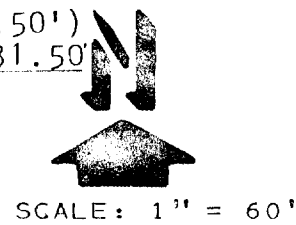


KOLB LAND CONSULTING, INC.  
LAND SURVEYING • SUBDIVIDING • LAND PLANNING

LAKE GENEVA, WISCONSIN 53147

CENTERLINE OF A 16' WIDE RIGHT-OF-WAY  
AS SHOWN IN DOC. NO. 351034 WALWORTH COUNTY

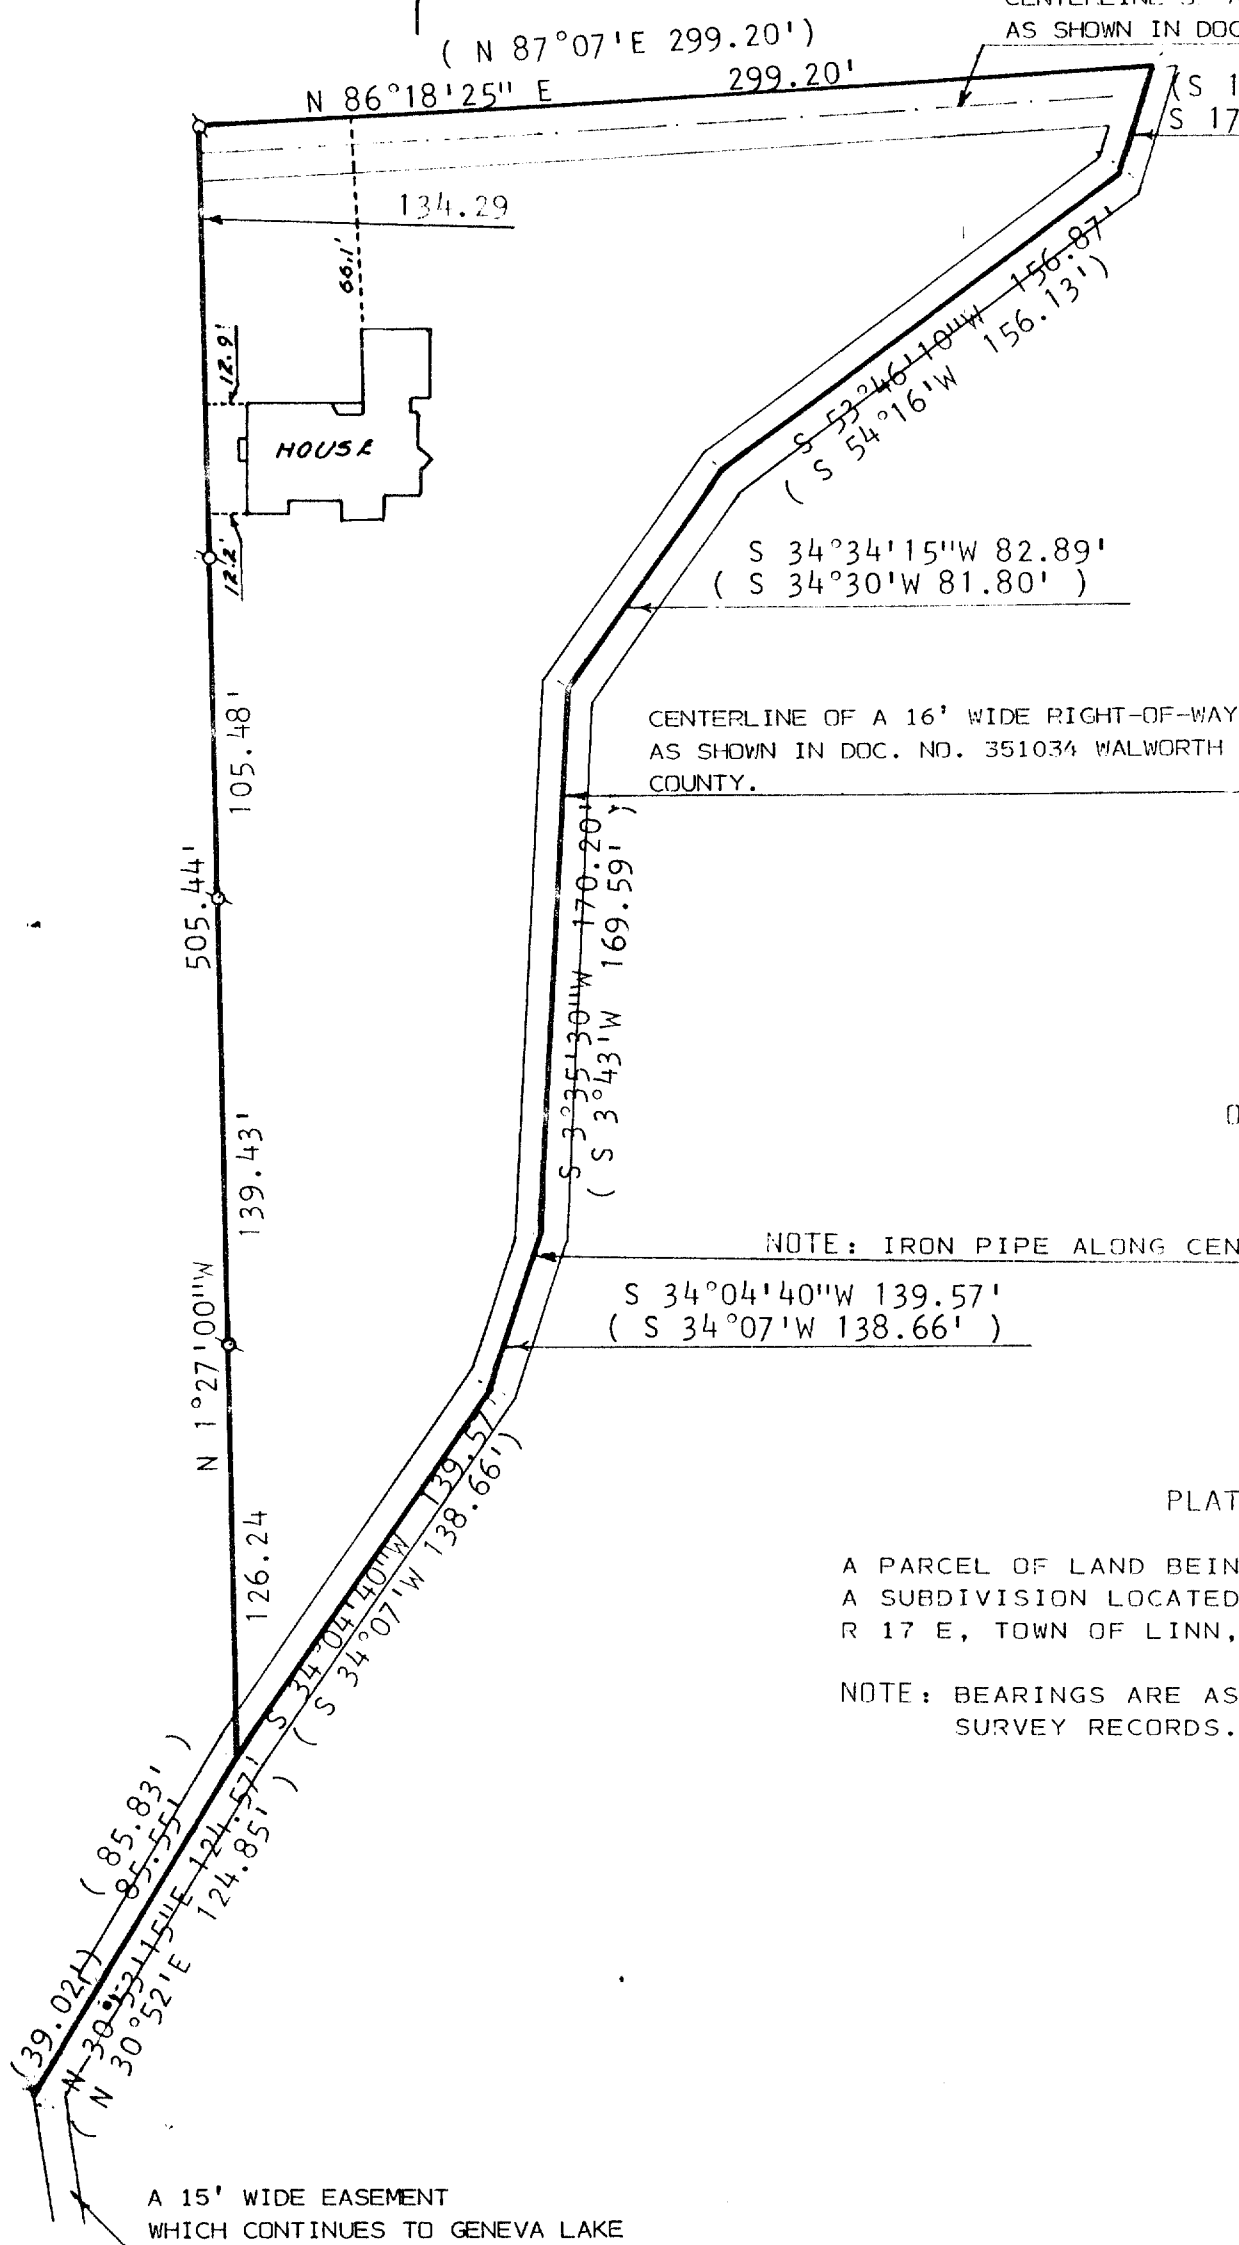

LEGEND

- Ø - IRON PIPE FOUND
- () - AS RECORDED

ORDERED BY: LINDA PAAVOLI  
ROUTE 4  
LAKE GENEVA, WI. 53147

NOTE: IRON PIPE ALONG CENTERLINE OF ROAD NOW UNDER BLACKTOP.

S 34°04'40"W 139.57'  
( S 34°07'W 138.66' )


PLAT OF SURVEY OF

A PARCEL OF LAND BEING PART OF LOT 1, BONNIE BRAE,  
A SUBDIVISION LOCATED IN SECTIONS 3 & 4, T 1 N,  
R 17 E, TOWN OF LINN, WALWORTH COUNTY, WISCONSIN.

NOTE: BEARINGS ARE ASSUMED AS SHOWN ON EXISTING  
SURVEY RECORDS.

NOTE: SURVEY IS NOT VALID UNLESS THE  
SURVEYOR'S SIGNATURE IS IN RED.

I, HAROLD H. KOLB, DO HEREBY CERTIFY  
THAT I HAVE SURVEYED THE PROPERTY  
HEREON DESCRIBED ACCORDING TO THE  
OFFICIAL RECORDS, AND THAT THE PLAT  
HEREON IS A CORRECT REPRESENTATION  
OF THE LOT LINES AND THE PRINCIPAL  
LINES OF THE BUILDING THEREON, TO  
THE BEST OF MY KNOWLEDGE AND BELIEF.

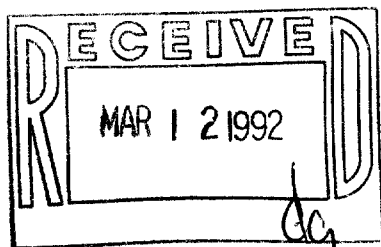

HAROLD H. KOLB  
WISCONSIN REGISTERED LAND SURVEYOR, S-137  
DATE JULY 2, 1990