


FARRIS, HANSEN & COOPER, INC.

ENGINEERING, SURVEYING AND LAND PLANNING
715 W. WALWORTH ST. - P.O. BOX 487 - ELKHORN, WI 53121

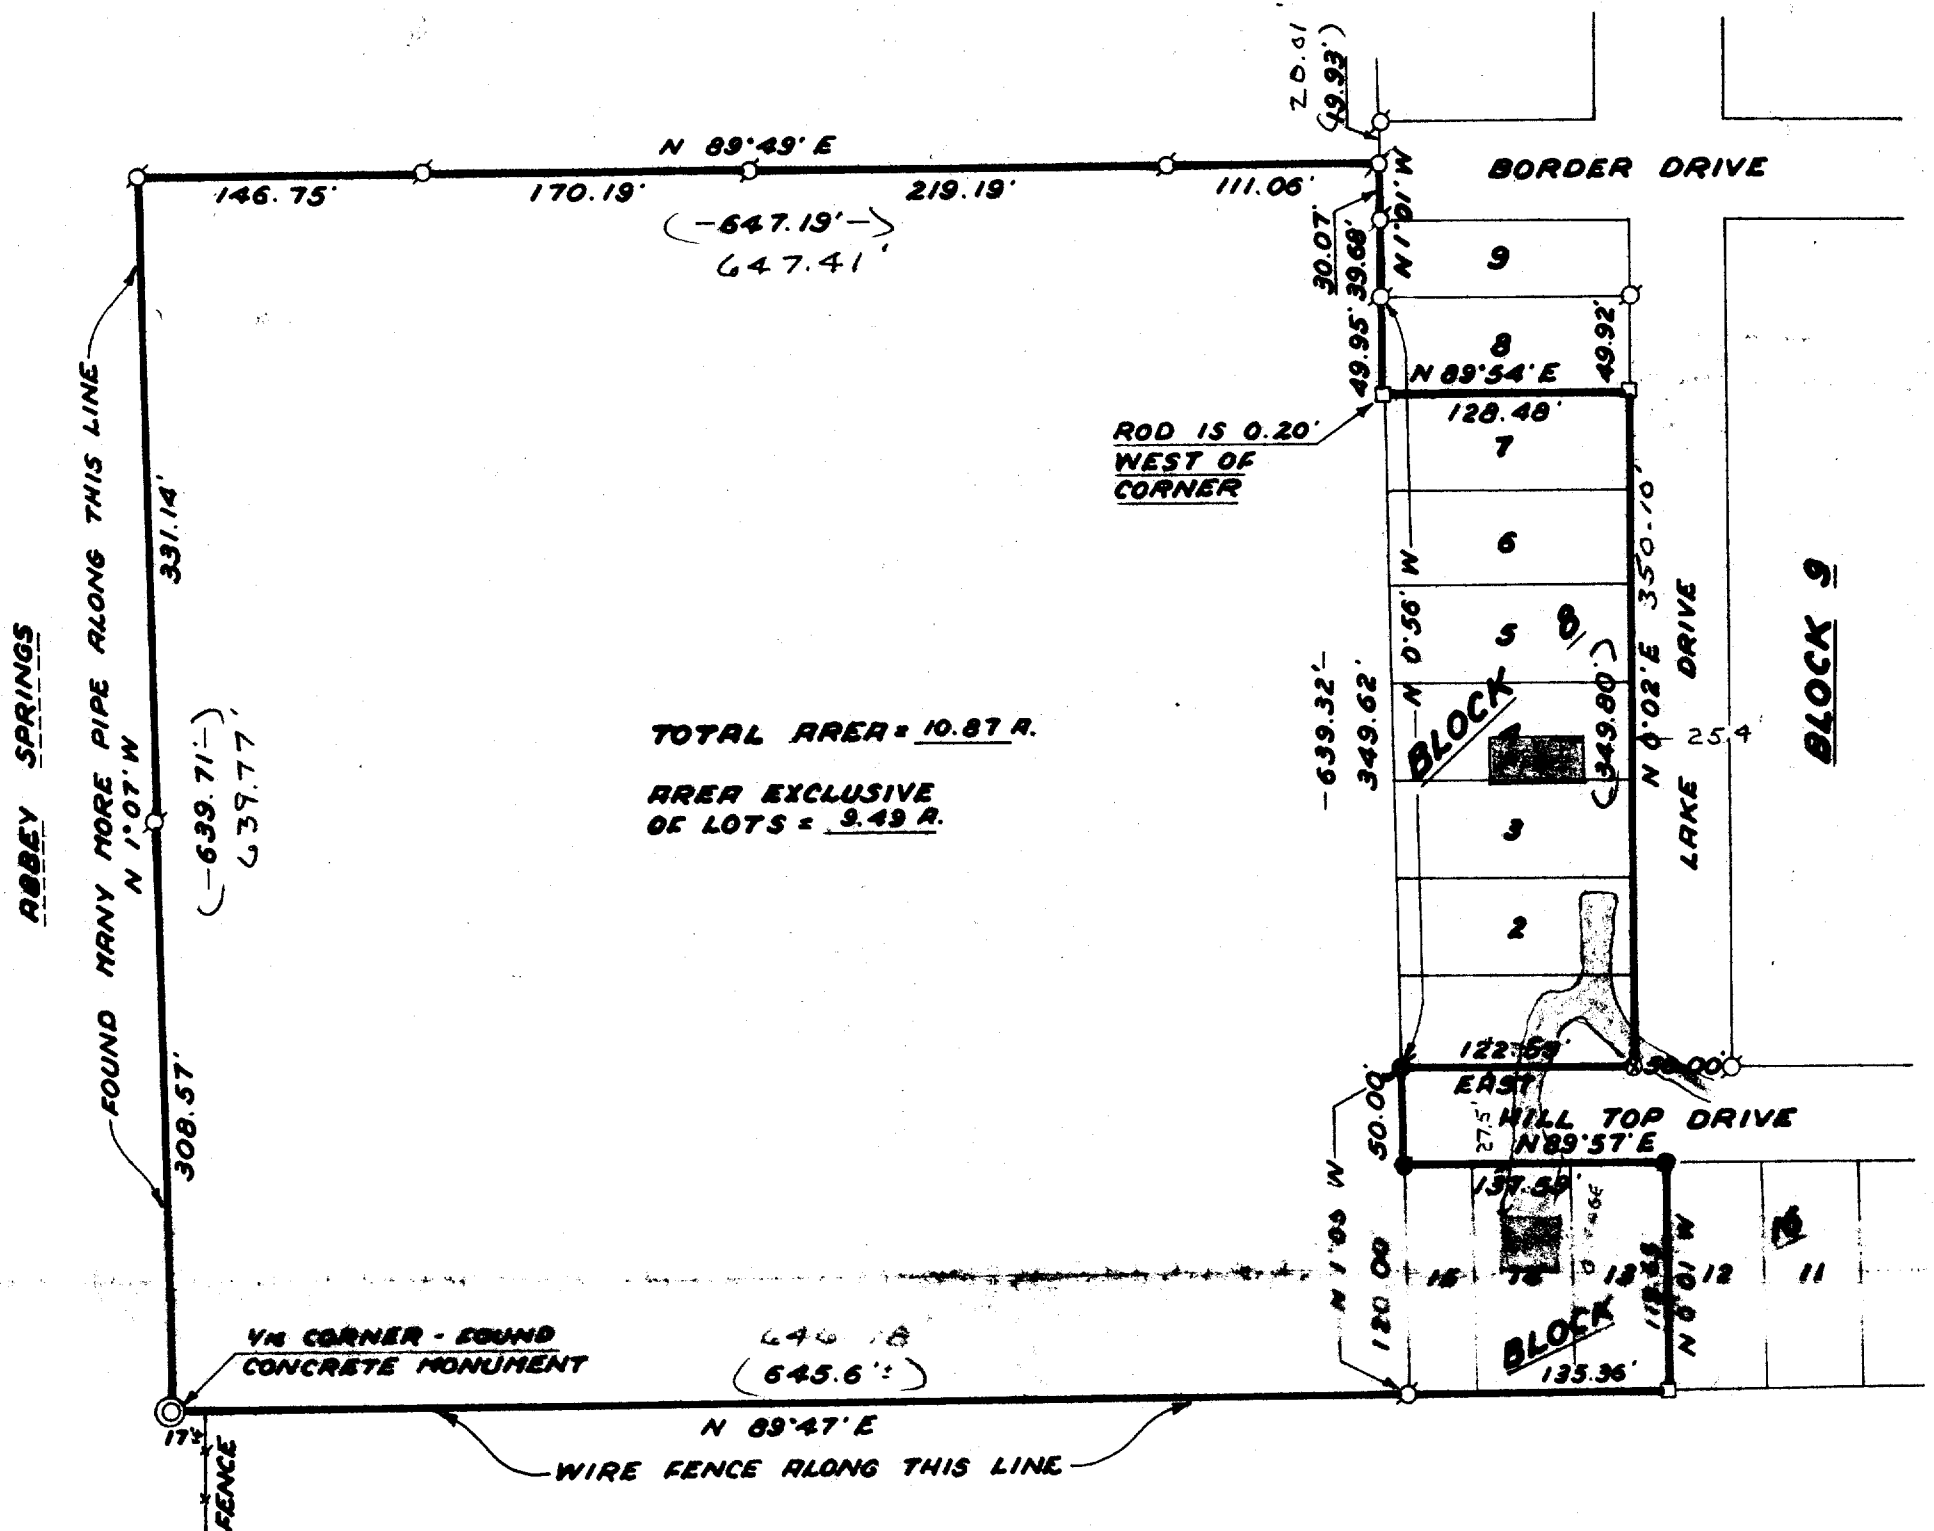

PLAT OF SURVEY OF

THE SOUTH 640 FEET OF THE WEST 1/2 OF THE SOUTHEAST 1/4 OF THE SOUTH-WEST 1/4, ALSO LOTS 1, 2, 3, 4, 5, 6 AND 7 OF BLOCK 8 AND LOTS 13, 14 AND 15 OF BLOCK 16 OF MAPLE HILLS "A", ALL IN SECTION 18, TOWN 1 NORTH, RANGE 17 EAST, WALWORTH COUNTY, WISCONSIN.


LEGEND

- Found 3/8" Sq. Iron Rod
- Found Iron Pipe
- Set Iron Pipe
- ⊙—Found 5" Dia. Conc. Mon.
- ()—Record Dimension
- SET IRON REBAR STAKE
- ⊗—SET PR NAIL IN PAVEMENT

ORDERED BY:

Spencer Willison

REVISION: BILL WILSON

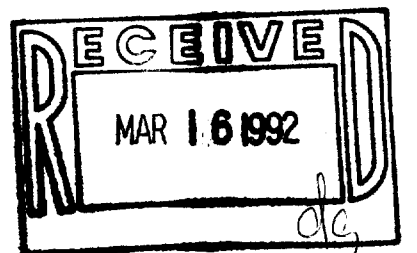

South line of Lot 1, Block 8 is assumed to bear "East".



I HEREBY CERTIFY that this is a true and accurate representation of the property lines as found to be monumented to the best of my knowledge and belief.


Robert A. Farris

Robert A. Farris, RLS No. 1293

Dated this 12th day of December, 1979.

REVISED THIS 27th DAY OF FEBRUARY, 1992

Peter S. Gordon
PETER S. GORDON, RLS 2101

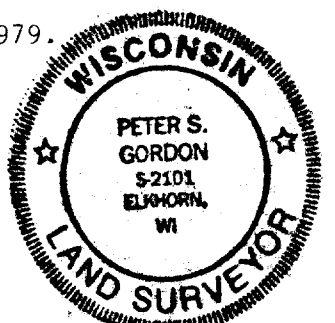

100 50 0 100 200 300 400 500
SCALE IN FEET (1"=100')

PROJECT NO. 1639

IMH-320
IMH-192
IMH-194
IMH-197

117-1172