


414-728-6737



- ♂ - IRON PIPE FOUND
 ■ - CONCRETE MONUMENT FOUND
 ○ - IRON PIPE SET
 -XX-XX- WIRE FENCE
 -X-X- WOOD FENCE
 () - RECORDED AS

ORDERED BY: JAMES MCGREEVY
RT 1, BOX 390D
FONTANA, WI. 53125

LOT 14, OAK SHORES LOCATED IN TIN.
RIZE, WALWORTH COUNTY, WISCONSIN.

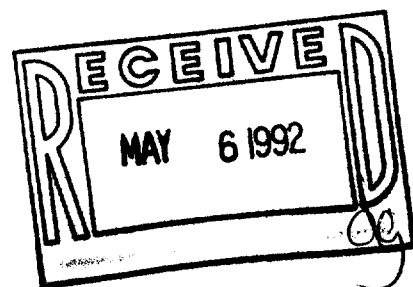

I HEREBY CERTIFY THAT I HAVE SURVEYED THE ABOVE DESCRIBED PROPERTY AND THAT THE ABOVE MAP IS A TRUE REPRESENTATION THEREOF AND SHOWS THE SIZE AND LOCATION OF THE PROPERTY, ITS EXTERIOR BOUNDARIES, THE LOCATION OF ALL VISIBLE STRUCTURES AND DIMENSIONS OF ALL PRINCIPAL BUILDINGS THEREON, BOUNDARY FENCES, APPARENT EASEMENTS, ROADWAYS AND VISIBLE ENCROACHMENTS, IF ANY, TO THE BEST OF MY KNOWLEDGE AND BELIEF.

THIS SURVEY IS MADE FOR THE USE OF THE PRESENT OWNERS OF THE PROPERTY, AND ALSO THOSE WHO PURCHASE, MORTGAGE, OR GUARANTEE THE TITLE THERETO WITHIN ONE (1) YEAR FROM DATE HEREON.

DAVID F. ABELL
WISCONSIN REGISTERED LAND SURVEYOR. S-1596

February 18, 1992

DATE _____ JOB NUMBER - 92021
NOTE: THIS IS NOT A CERTIFIED COPY UNLESS SEALED.