


KOLB LAND CONSULTING, INC.

LAND SURVEYING · SUBDIVIDING · LAND PLANNING

929 WILLIAMS STREET LAKE GENEVA, WISCONSIN 53147 414-240-3697

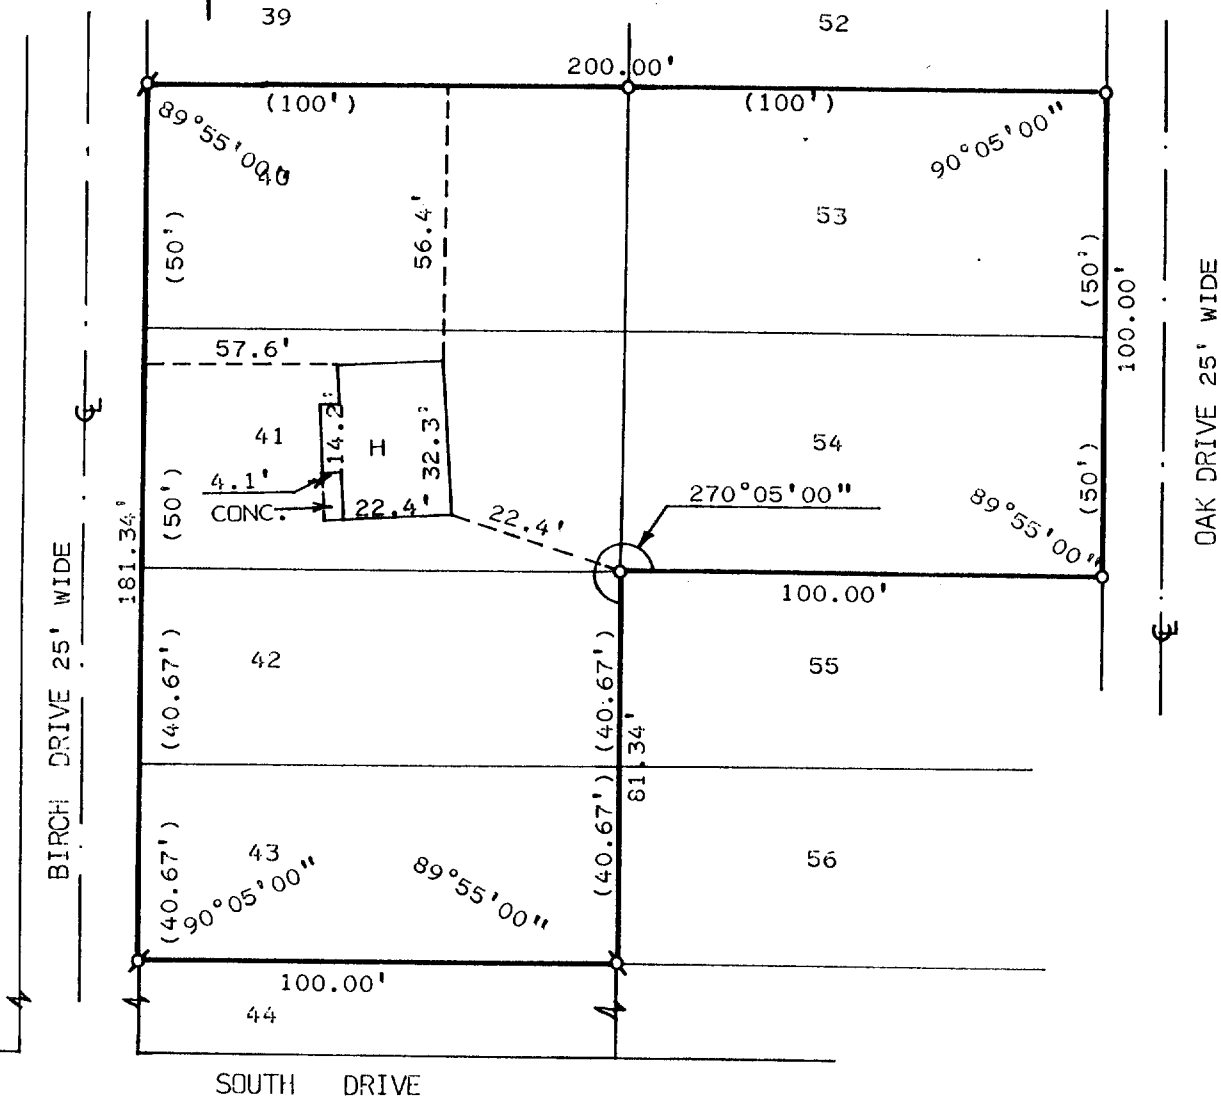

ORDERED BY: THOMAS KRESLER
1240 W. WEBSTER AVE.
CHICAGO, IL. 60614

PLAT OF SURVEY OF


LOTS 40-43 AND LOTS 53 AND 54 OF
EDGEWATER TERRACE A SUBDIVISION
LOCATED IN T1N, R17E, TOWN OF LINN,
WALWORTH COUNTY, WISCONSIN.



SCALE: 1" = 40'

LEGEND

- ⊕ - IRON PIPE FOUND
- - IRON PIPE SET
- () + AS RECORDED

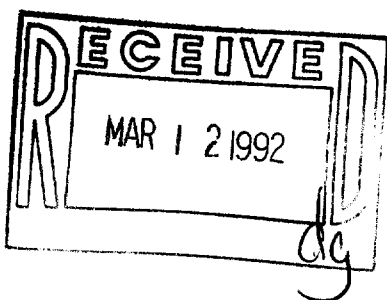

I, HAROLD H. KOLB DO HEREBY CERTIFY
THAT I HAVE SURVEYED THE PROPERTY
HEREON DESCRIBED ACCORDING TO THE
OFFICIAL RECORDS AND THAT THE PLAT
HEREON IS A CORRECT REPRESENTATION
OF THE LOT LINES TO THE BEST OF MY
KNOWLEDGE AND BELIEF.

THIS SURVEY IS NOT VALID UNLESS THE SURVEYOR'S
SIGNATURE IS IN RED.

HAROLD H. KOLB
WISCONSIN REGISTERED LAND SURVEYOR. S-187
DATE: NOVEMBER 18, 1991
REVISE:

IE-36 IE-49
IE-37 IE-50
IE-38
IE-39