


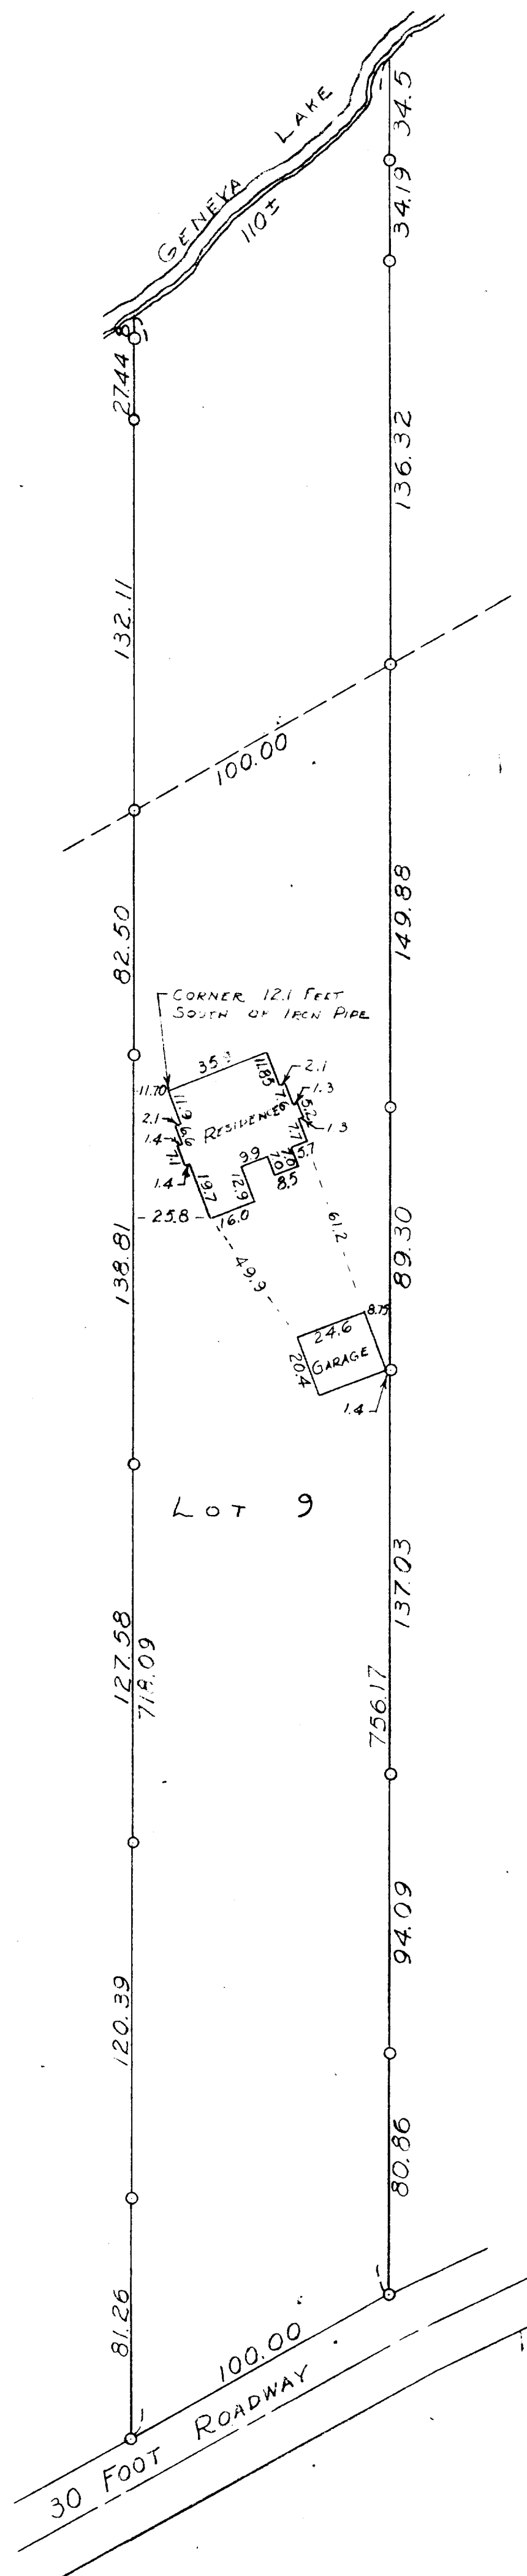

George J. Dunham
GEORGE J. DUNHAM, SURVEYOR
DELAN, WISCONSIN