

727 HENRY STREET
LAKE GENEVA, WISCONSIN
414-248-0505

BLOCK 4

SUNNYSIDE DRIVE

LOT 24 OF MAPLE HILLS "A" SUBDIVISION, LOCATED
IN SECTION 18, T 1 N, R 17 E, WALWORTH COUNTY,
WISCONSIN.

ORDERED BY: ASSURED REALTY
50 WEST GENEVA STREET
WILLIAMS BAY, WISCONSIN
53191

I HEREBY CERTIFY THAT I HAVE SURVEYED THE ABOVE DESCRIBED PROPERTY AND THAT THE ABOVE MAP IS A TRUE REPRESENTATION THEREOF AND SHOWS THE SIZE AND LOCATION OF THE PROPERTY, ITS EXTERIOR BOUNDARIES, THE LOCATION OF ALL VISIBLE STRUCTURES AND DIMENSIONS OF ALL PRINCIPAL BUILDINGS THEREON, BOUNDARY FENCES, APPARENT EASEMENTS, ROADWAYS AND VISIBLE ENCROACHMENTS, IF ANY, TO THE BEST OF MY KNOWLEDGE AND BELIEF.


THIS SURVEY IS MADE FOR THE USE OF THE PRESENT OWNERS OF THE PROPERTY AND ALSO THOSE WHO PURCHASE, MORTGAGE OR GUARANTEE THE TITLE THERETO WITHIN ONE (1) YEAR FROM DATE HEREOF.

Robert M. Baerenwald
ROBERT M. BAERENWALD
WISCONSIN REGISTERED LAND SURVEYOR, S-1508

DATE OCT. 15, 1990 JOB NO. 2654-1

NOTE: THIS IS NOT A CERTIFIED COPY UNLESS SEALED.

SCALE IN FEET

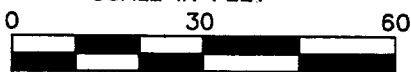

LEGEND

- Q-IRON PIPE FOUND
Q-IRON ROD FOUND
Q-CONCRETE MONUMENT FOUND
O-IRON PIPE PLACED
O-RECORDED AS

RECEIVED
JAN 16 1992

117-1265

IMH-77