


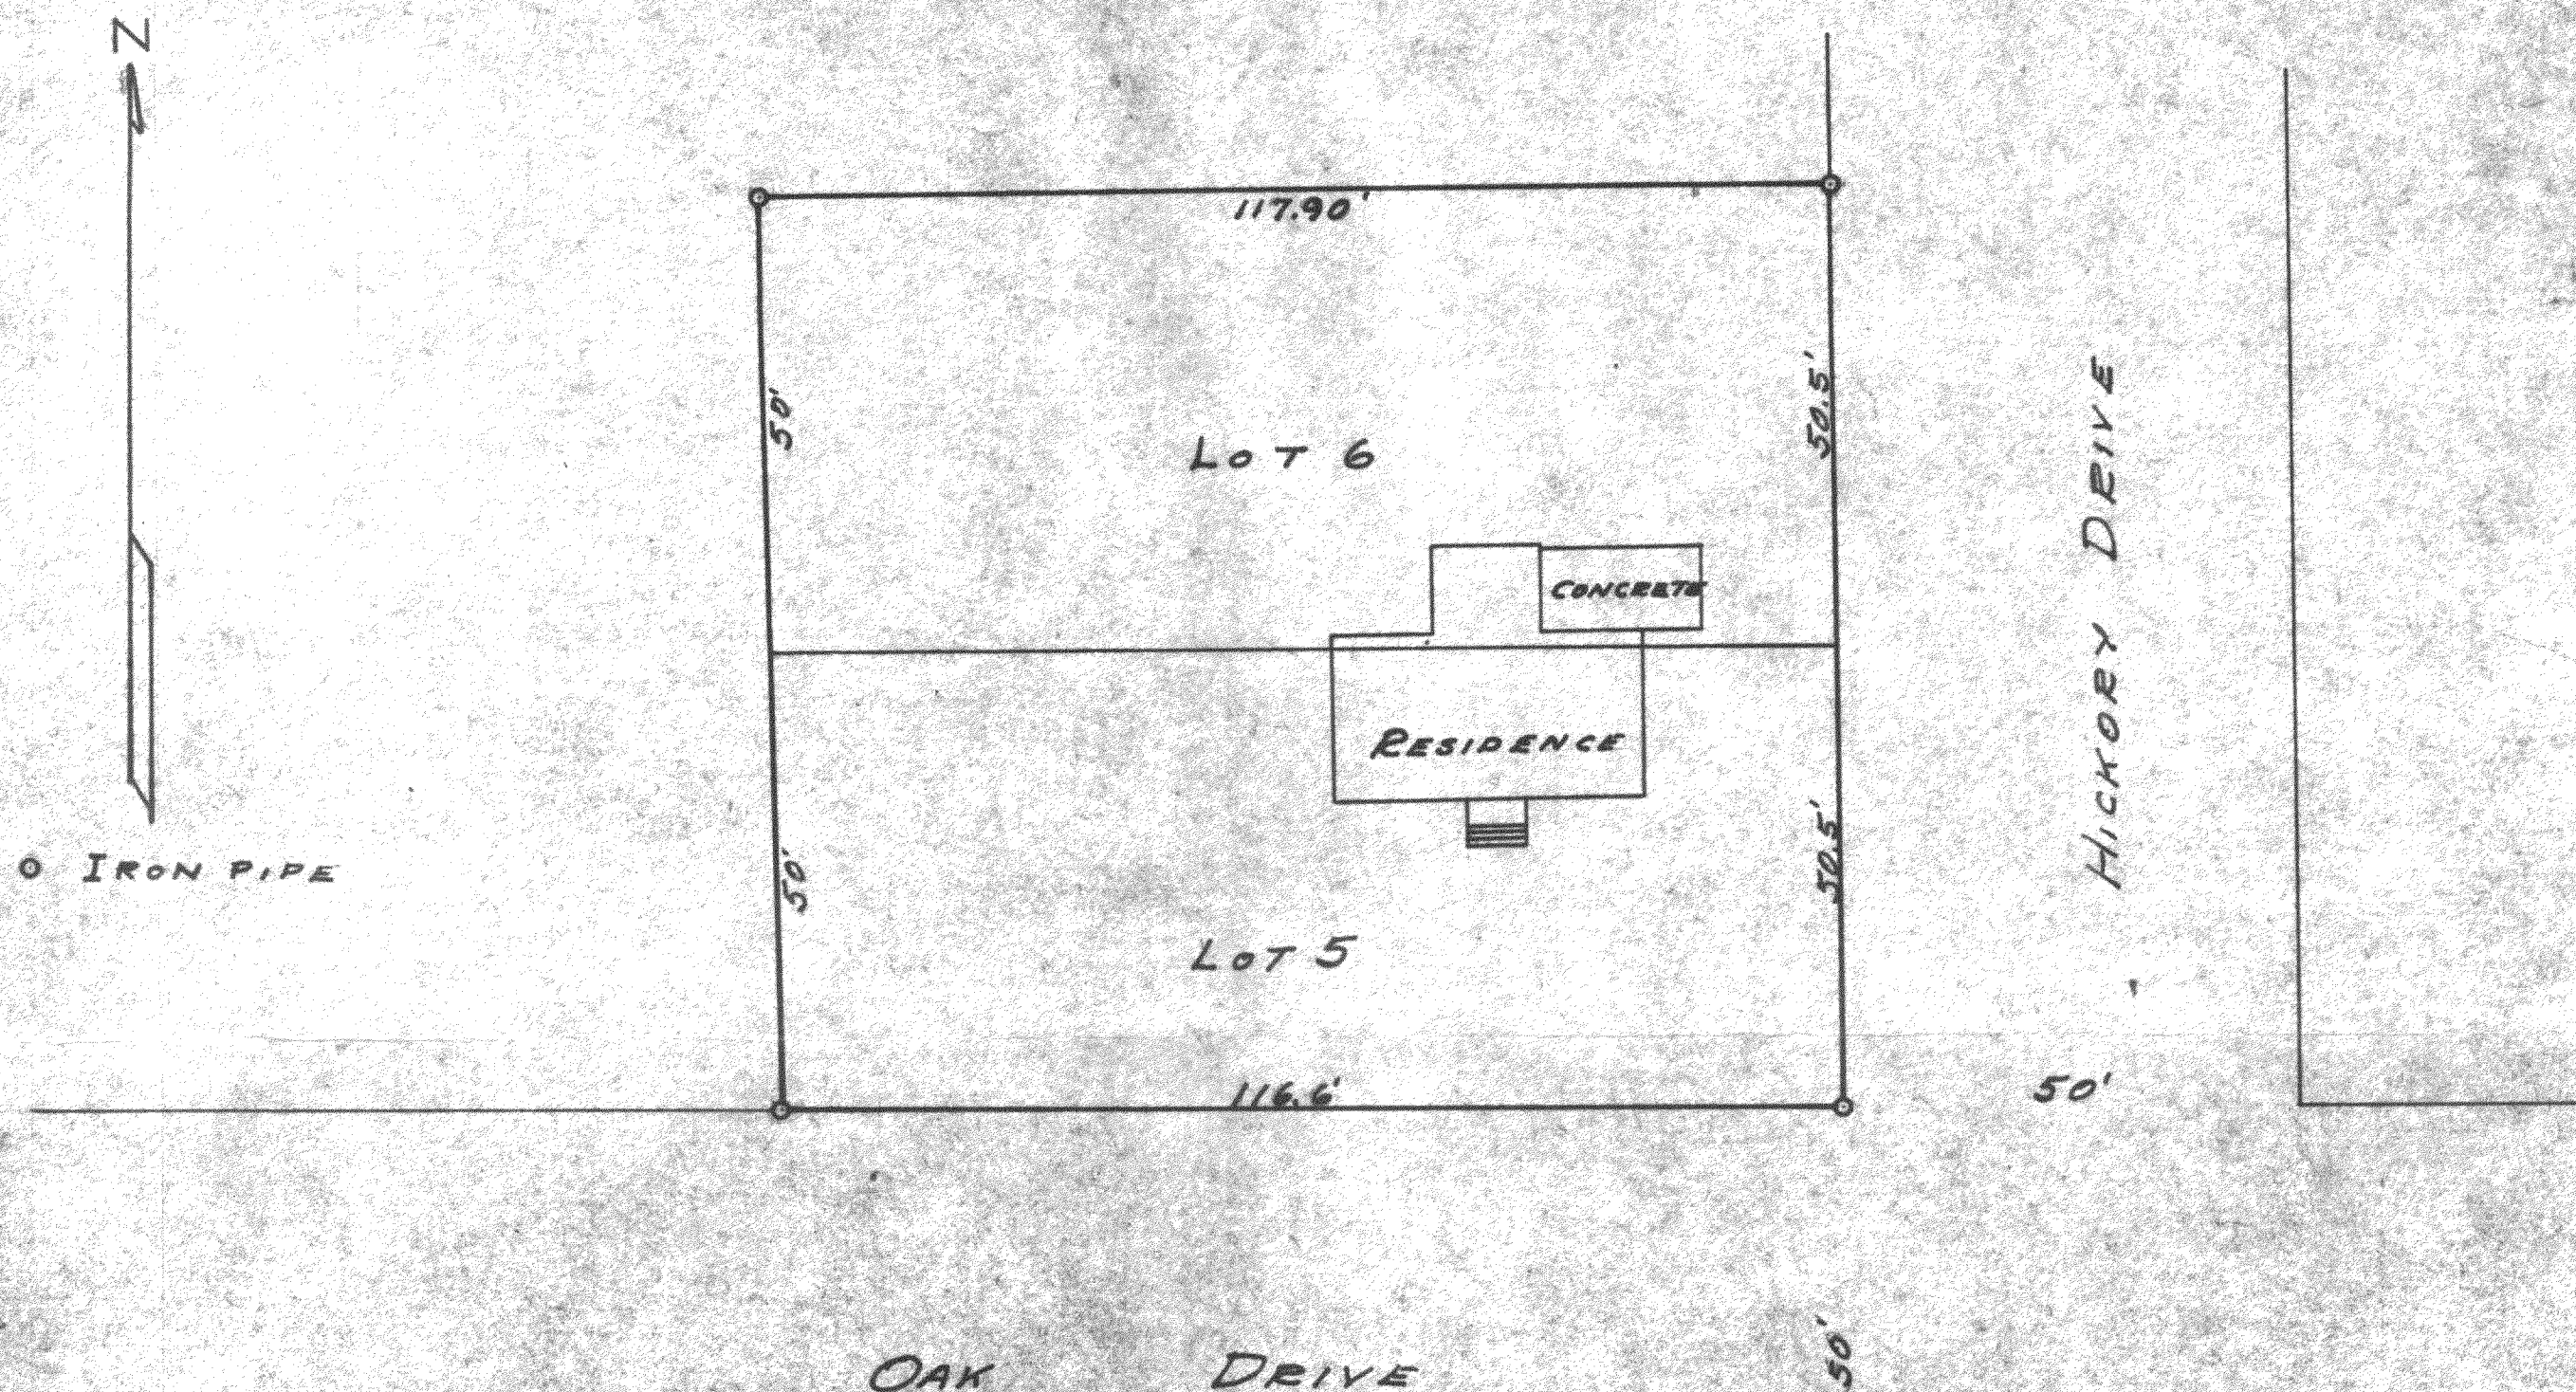

LOTS 5 AND 6 in BLOCK 6 in LAKEVIEW PARK, a SUBDIVISION OF PART OF THE NORTHEAST QUARTER OF SECTION 16, TOWNSHIP 1 NORTH, RANGE 17 EAST OF THE FOURTH PRINCIPAL MERIDIAN, ACCORDING TO THE PLAT THEREOF RECORDED JULY 26, 1928 IN VOLUME 10 OF PLATS PAGE 12 AND 13 IN WALWORTH COUNTY, WISCONSIN.

Lots 5 and 6 of Block 6 of Lakeview Park Subdivision, located in Section 16, T 1 N, R 17 E of Walworth County, Wisconsin.

"I hereby certify that I have surveyed the property described above according to official records, and that the above plat is a correct representation of the lot lines and measurements and the principal lines and measurements of all buildings and other structures thereon."

Elkhorn, Wisconsin

September 1, 1953

ILVP-28B

PLAT OF SURVEY OF

LOTS 5 AND 6 OF
BLOCK 6 OF LAKE
VIEW PARK SUBD

Roy P. Jensen
SURVEYOR

SCALE 1" = 20'

DATE SEPT. 1, 1953

117-122.1