

PLAT OF SURVEY


LOT 21 OF ROWENA PARK, A SUBDIVISION
LOCATED IN THE NW 1/4 AND SW 1/4 OF
SECTION 5, T1N, R17E, TOWN OF LINN,
WALWORTH COUNTY, WISCONSIN

ORDERED BY: JACK TOWER
929 S. ALPINE RD. SUITE 410
ROCKFORD, IL 61108
(815) 398-4100

Copyright © 1992 by Jensen Surveying & Mapping S.C.

All rights reserved. No part of this survey plat may be reproduced or transmitted in any form by any means - graphic, electronic, or mechanical, including photocopying, tracing, or information storage and retrieval systems - without permission in writing from Thomas P.A. Jensen, Jensen Surveying & Mapping S.C.

BEARINGS REFERENCED
TO THE WEST LINE OF
LOT 23 OF ROWENA
PARK ASSUMED AS
NORTH


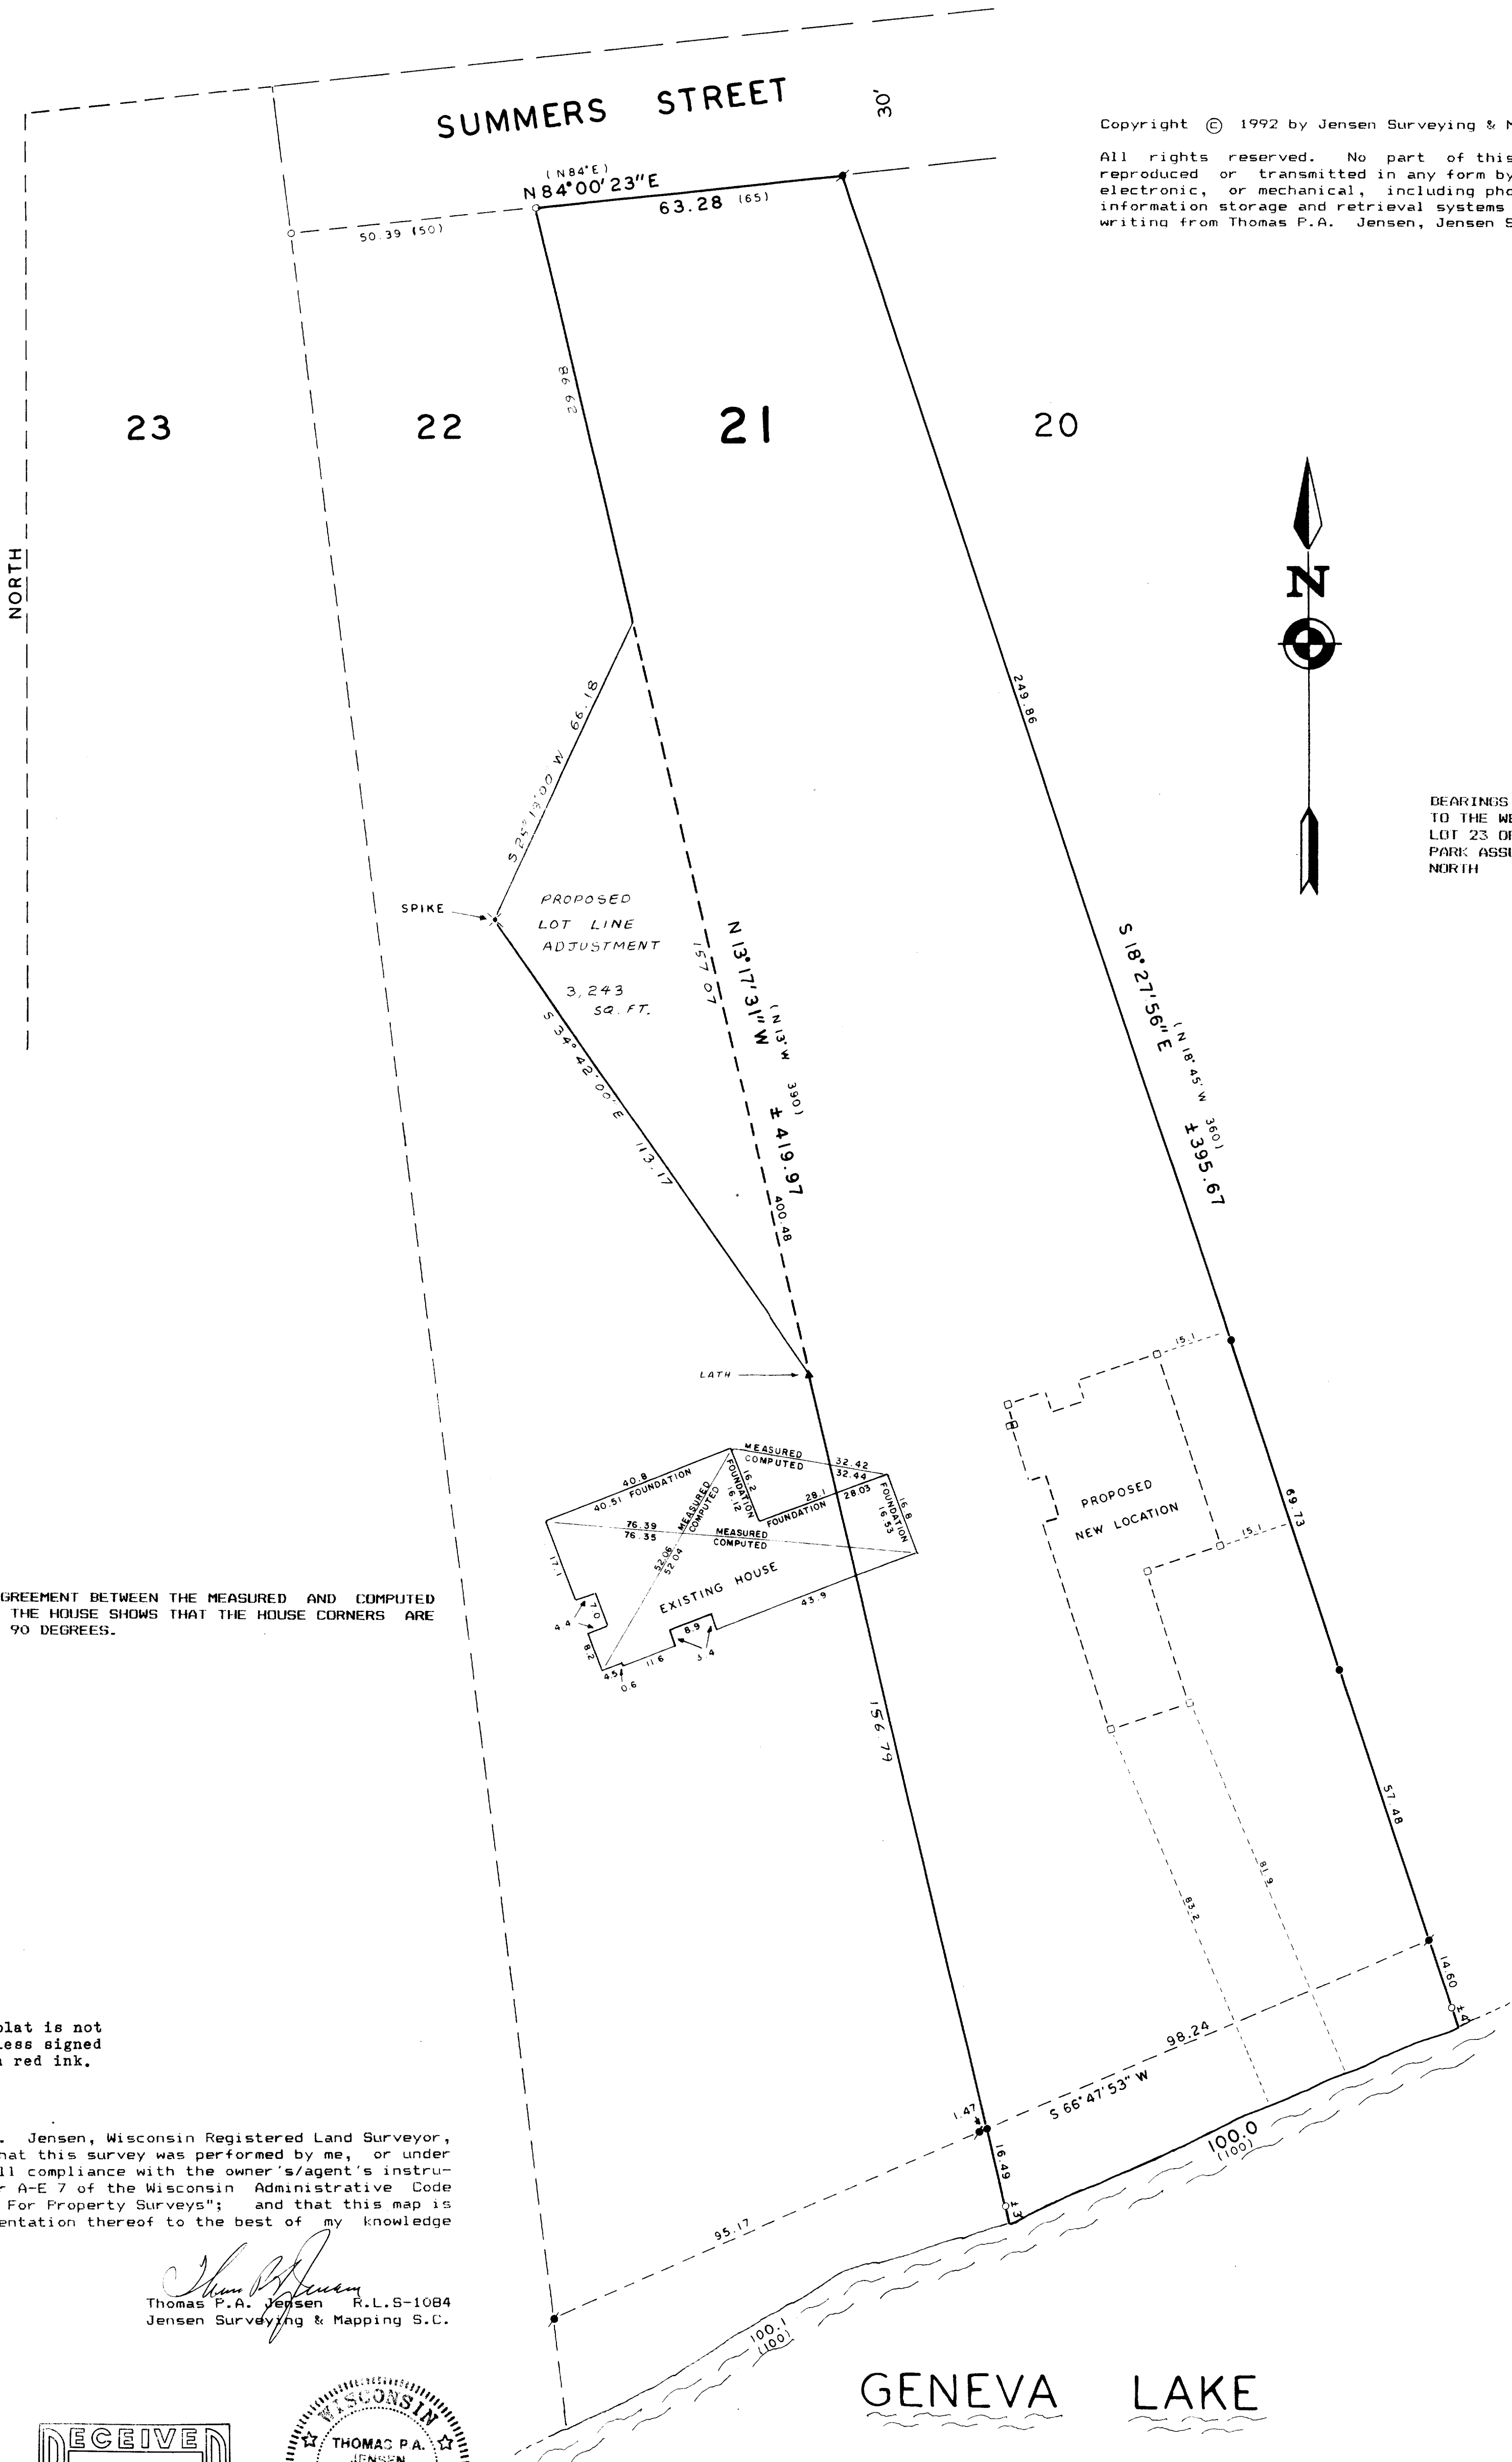


NOTE: THE CLOSE AGREEMENT BETWEEN THE MEASURED AND COMPUTED
DIAGONALS OF THE HOUSE SHOWS THAT THE HOUSE CORNERS ARE
VERY NEARLY 90 DEGREES.

Note: This survey plat is not
certified unless signed
and sealed in red ink.

I, Thomas P.A. Jensen, Wisconsin Registered Land Surveyor,
do hereby certify that this survey was performed by me, or under
my direction, in full compliance with the owner's/agent's instruc-
tions and Chapter A-E 7 of the Wisconsin Administrative Code
"Minimum Standards For Property Surveys"; and that this map is
an accurate representation thereof to the best of my knowledge
and belief.

Thomas P.A. Jensen R.L.S-1084
Jensen Surveying & Mapping S.C.

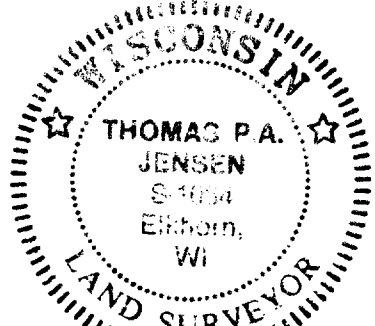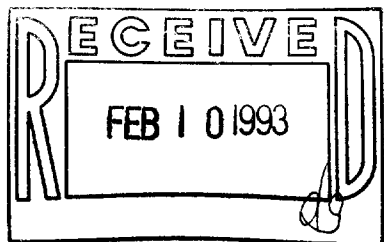

GENEVA LAKE

Sheet no. 1 of 1 Sheets.

Job reference number

1992.043A

IRP-12

Legend


- FOUND IRON PIPE, 1" DIAM.
- FOUND IRON ROD, 3/4" DIAM.
- SET 3/4" X 24" IRON ROD
- SET WOOD STAKE
- () RECORDED DIMENSION

JENSEN SURVEYING & MAPPING S.C.

45 South Wisconsin Street P.O. Box 322
Elkhorn, Wisconsin 53121
(414) 723-3434



Scale: 1" = 20'

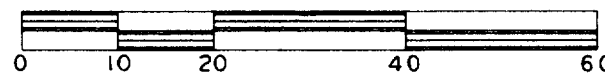

Mapping date: 4-22-1992

Revisions:

117-1240