
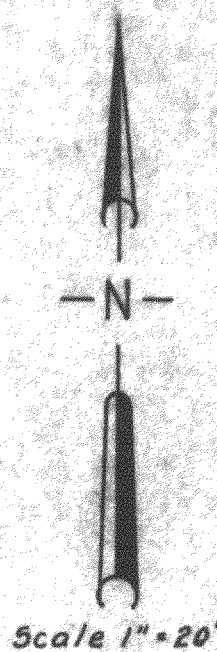


GENEVA LAKE

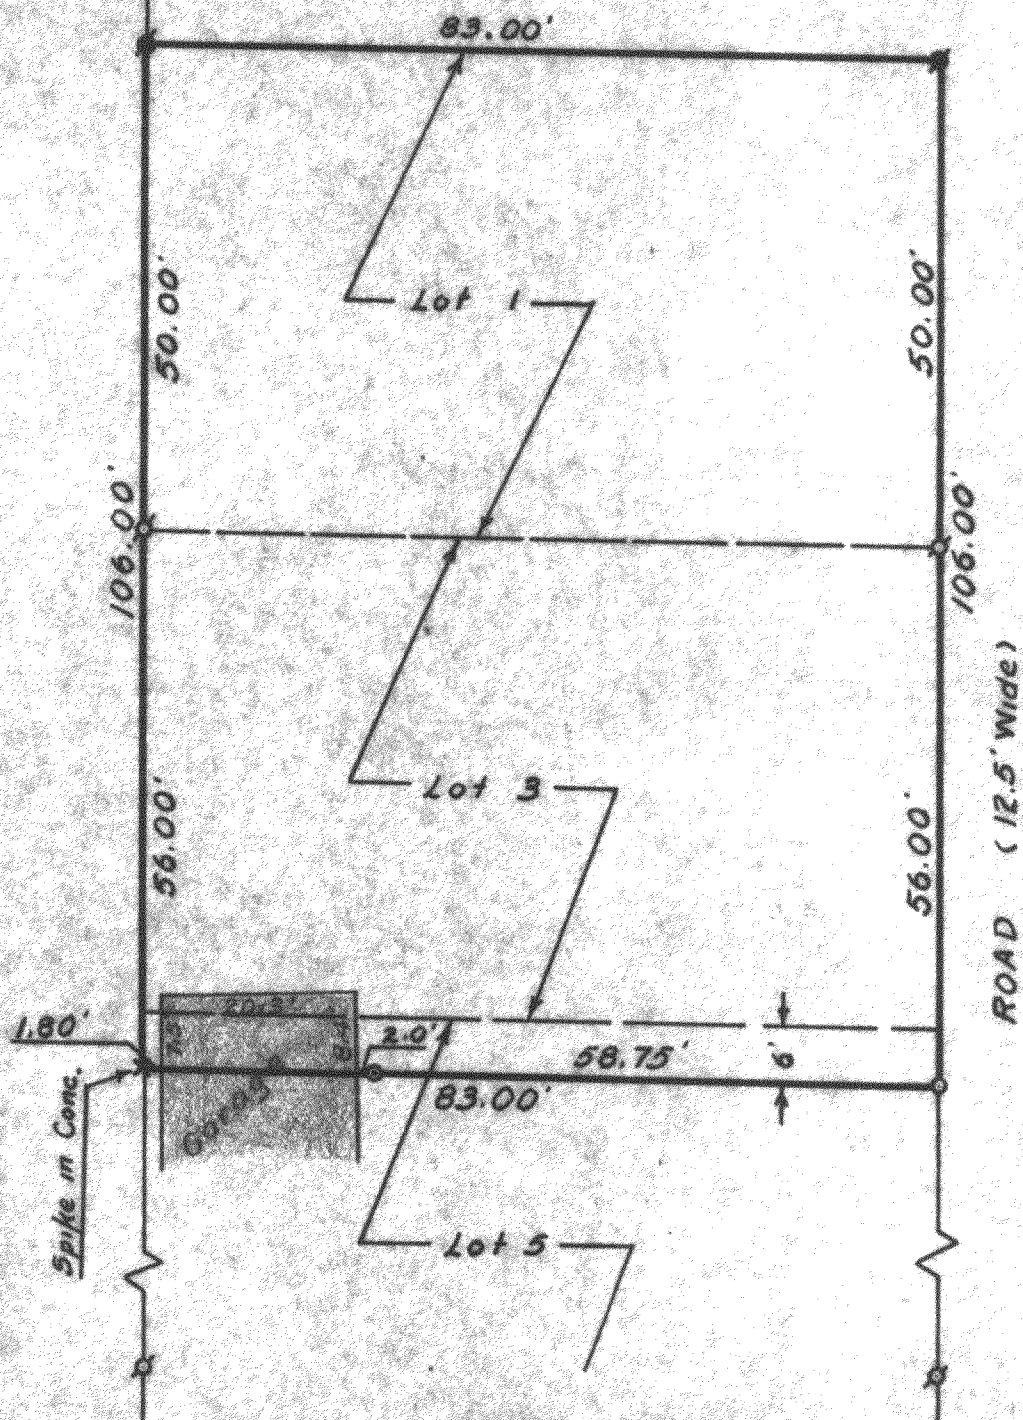

PLAT OF SURVEY OF

Lots 1 and 3, and the North 6 feet of Lot 5,
Lake Geneva Club, a Subdivision located in the
NW 1/4 of Section 18, T1N, R1E, Walworth County
Wisconsin.

Harold H. Kolb

Harold H. Kolb, Wis. Registered Surveyor, S-187
Lake Geneva, Wisconsin.

- - Concrete Monument
- - Railroad Spike
- - Iron pipe found
- - Iron pipe placed

6-26-62

ILGC-1

117-125