


KOLB LAND CONSULTING, INC.  
LAND SURVEYING · SUBDIVIDING · LAND PLANNING

929 WILLIAMS STREET

LAKE GENEVA, WISCONSIN 53147

414-248-3697

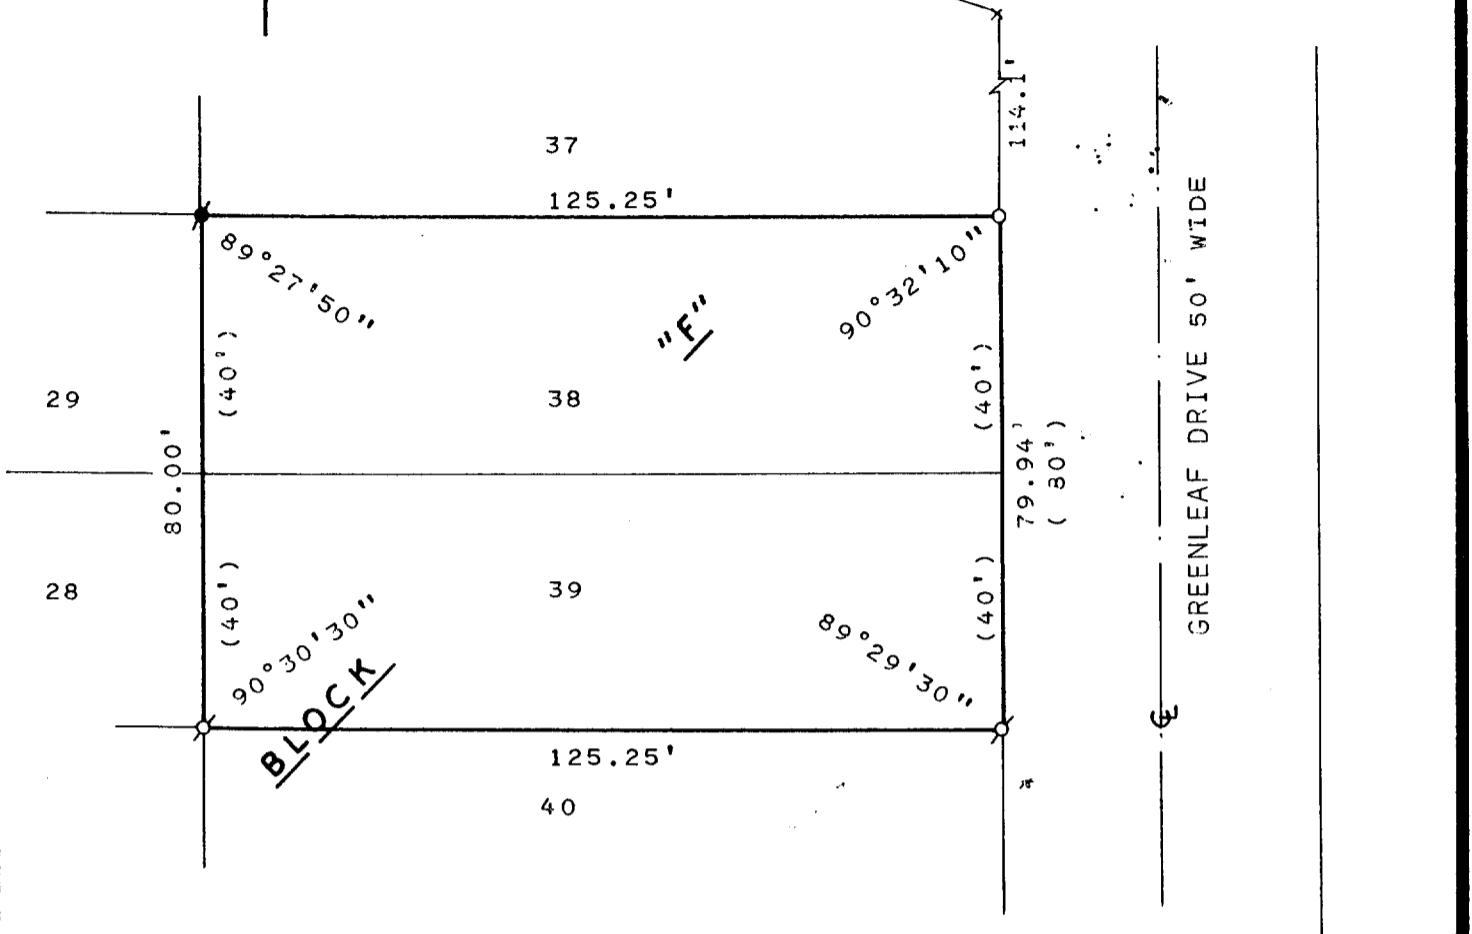


PLAT OF SURVEY OF

LOTS 38 AND 39, BLOCK "F" OF CISCO BEACH  
SUBDIVISION, LOCATED IN T1N, R17E, TOWN OF  
LINN, WALWORTH COUNTY, WISCONSIN.

ORDERED BY: STEVEN GELLER  
5810 S. NORMANDY  
CHICAGO, IL. 60638

NOTE: FOUND REMAINS OF OLD  
FOUNDATION ON LOT.

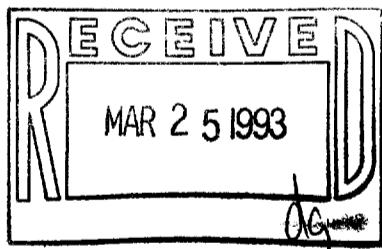

SCALE: 1" = 30'

LEGEND  
 ⚡ - IRON PIPE FOUND  
 ○ - IRON PIPE SET  
 ⚡ - CONC. MONUMENT FOUND  
 (80') - AS RECORDED  
 x - FOUND SPIKE

101-138  
101-139

I HEREBY CERTIFY THAT I HAVE SURVEYED THE  
ABOVE DESCRIBED PROPERTY AND THAT THE ABOVE  
MAP IS A TRUE REPRESENTATION THEREOF AND  
SHOWS THE SIZE AND LOCATION OF THE PROPERTY,  
ITS EXTERIOR BOUNDARIES, THE LOCATION OF ALL  
VISIBLE STRUCTURES AND DIMENSIONS OF ALL  
PRINCIPAL BUILDINGS THEREON, BOUNDARY FENCES,  
APPARENT EASEMENTS, ROADWAYS AND VISIBLE  
ENCROACHMENTS, IF ANY, TO THE BEST OF MY  
KNOWLEDGE AND BELIEF.

THIS SURVEY IS MADE FOR THE USE OF THE  
PRESENT OWNERS OF THE PROPERTY, AND ALSO  
THOSE WHO PURCHASE, MORTGAGE, OR GUARANTEE  
THE TITLE THERETO WITHIN ONE (1) YEAR FROM  
DATE HEREOF. THIS SURVEY IS NOT VALID UNLESS  
THE SURVEYOR'S SIGNATURE IS IN RED,

HAROLD H. KOLB

WISCONSIN REGISTERED LAND SURVEYOR, S-187  
DATE JUNE 10, 1992

REVISED \_\_\_\_\_

REVISED \_\_\_\_\_

117-1291