


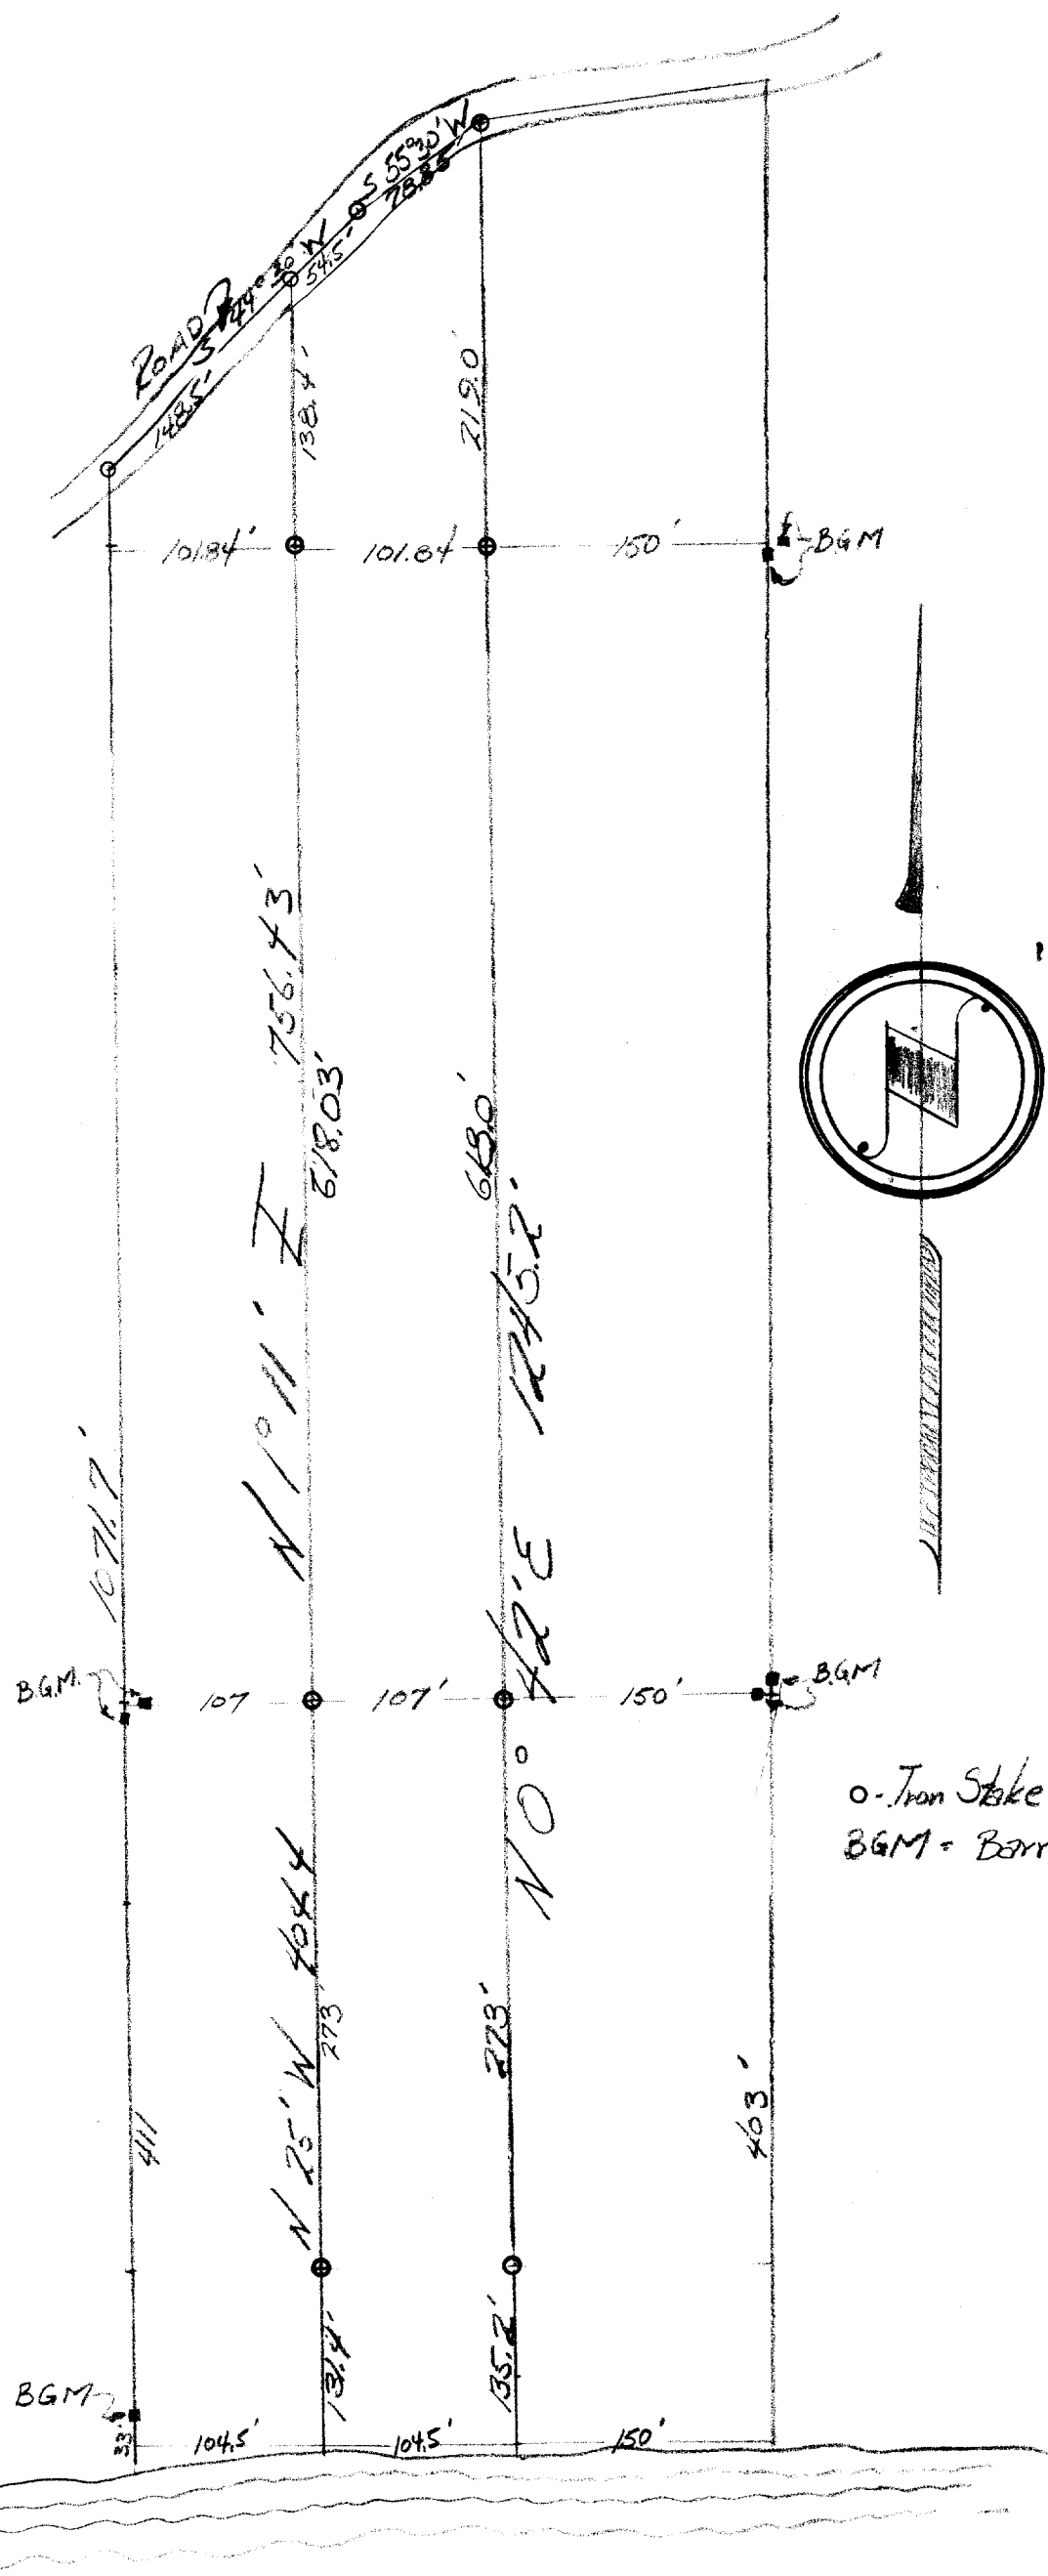


DESCRIPTION: Commencing at a point that is 104.5 feet easterly of the intersection of the West line of "The Folly" subdivision and the shoreline of Lake Geneva thence running $N 0^{\circ} 25' W$ 404.4 feet to an iron stake; thence $N 1^{\circ} 11' E$ 756.43 feet to an iron stake; thence $N 44^{\circ} 30' E$ 54.5 feet to an iron stake; thence $N 55^{\circ} 30' E$ 75.85 feet to an iron stake; thence $S 0^{\circ} 42' W$ 1245.2 feet to the shoreline of said lake; thence westerly along said shoreline 104.5 feet to the place of beginning. (The Folly being a subdivision of part of section 3 of Town 1 North, Range 17 East, Walworth County, Wisconsin.

CERTIFICATE: I hereby certify, that I have on this 1st day of October surveyed the above described property, and the drawing shown hereon is a correct representation of the boundaries of said property.

SIGNED AND SEALED

James F. Biagi
and Surveyor

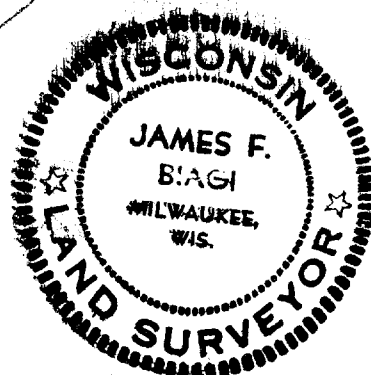

o - Iron Stake
BGM - Barre Granite Monument

LAKE GENEVA

In a subd. The Folly + Bonnie Bass

BB-4

"

5

5A

F-1

F-1A

F-1A1