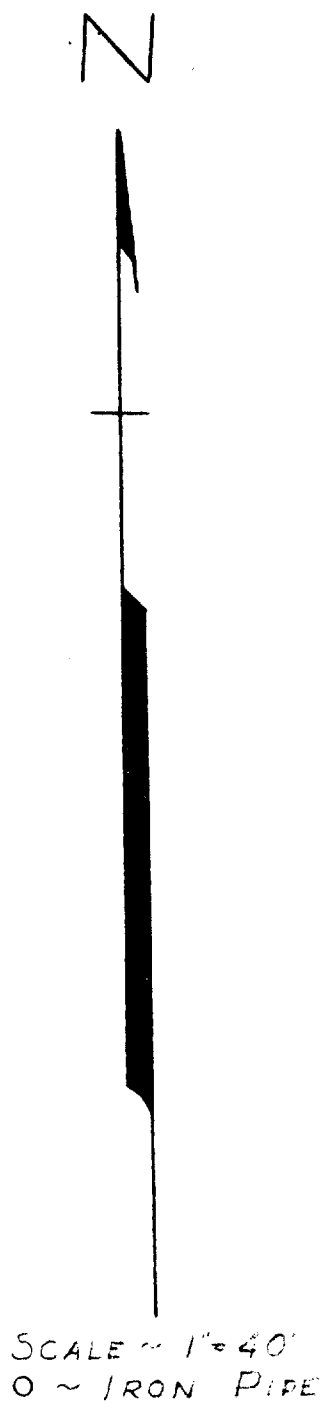


STATE OF WISCONSIN } ss.
WALWORTH COUNTY }

I, GEORGE T. DUNHAM, DO HEREBY CERTIFY
THAT I HAVE SURVEYED THE PROPERTY DESCRIBED
AS FOLLOWS:

LOT 10 OF THE BIRCHES, A SUBDIVI-
SION LOCATED IN THE NORTHWEST 1/4
OF SECTION 10, T19R17E, WALWORTH
COUNTY, WISCONSIN.

AND THAT THE PLAT SHOWN IS A CORRECT
REPRESENTATION OF THE PROPERTY LINES AND
THE IMPROVEMENTS LOCATED THEREON.
JUNE 18, 1958

George T. Dunham
GEORGE T. DUNHAM, SURVEYOR
DELAVER, WISCONSIN