


**ABELL
SURVEYING & MAPPING
DELAVER, WISCONSIN 53115
414-728-6737**

found iron pipe 0.19' east
of corner on line.

IRON PIPE MISSING 5/19/93
SET IRON ROD AT SAME
LOCATION.

corner falls 0.3' east of
iron fence corner post set
in concrete.


corner falls under stone
pillar.

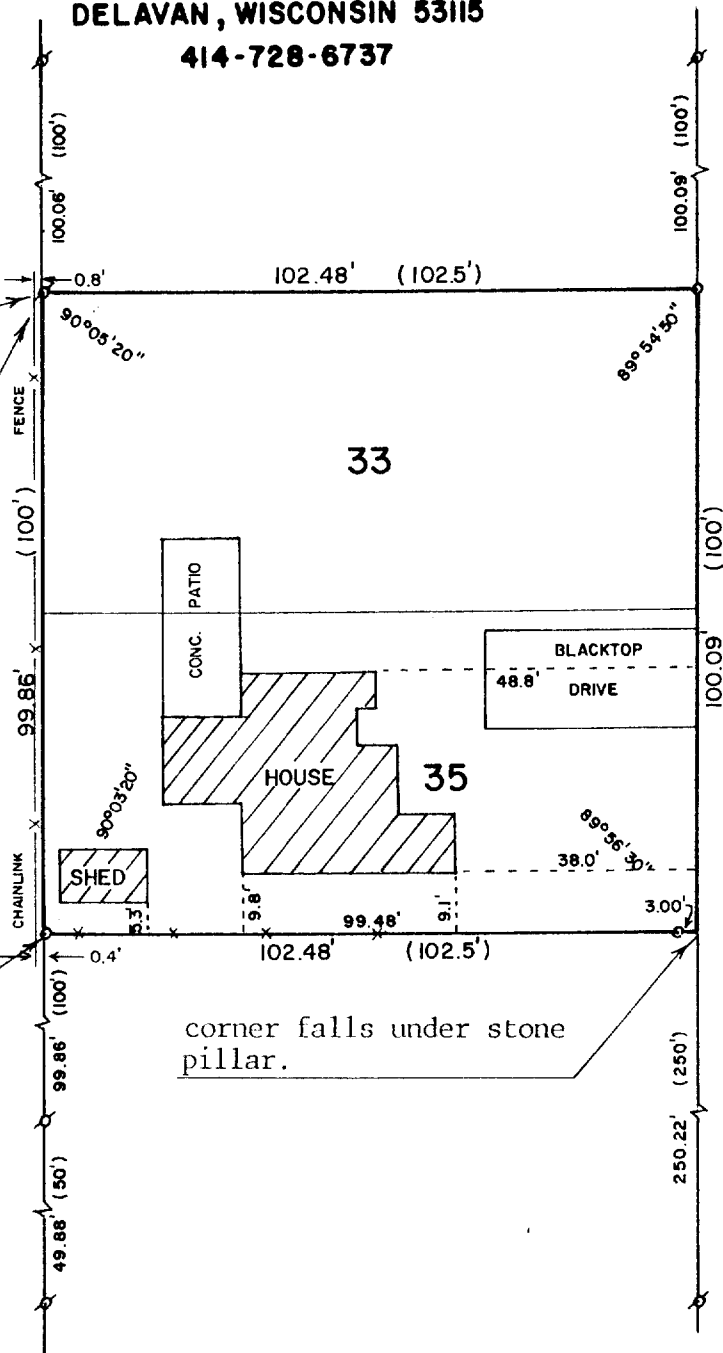

PLAT OF SURVEY OF

LOTS 33 AND 35 OF SHORE HAVEN, A SUBDIVISION
LOCATED IN T1N,R17E, WALWORTH COUNTY,
WISCONSIN.

ORDERED BY: DAVID PLUMMER
858 SADDLEWOOD
GLEN ELLYN, IL 60137

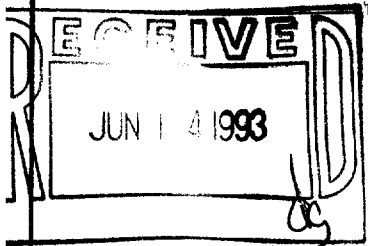

SCALE - 1"=30'

LEGEND

- ⊙ - IRON PIPE FOUND
- - IRON PIPE SET FOUND 5/19/93
- () - RECORDED AS

I, DAVID F. ABELL, DO HEREBY CERTIFY
THAT I HAVE SURVEYED THE PROPERTY
HEREON DESCRIBED ACCORDING TO THE
OFFICIAL RECORDS AND THAT THE PLAT
HEREON IS A CORRECT REPRESENTATION
OF THE PROPERTY LINES TO THE BEST OF
MY KNOWLEDGE AND BELIEF.

David F. Abell

DAVID F. ABELL
WISCONSIN REGISTERED LAND SURVEYOR, S-1596

DATE June 16, 1987 REVISED: 5/30/93
JOB NUMBER - 87074

NOTE: THIS IS NOT A CERTIFIED COPY UNLESS SEALED.

ISA-34

117-1316