

N

**SURVEYING & SUBDIVIDING
DELAN, WISCONSIN**

Scale - 1" = 20'

○ = Iron Pipe

⦿ = Iron Pin

Found Iron Pin, and replaced
with 3/4" Iron Pipe 3/23/93

LOT 7

LOT 6

0.80 Acre

LOT 5


LOT 4

Plat of survey of Lots 4, 5, 6 and 7 in Block 8 of Wooddale Addition located in Sections 9 and 16, T 1 N, R 17 E, Walworth County, Wisconsin.
February 7, 1973

George T. Dunham, Surveyor

All Iron Pipes and Iron Pins relocated 3/23/93
Updated and recertified to be correct this
23 day of March, 1993

George T. Dunham, Surveyor

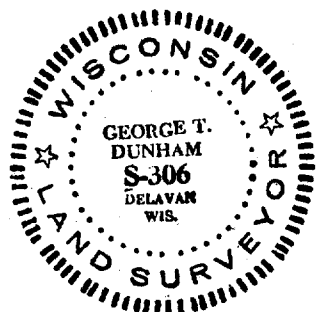

Iw-57B

117-1325 117-100