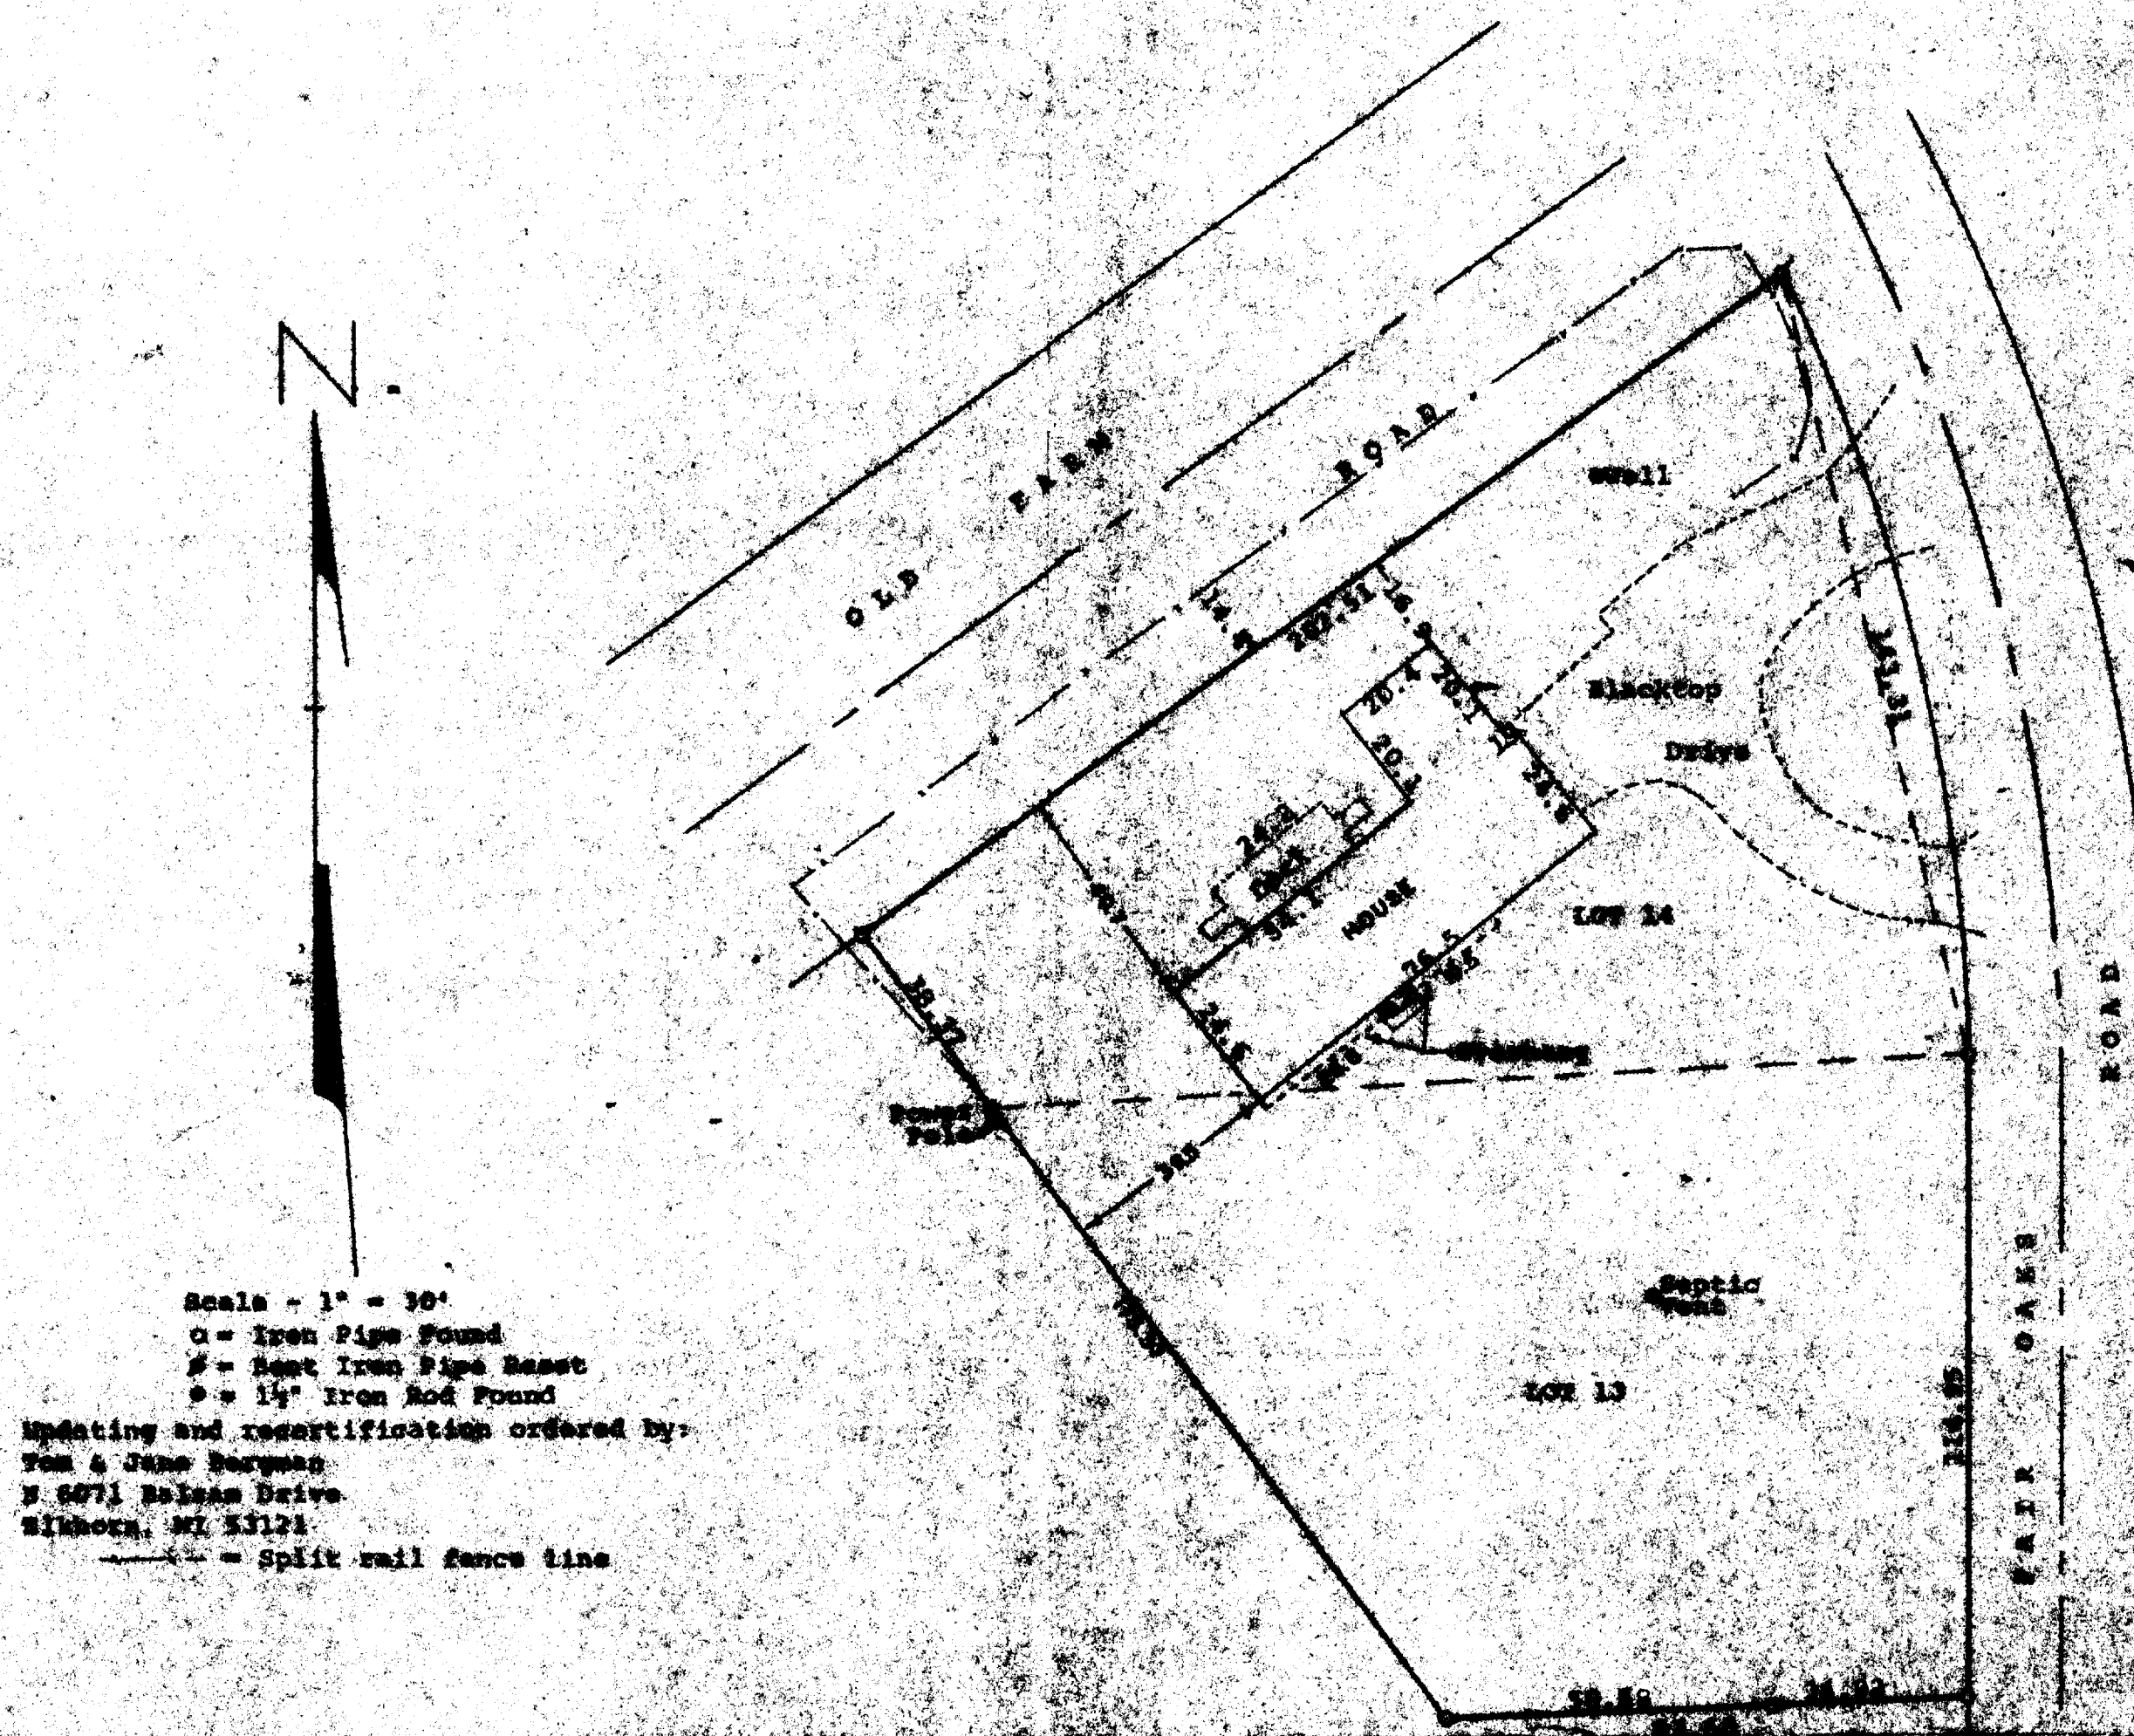


DELAWARE WISCONSIN 53115

[illegible]