




N

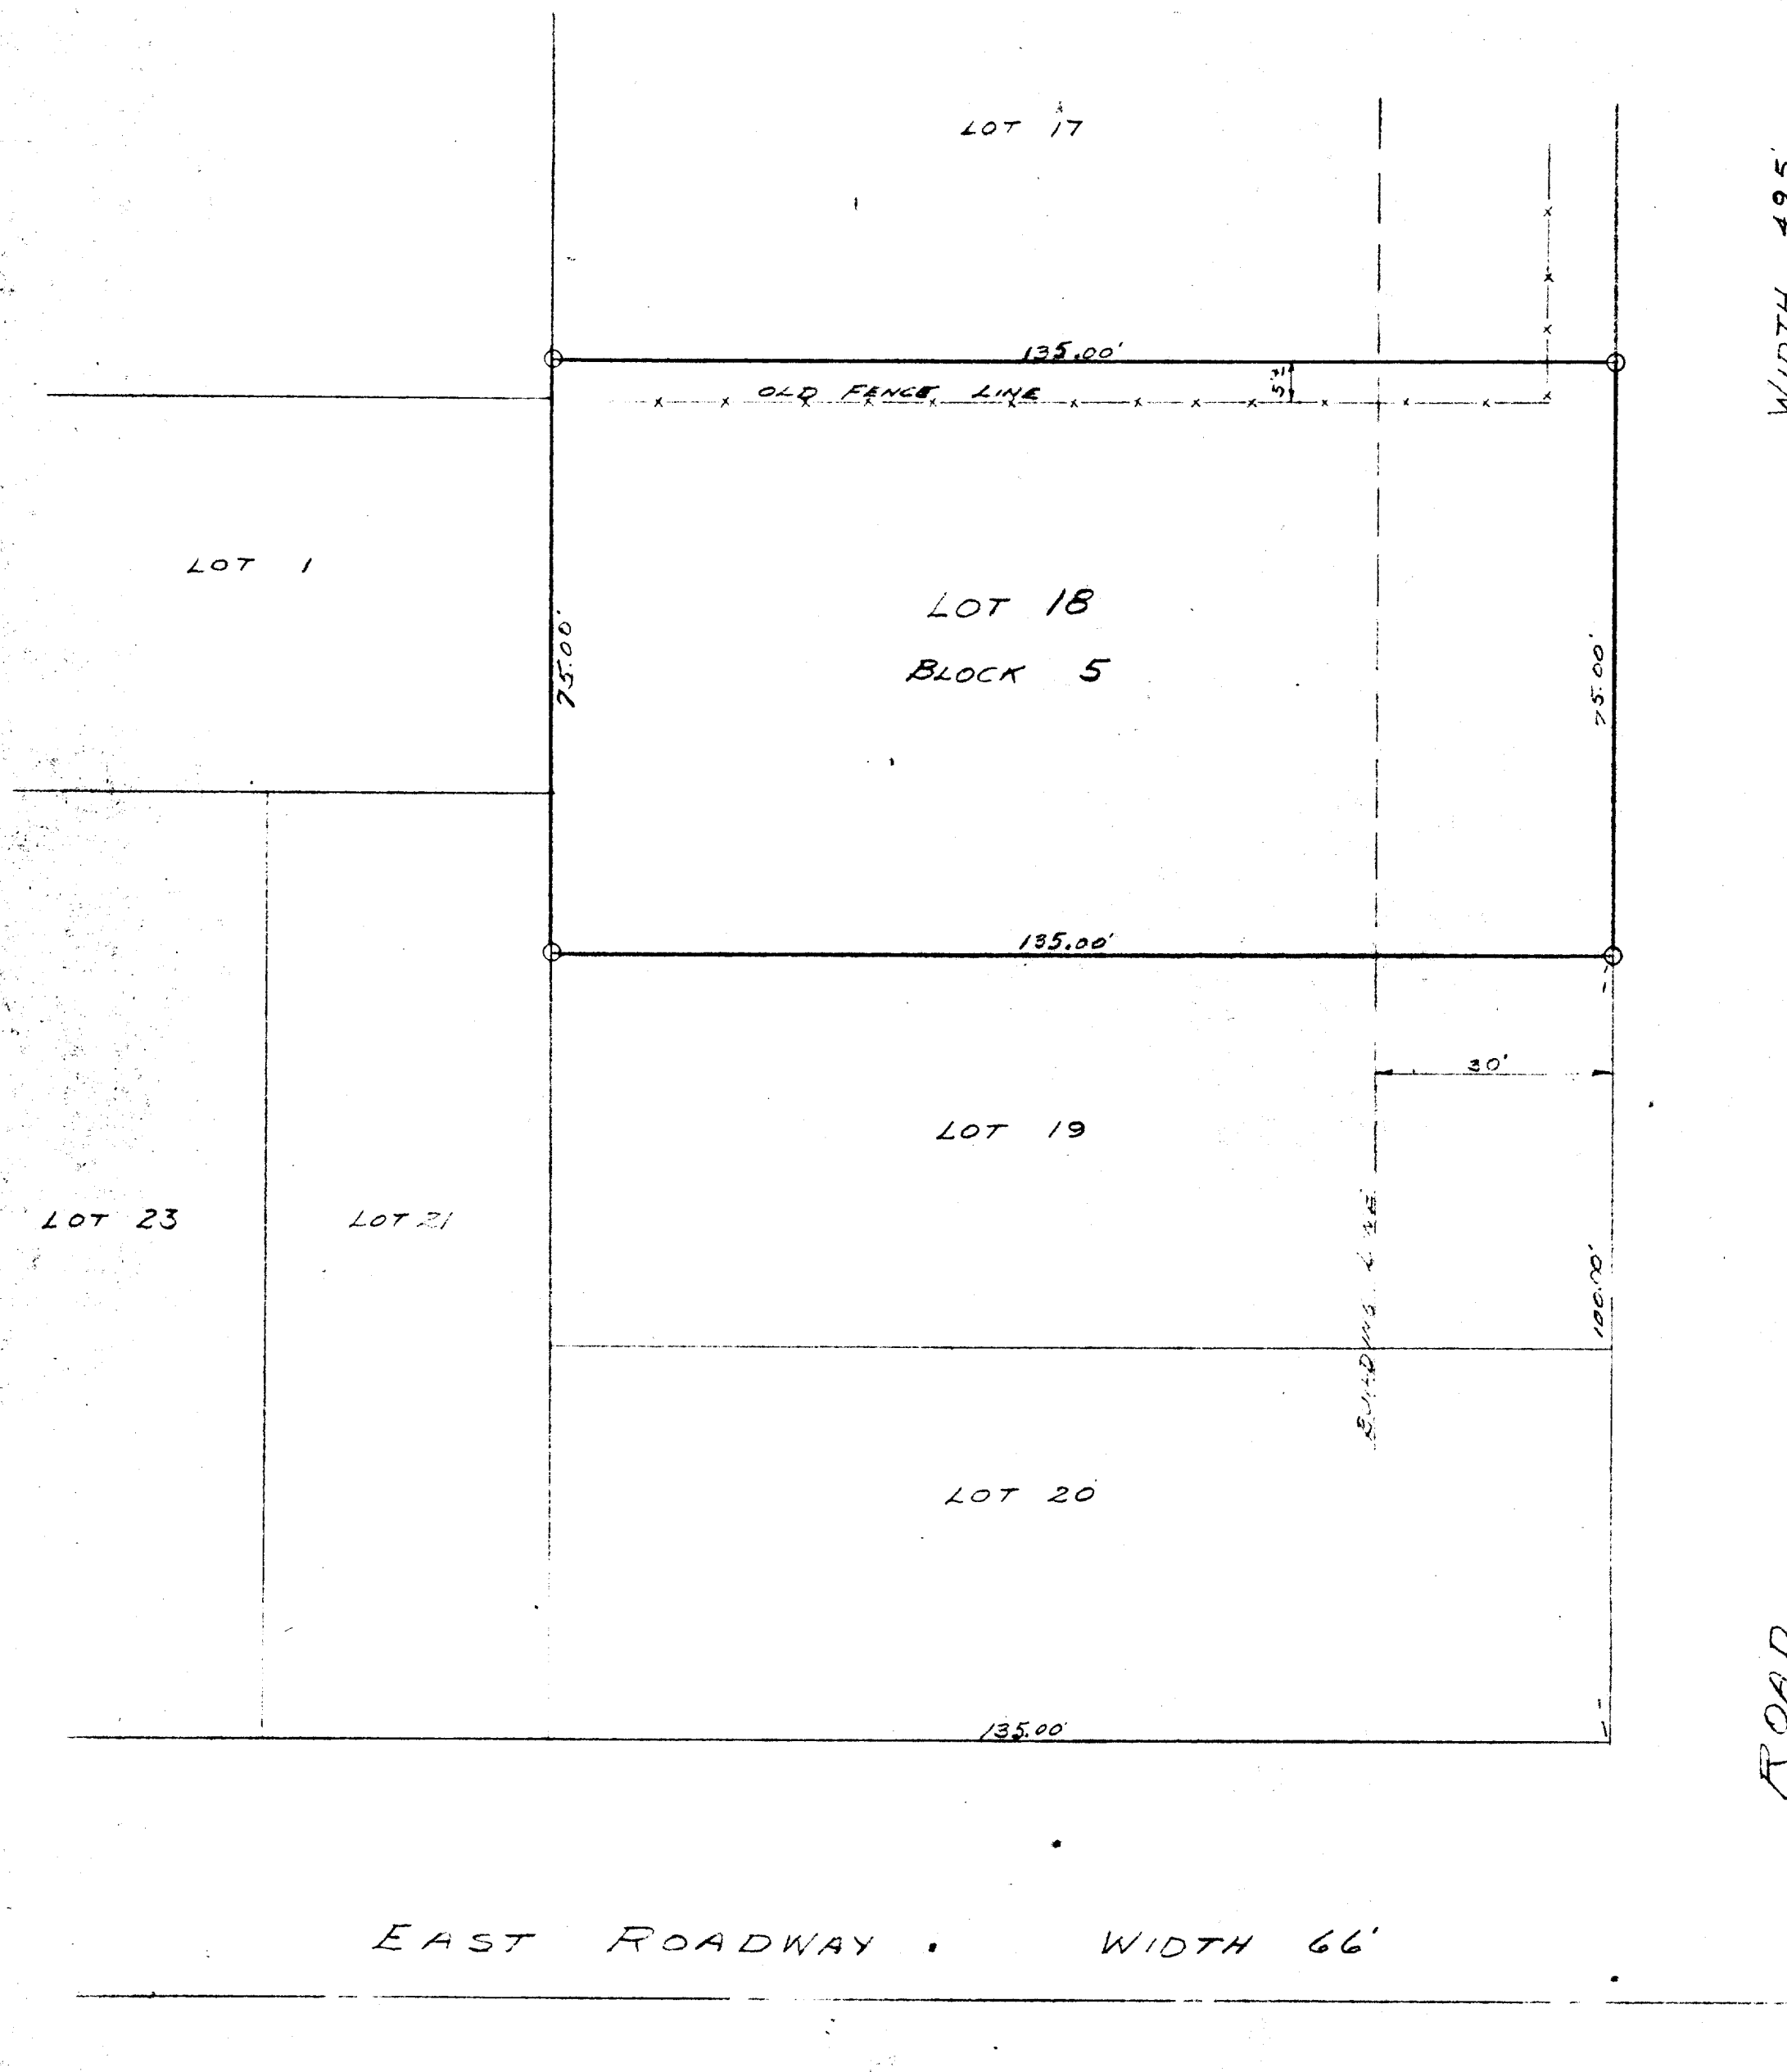

O - IRON PIPE

PLAT OF SURVEY OF

LOT 18 BLOCK 5 OF THE
SUNSET HILLS SUBD. SECTION 4
T14N R17E WALWORTH COUNTY
WISCONSIN

Boyd L. Jensen
SURVEYOR

SHEET - 20

DATE MAY 3, 1952

117-1831