

FARRIS, HANSEN & ASSOCIATES, INC.

7 RIDGEWAY COURT, P.O. BOX 437
ELKHORN, WISCONSIN 53121


PLAT OF SURVEY

PHONE: (414) 723-2008
FAX: (414) 723-6888


LOCATION: LOTS 44 AND 45 OF BLOCK J
CISCO BEACH SUBDIVISION
SEC. 5, T. 1 N., R. 17 E.
WALWORTH COUNTY, WI

WORK ORDERED BY: THOMAS GUDGEON
PO BOX 1211
LOMBARD, IL.

MAP LEGEND
 • IRON PIPE STAKE FOUND
 • IRON PIPE STAKE SET
 • IRON ROD STAKE FOUND
 • IRON ROD STAKE SET
 • CONCRETE MONUMENT FOUND
 • RECORD DIMENSION
 (XXXXX)

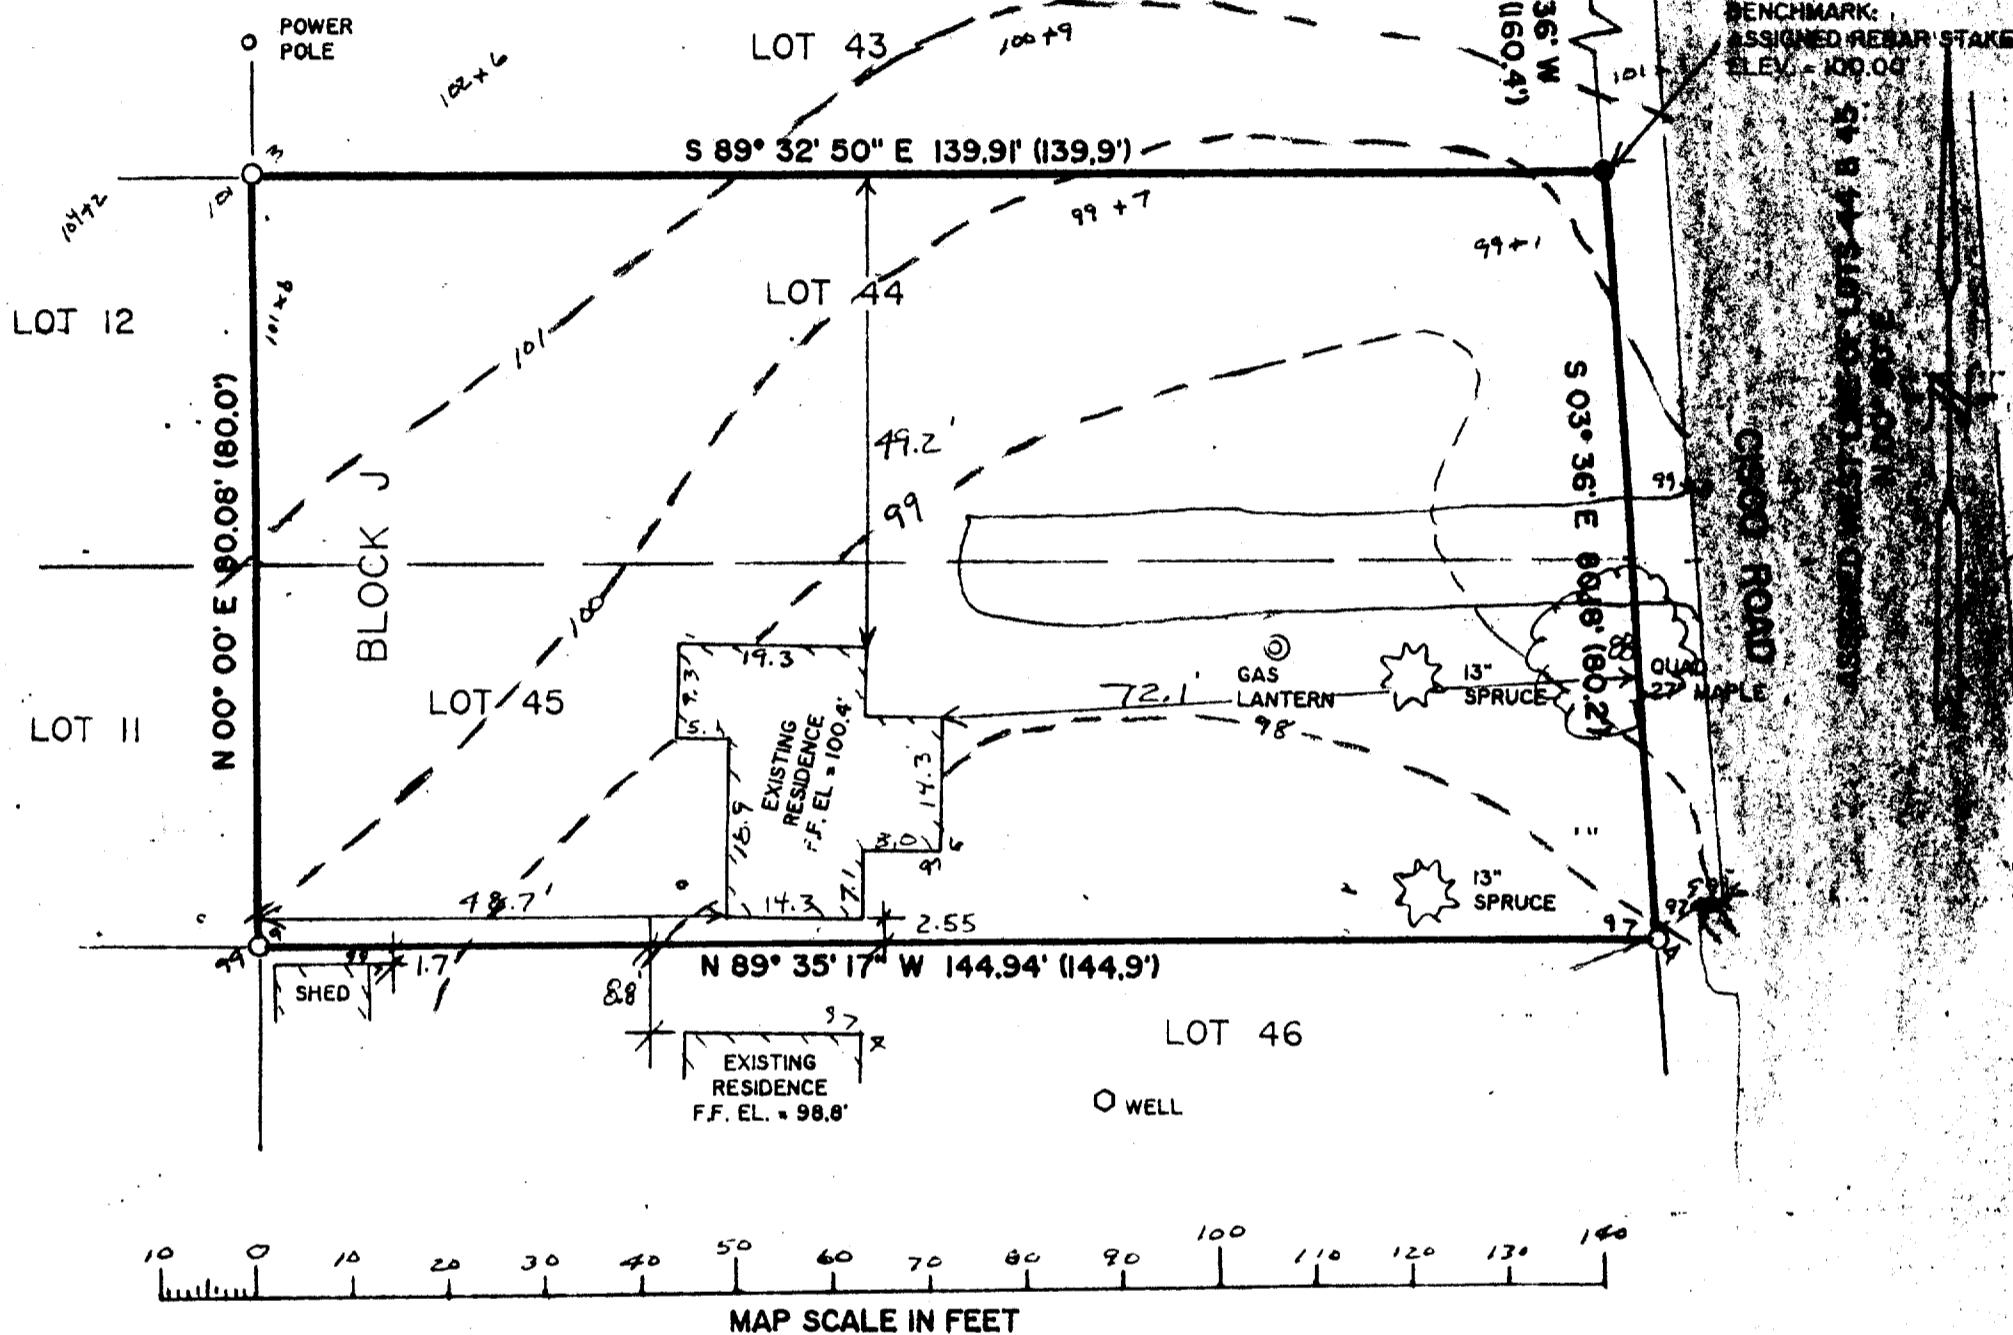

VERTICAL DATUM:
ASSIGNED REBAR STAKE SET AT
NE CORNER
ELEV. = 100.00'

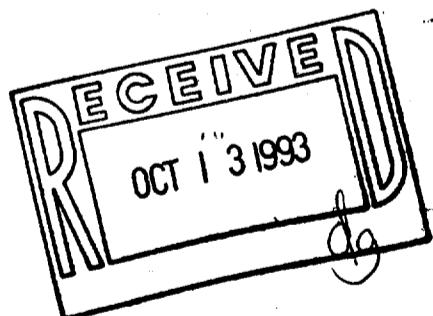

NOTE: COPIES OF THIS MAP TO WHICH THE FOLLOWING CERTIFICATE WILL
APPLY ARE BLUE LINE PRINTS SHOWING SURVEYOR'S ORIGINAL SEAL AND
SIGNATURE IN BLACK INK. COPIES BY ANY OTHER MEANS MAY HAVE
ALTERATIONS WHICH DO NOT REPRESENT THE SURVEYOR'S WORK PRODUCT.

I HEREBY CERTIFY THAT THIS PLAT OF SURVEY IS A TRUE AND ACCURATE
REPRESENTATION OF THE BOUNDARY LINES OF THE SUBJECT PARCEL AND OF
THE EXISTING PHYSICAL FEATURES OF THE PARCEL SHOWN HEREON TO THE
BEST OF MY KNOWLEDGE AND BELIEF. THIS SURVEY IS MADE FOR THE USE OF
THE PRESENT OWNERS OF THE PROPERTY, AND ALSO THOSE WHO PURCHASE,
MORTGAGE, OR GUARANTEE THE TITLE THERETO WITHIN ONE YEAR FROM THE
DATE HEREOF.

DATED: 08/17/93

Peter S. Gordon
PETER S. GORDON RLS 2101

