
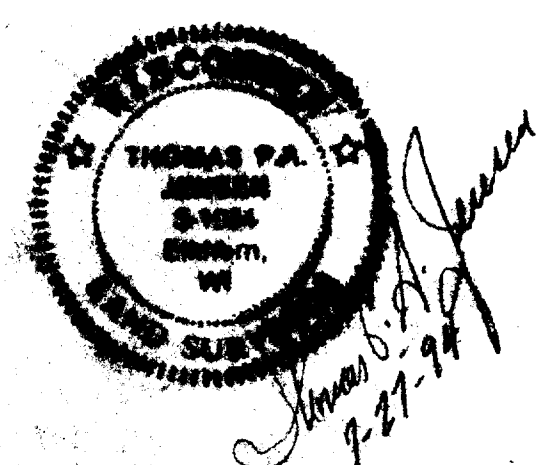


EAST 1/4 SECTION COR.
SEC. 11, T.1N., R.17E.
COUNTY MONUMENT

BEARINGS FROM MAGNETIC NORTH

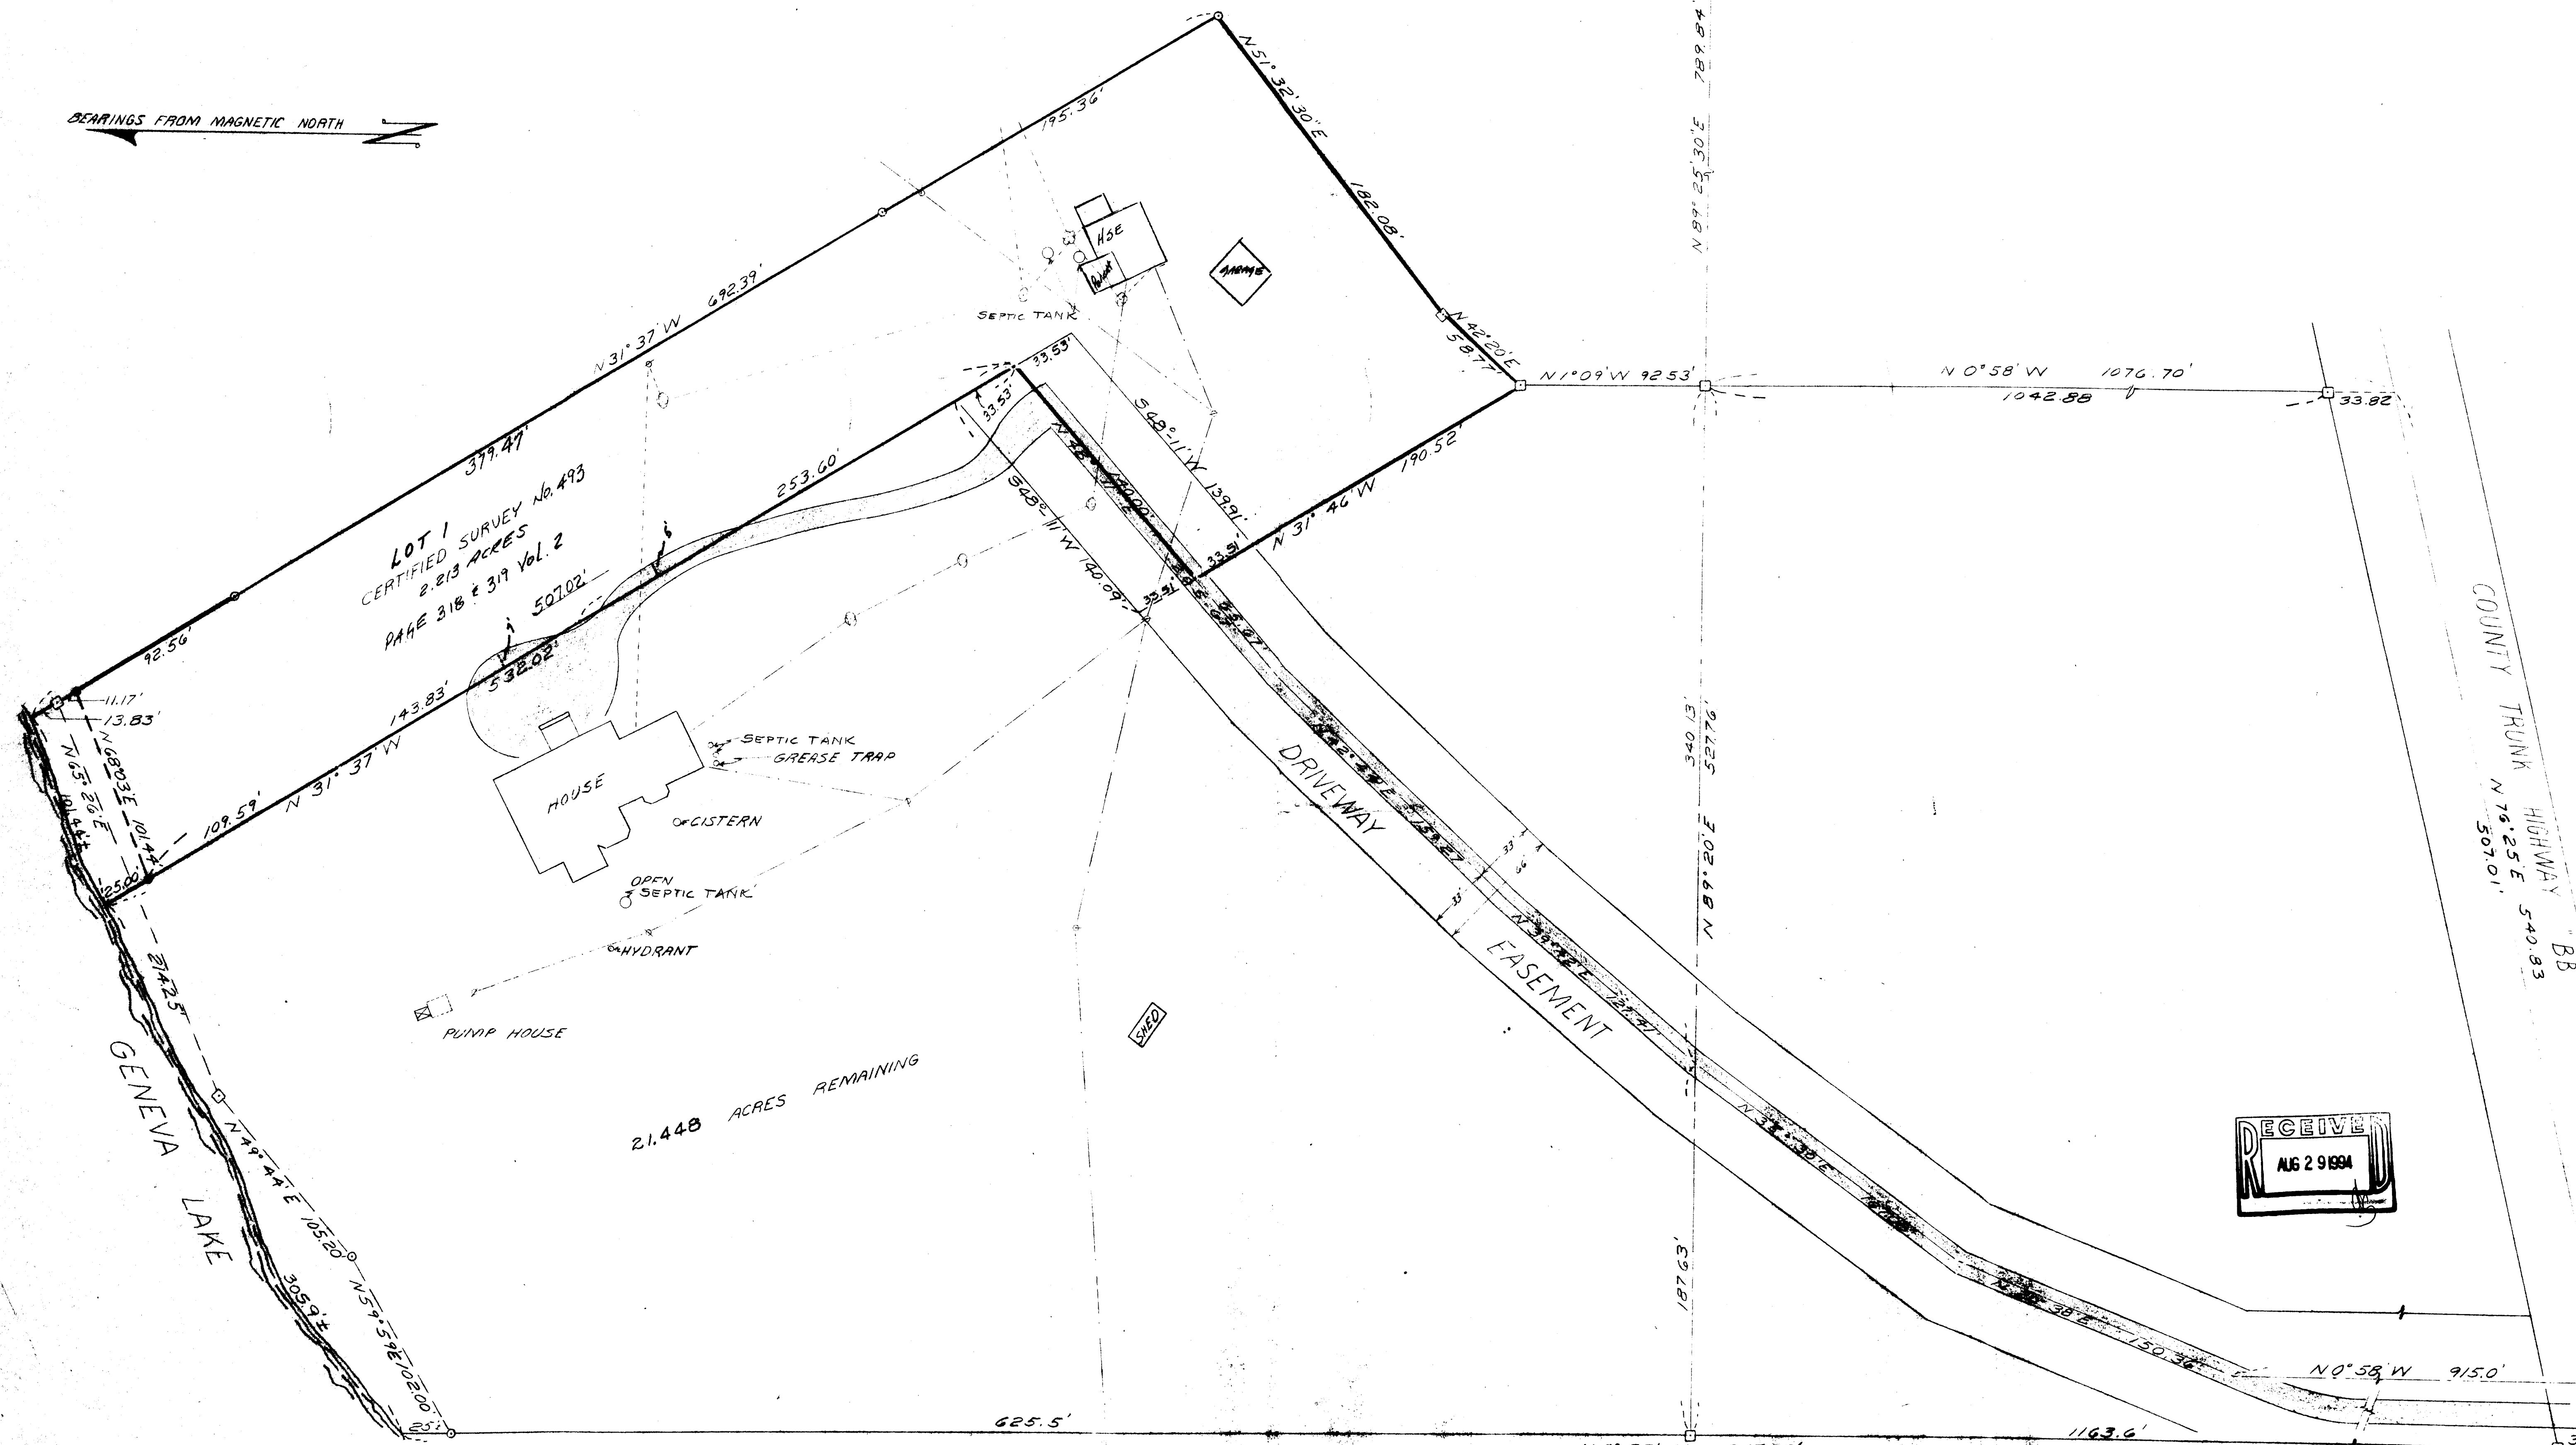

I, LLOYD L. JENSEN DO HEREBY CERTIFY THAT I HAVE SURVEYED THE PROPERTY SHOWN HERE IN, WHICH IS NOW OWNED OR WILL BE OWNED BY WILLIAM BELL AND WARREN AND JANE SHOEMAKER, THAT ALL BUILDINGS ARE SHOWN AND THEIR CORRECT LOCATION IN RELATION TO PROPERTY LINES; THAT ALL UNDERGROUND CONSTRUCTION IS SHOWN THAT CAN BE CORRECTLY LOCATED; THAT NO RECORDED EASEMENTS WERE FOUND IN THE COUNTY RECORDS; THAT DRIVES ON THE PROPERTIES AS NOW USED AND CONSTRUCTED AS SHOWN.


DATED: MAY 29, 1975

Lloyd L. Jensen
SURVEYOR

I, CERTIFY THAT I HAVE RESURVEYED LOT 1 COM No. 493 IN FULL COMPLIANCE WITH CHAPTER A-E 7 OF WIS. ADM. CODE & THAT THIS MAP IS AN ACCURATE REPRESENTATION THEREOF TO THE BEST OF MY KNOWLEDGE & BELIEF

DATED: JULY 26, 1975

Lloyd L. Jensen
SURVEYOR

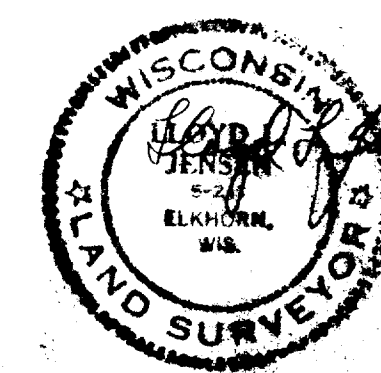

UTILITY POLE
TREE
ELECTRIC POWER LINES
TELEPHONE LINES
1/4" DIA. X 90' SOLID IRON ROD FOUND
1/4" DIA. X 90' SOLID IRON ROD FOUND
5" X 5" CONCRETE FOUNDATION WITH
IRON CENTER FOUND.

RESURVEY: JENSEN SURVEYING, MAPING
PO BOX 322
ELKHORN, WI 53121
414-783-3494

PLAT OF SURVEY OF SHOEMAKER PROPERTY			
A PARCEL OF LAND LOCATED IN THE E 1/2 SEC. 11, T.1N., R.17E., WALWORTH CO. WIS.			
DRAWN BY A.A.F.	JENSEN & JOHNSON CIVIL ENGINEERS ELKHORN, WIS.	SCALE: 1/4" = 40 FEET	REVISION 7-82-14
CHECKED BY		SHEET NO. OF	
APPROVED BY		DATE MAY 1975	