



ABELL
SURVEYING & MAPPING
DELAVER, WISCONSIN 53115
414-728-6737

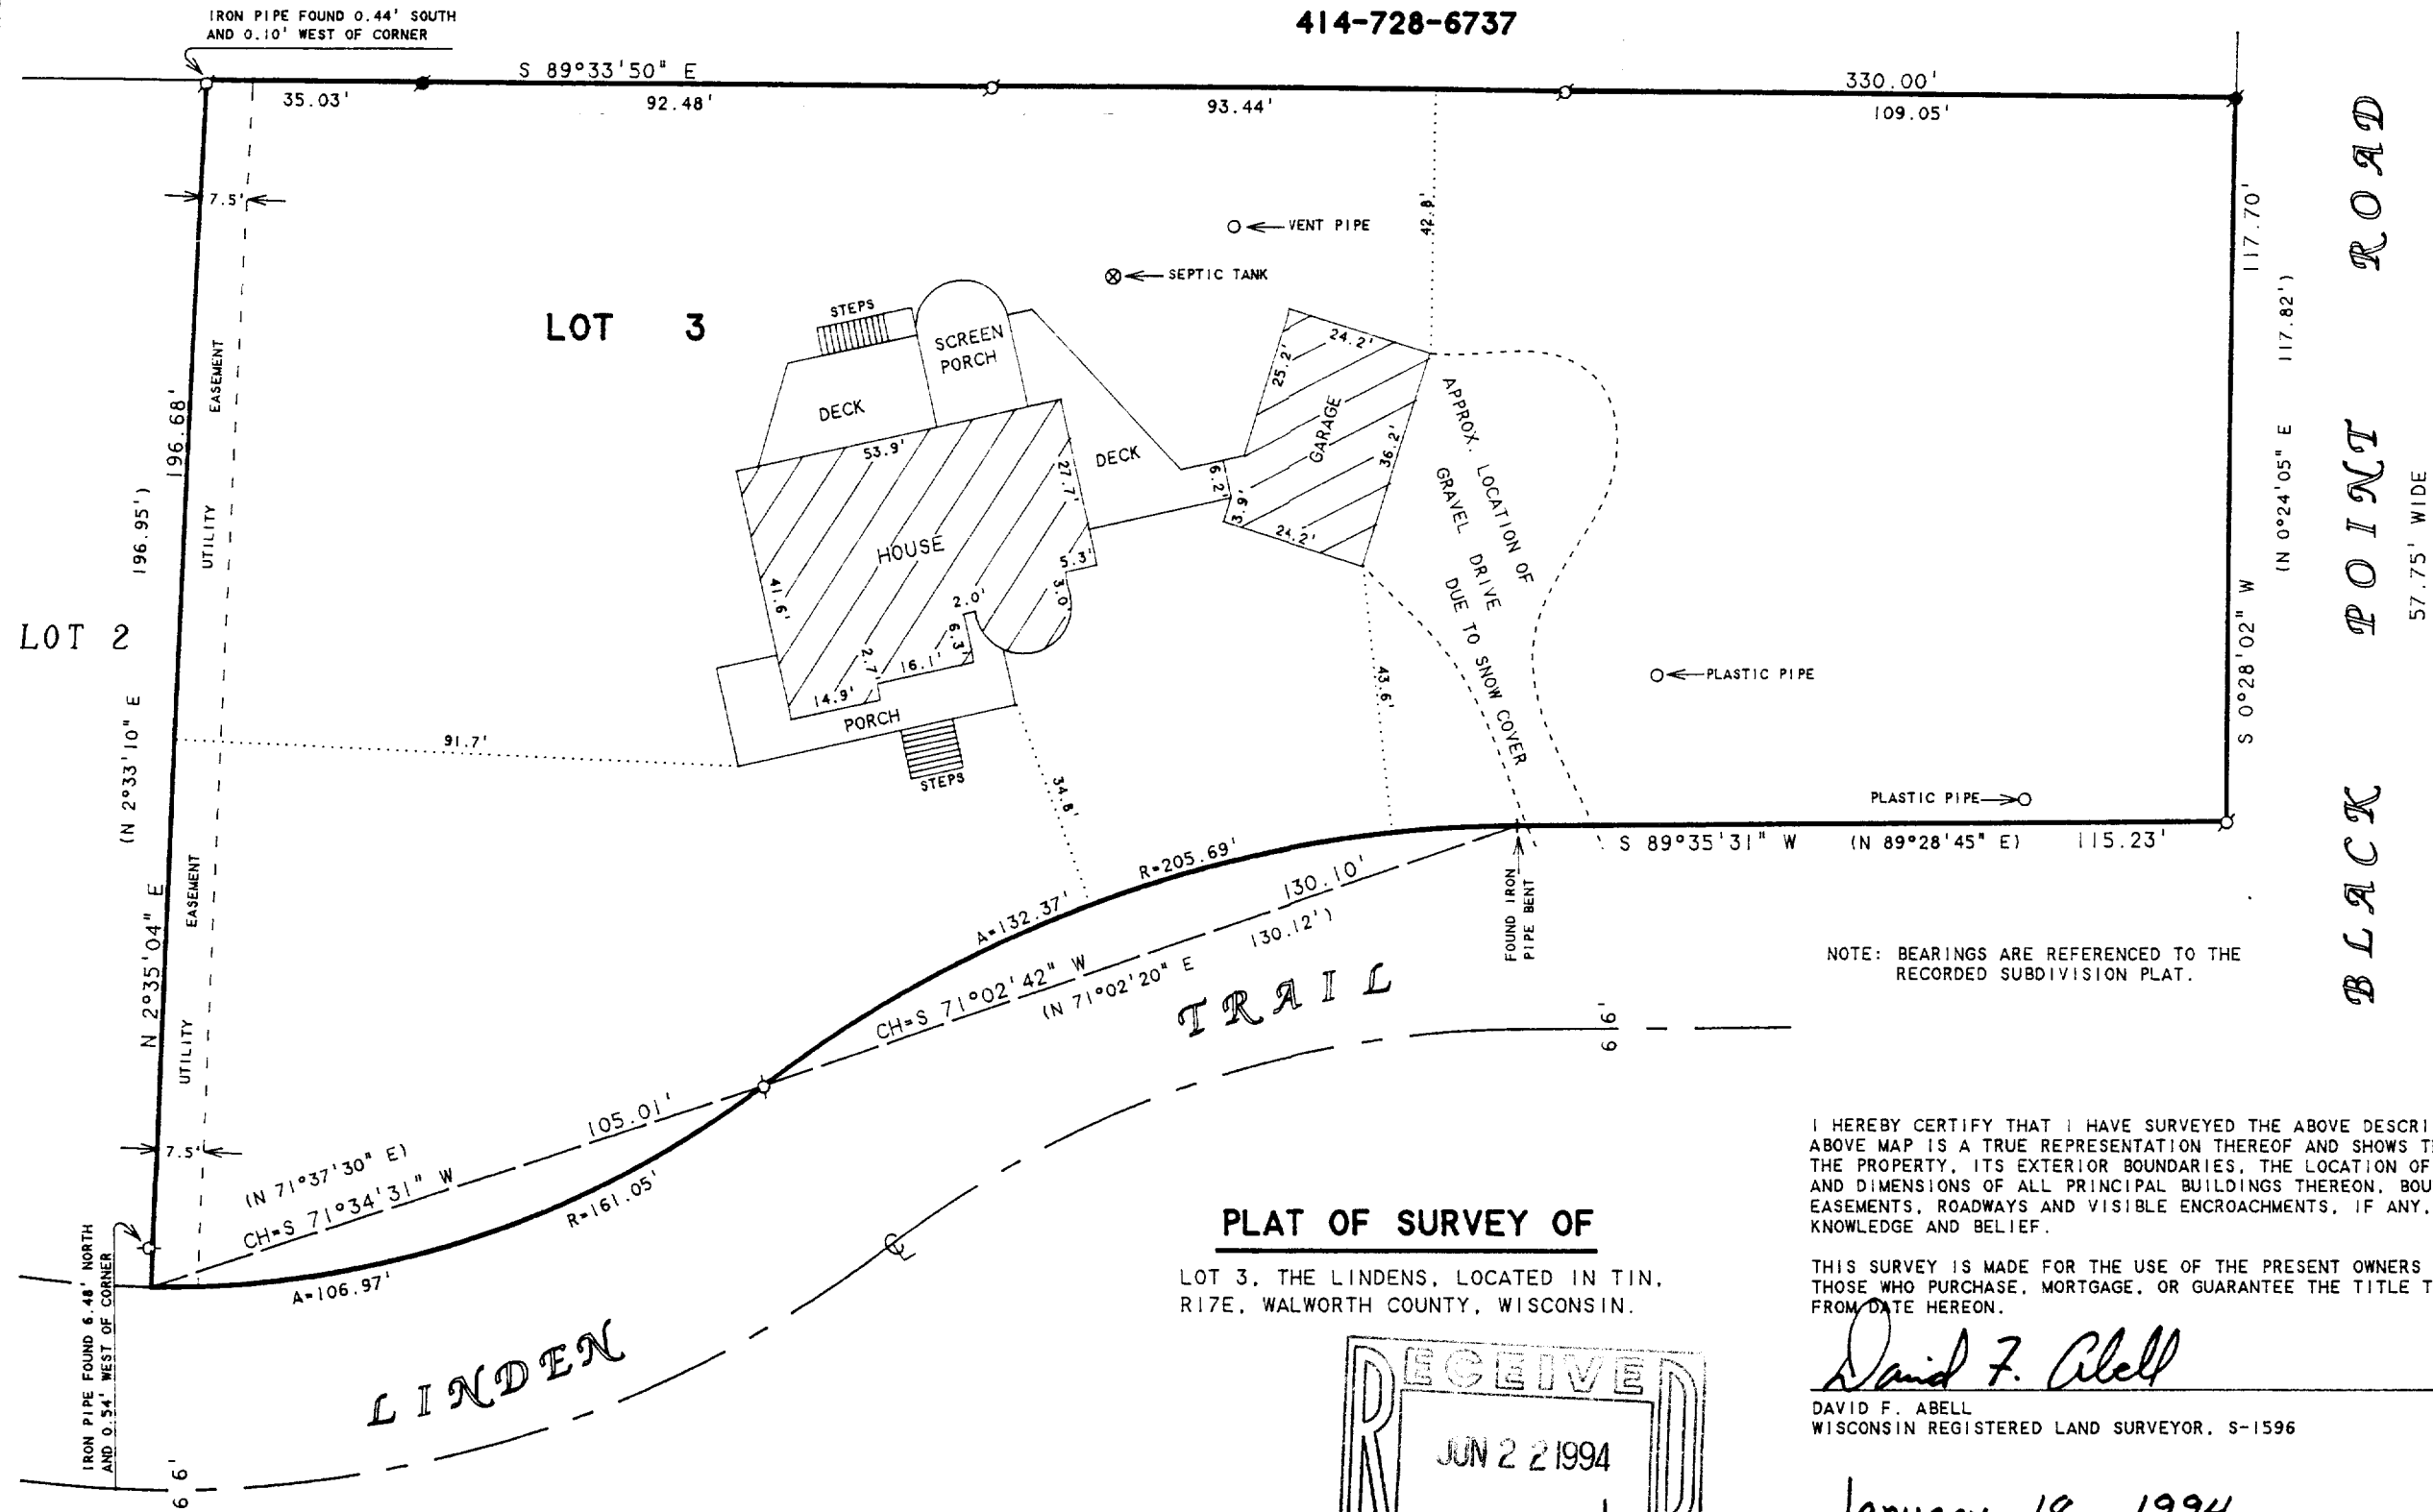

SCALE 1"=30'

- LEGEND
- - IRON PIPE FOUND
 - - CONCRETE MONUMENT FOUND
 - () - RECORDED AS

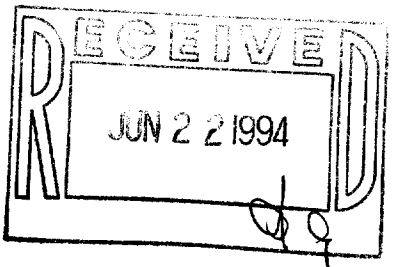

ILVT-3

117-1405