

ABERNATHY and ASSOCIATES

Kenneth B. Abernathy Jr.

Wisconsin Registered Land Surveyor S-1594

W4056 Gray Road
Elkhorn, Wisconsin 53121
Phone: (414) 723-4260 (office)
(414) 723-4513 (residence)


PLAT OF SURVEY

LOT 12 AND THE WEST 25 FEET OF LOT
11 OF THE ELGIN CLUB LOCATED IN THE
SOUTHWEST 1/4 OF SECTION 4, TOWN 1
NORTH, RANGE 17 EAST, WALWORTH
COUNTY, WISCONSIN.

ORDERED BY: JOHN PERRIGO
C/O LAKESIDE FUSEE CORPORATION
P.O. BOX 127
SOUTH BELOIT, ILL. 61080


LEGAL DESCRIPTION:

G.C.D. VOL. 519 P. 41 DOC. NO. 210917
(PROVIDED BY OWNER)

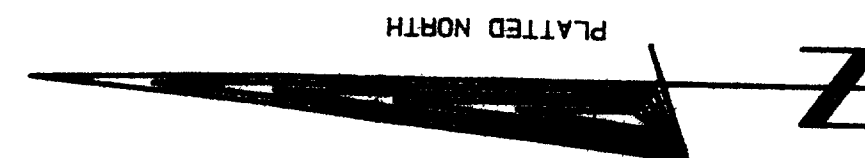

SCALE 1" = 10 FEET
EAST LINE LOT 12 ASSUMED TO
BEAR S 1°20'30"E.

OVERHEAD UTILITY LINES

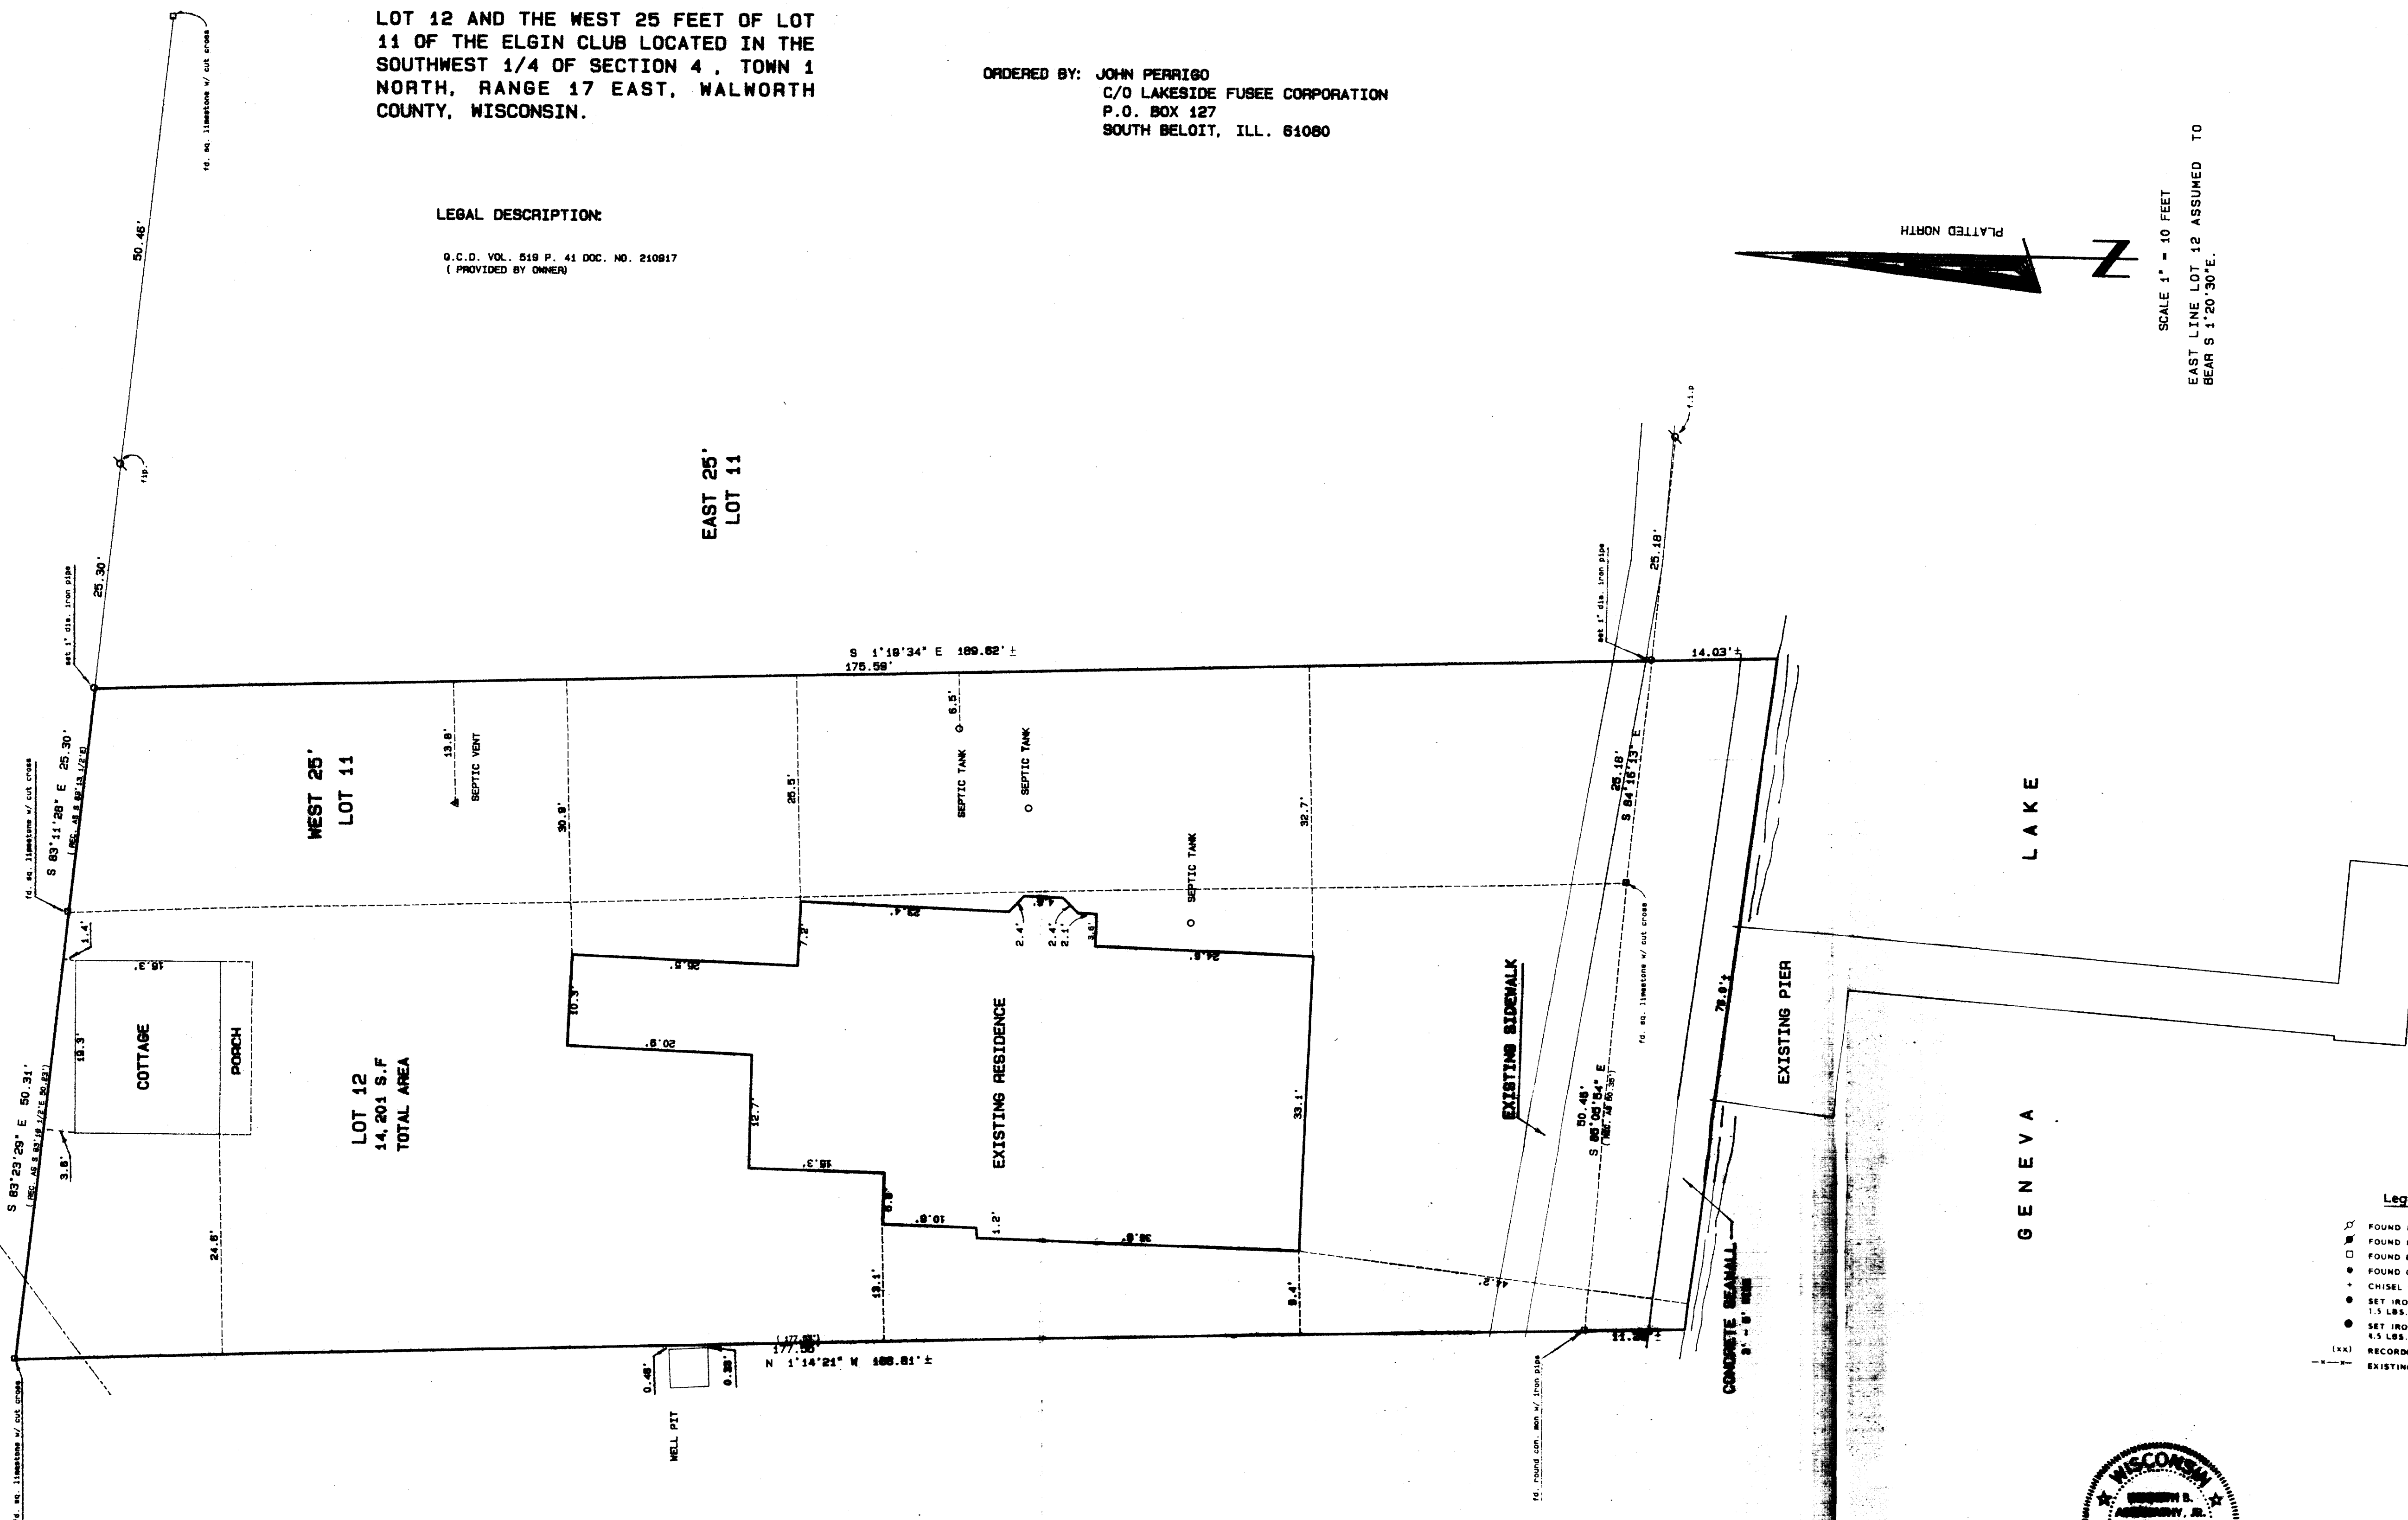

Legend

- FOUND IRON PIPE
- FOUND IRON ROD
- FOUND BRASS CAPPED MONUMENT
- FOUND CONCRETE MONUMENT
- CHISEL CUT IN CONCRETE
- SET IRON ROD, 36" LONG, WEIGHING 1.5 LBS./LINEAL FT., 3/8" DIA.
- SET IRON ROD, 36" LONG, WEIGHING 4.5 LBS./LINEAL FT., 1-11/16" DIA.
- RECORDED AS DIMENSION
- EXISTING FENCE



SCALE: 1" = 10 FEET

I hereby certify that the above described property has been surveyed by me or under my direction and that the above map is a true representation thereof and shows the size and location of the property, its exterior boundaries, the location of all visible structures and easements, roadways and visible encroachments, if any.
This survey is made for the use of the present owner of the property and also those who purchase, mortgage, or guarantee the title thereto within one year from date hereof.

Kenneth B. Abernathy, Jr.
KENNETH B. ABERNATHY, JR.
WISCONSIN REGISTERED LAND SURVEYOR
S-1594

Date: 7-29-94 Job No. 94-783