
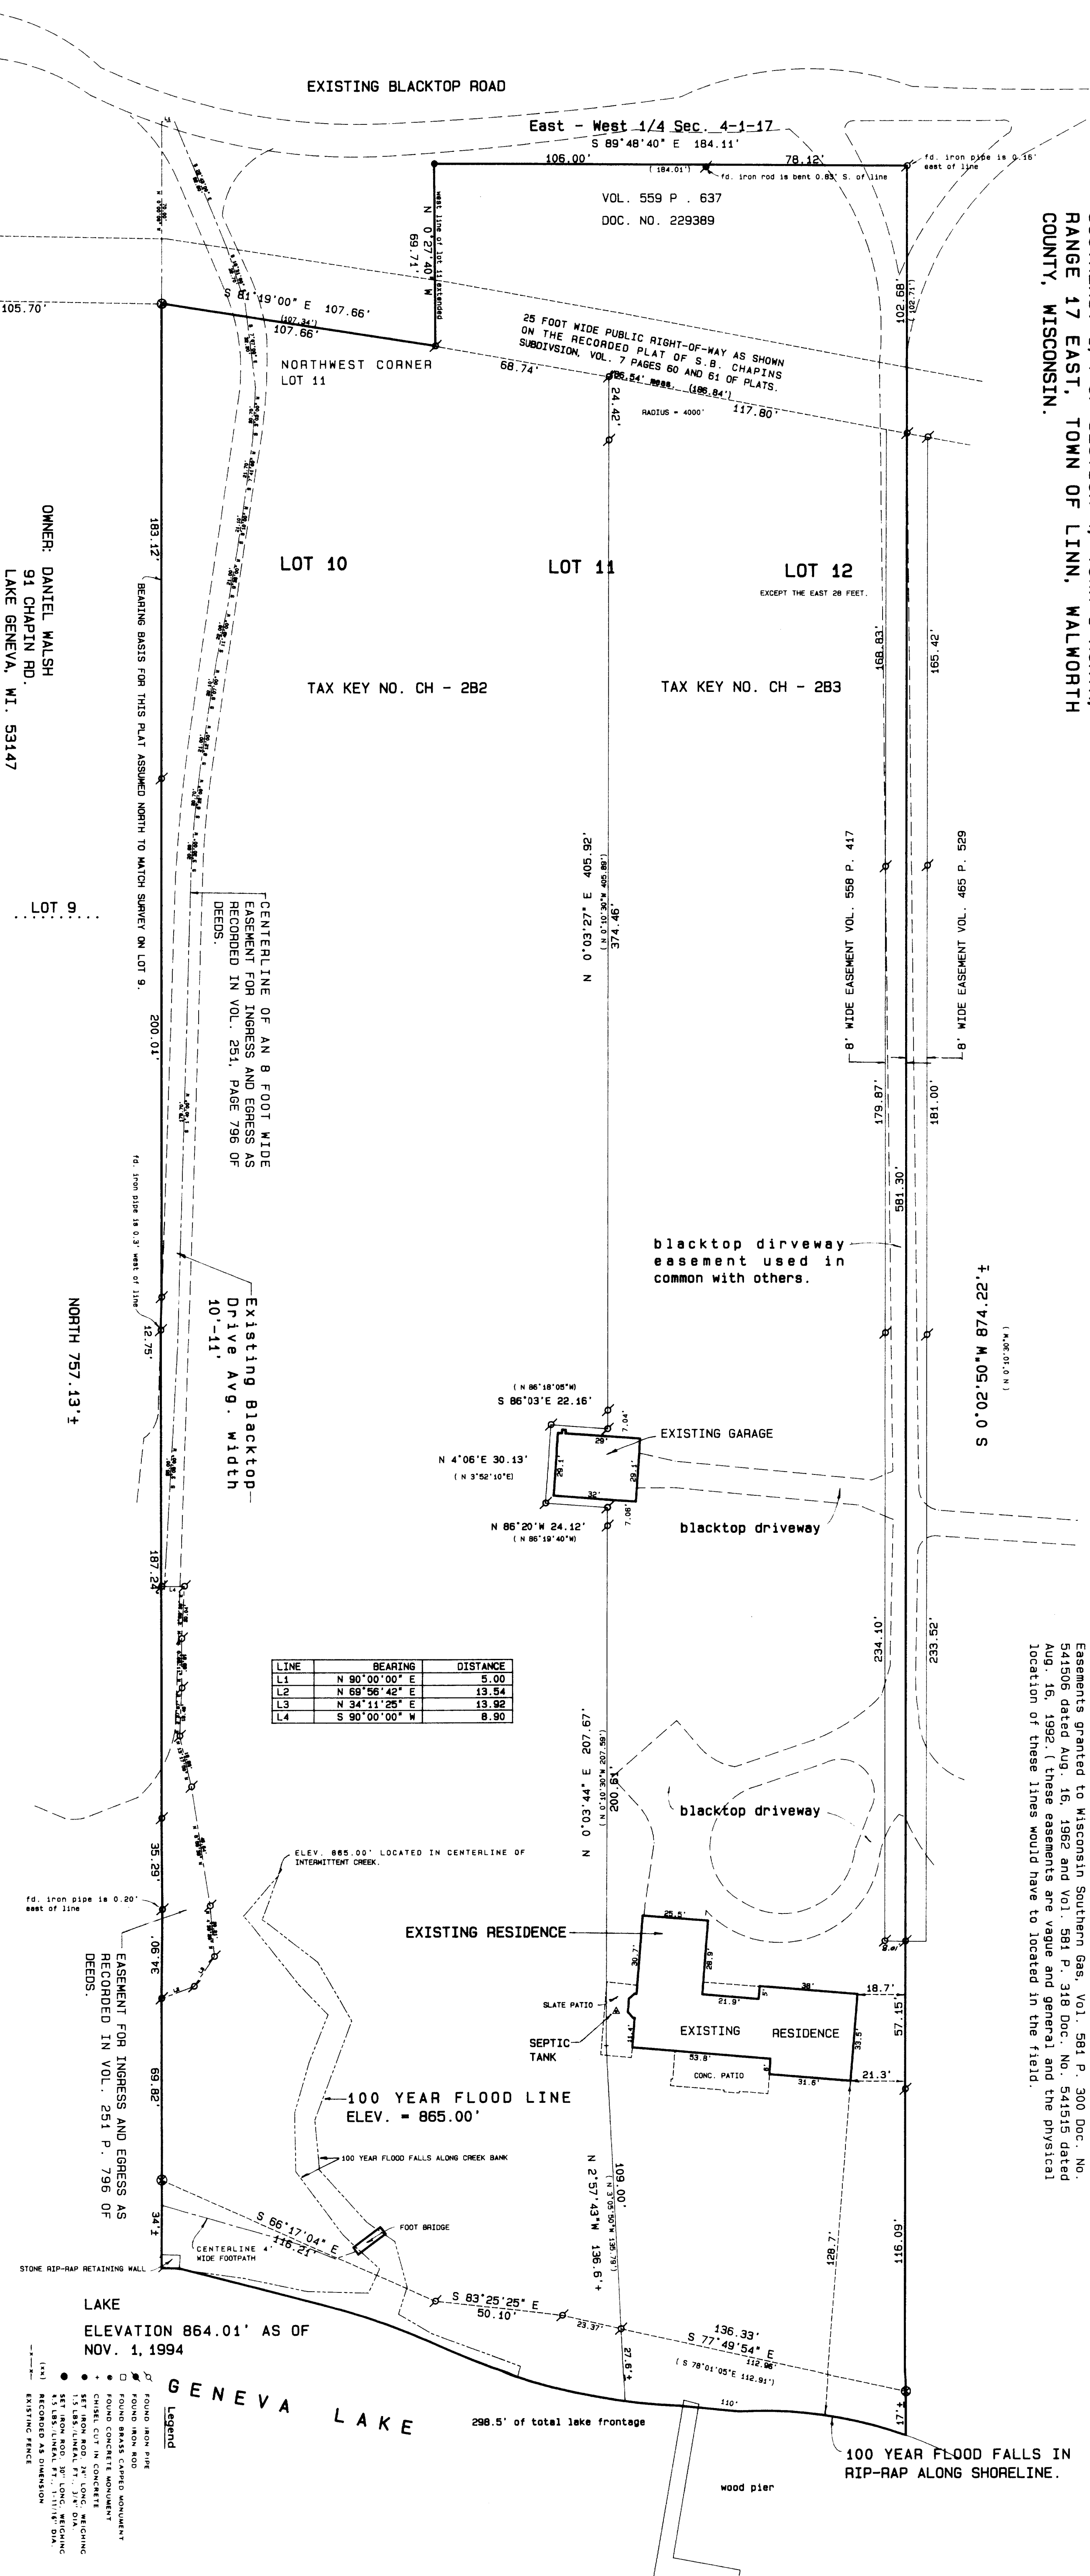



PLAT OF SURVEY

LOTS 10, 11 AND PART OF LOT 12 OF S.B. CHAPINS SUBDIVISION, LOCATED IN THE SOUTHEAST 1/4 OF SECTION 4, TOWN 1 NORTH, RANGE 17 EAST, TOWN OF LINN, WALWORTH COUNTY, WISCONSIN.

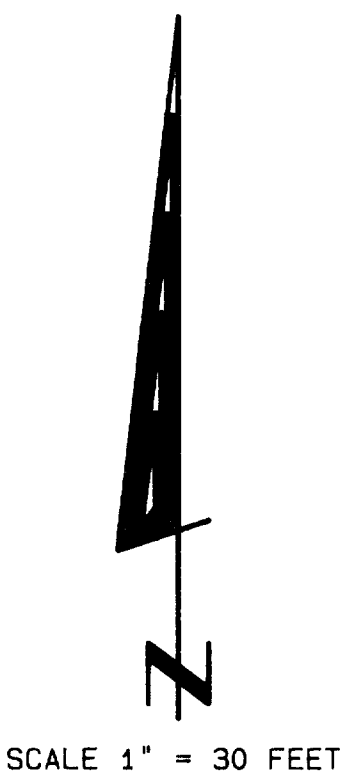

LINE	BEARING	DISTANCE
L1	N 90°00'00" E	5.00
L2	N 69°56'42" E	13.54
L3	N 34°11'25" E	13.92
L4	S 90°00'00" W	8.90

Legal Description:
Shtaz to Walsh MD. Vol. 559 P. 635 Doc. No. 229388 dated Mar. 19, 1992.
Shtaz to Walsh MD Vol. 559 P. 637 Doc. No. 229389 dated Mar. 19, 1992.
Easement for septic system on subject premises for the benefit of adjoining property to the east (no such system was found during the course of this survey) Vol. 250 P. 681 Doc. No. 57881 dated May 1, 1980.
Rights of the public in and to a path or walkway on or near the embankment of the waters of Lake Geneva.
Easements granted to Wisconsin Southern Gas. Vol. 581 P. 300 Doc. No. 541506 dated Aug. 16, 1982 and Vol. 581 P. 318 Doc. No. 541515 dated Aug. 16, 1992. (these easements are vague and general and the physical location of these lines would have to be located in the field.)

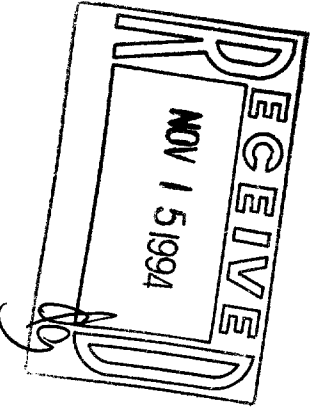

Kenneth B. Abernathy, Jr.
WISCONSIN REGISTERED LAND SURVEYOR,
S-1594
Date: Nov. 2, 1994 Job No. 94-306

SCALE: 1"= 30 FEET

- Legend
- FOUND IRON PIPE
 - FOUND BRASS CAPED MONUMENT
 - CHISEL CUT IN CONCRETE
 - 1 1/2" IRON PIPE, 1" LONG, DIA. 1 1/2"
 - SET IRON ROD, 30" LONG, RECHING 1 1/2" DIA.
 - 1 1/2" IRON PIPE, 1 1/2" DIA.
 - EXISTING FENCE

LAKE
ELEVATION 864.01' AS OF
NOV. 1, 1994

GENEVA LAKE

CH-282

117-1413