

ABERNATHY and ASSOCIATES


Kenneth B. Abernathy Jr.

Wisconsin Registered Land Surveyor S-1594

W4056 Bray Road
Elkhorn, Wisconsin 53121
Phone (414) 723-4260 (office)
(414) 723-4813 (residence)

PLAT OF SURVEY

Lot 2 of Certified Survey Map Number 675, located in part of the Northeast 1/4 of Section 5, Town 1 North, Range 17 East, Town of Linn, Walworth County, Wisconsin.

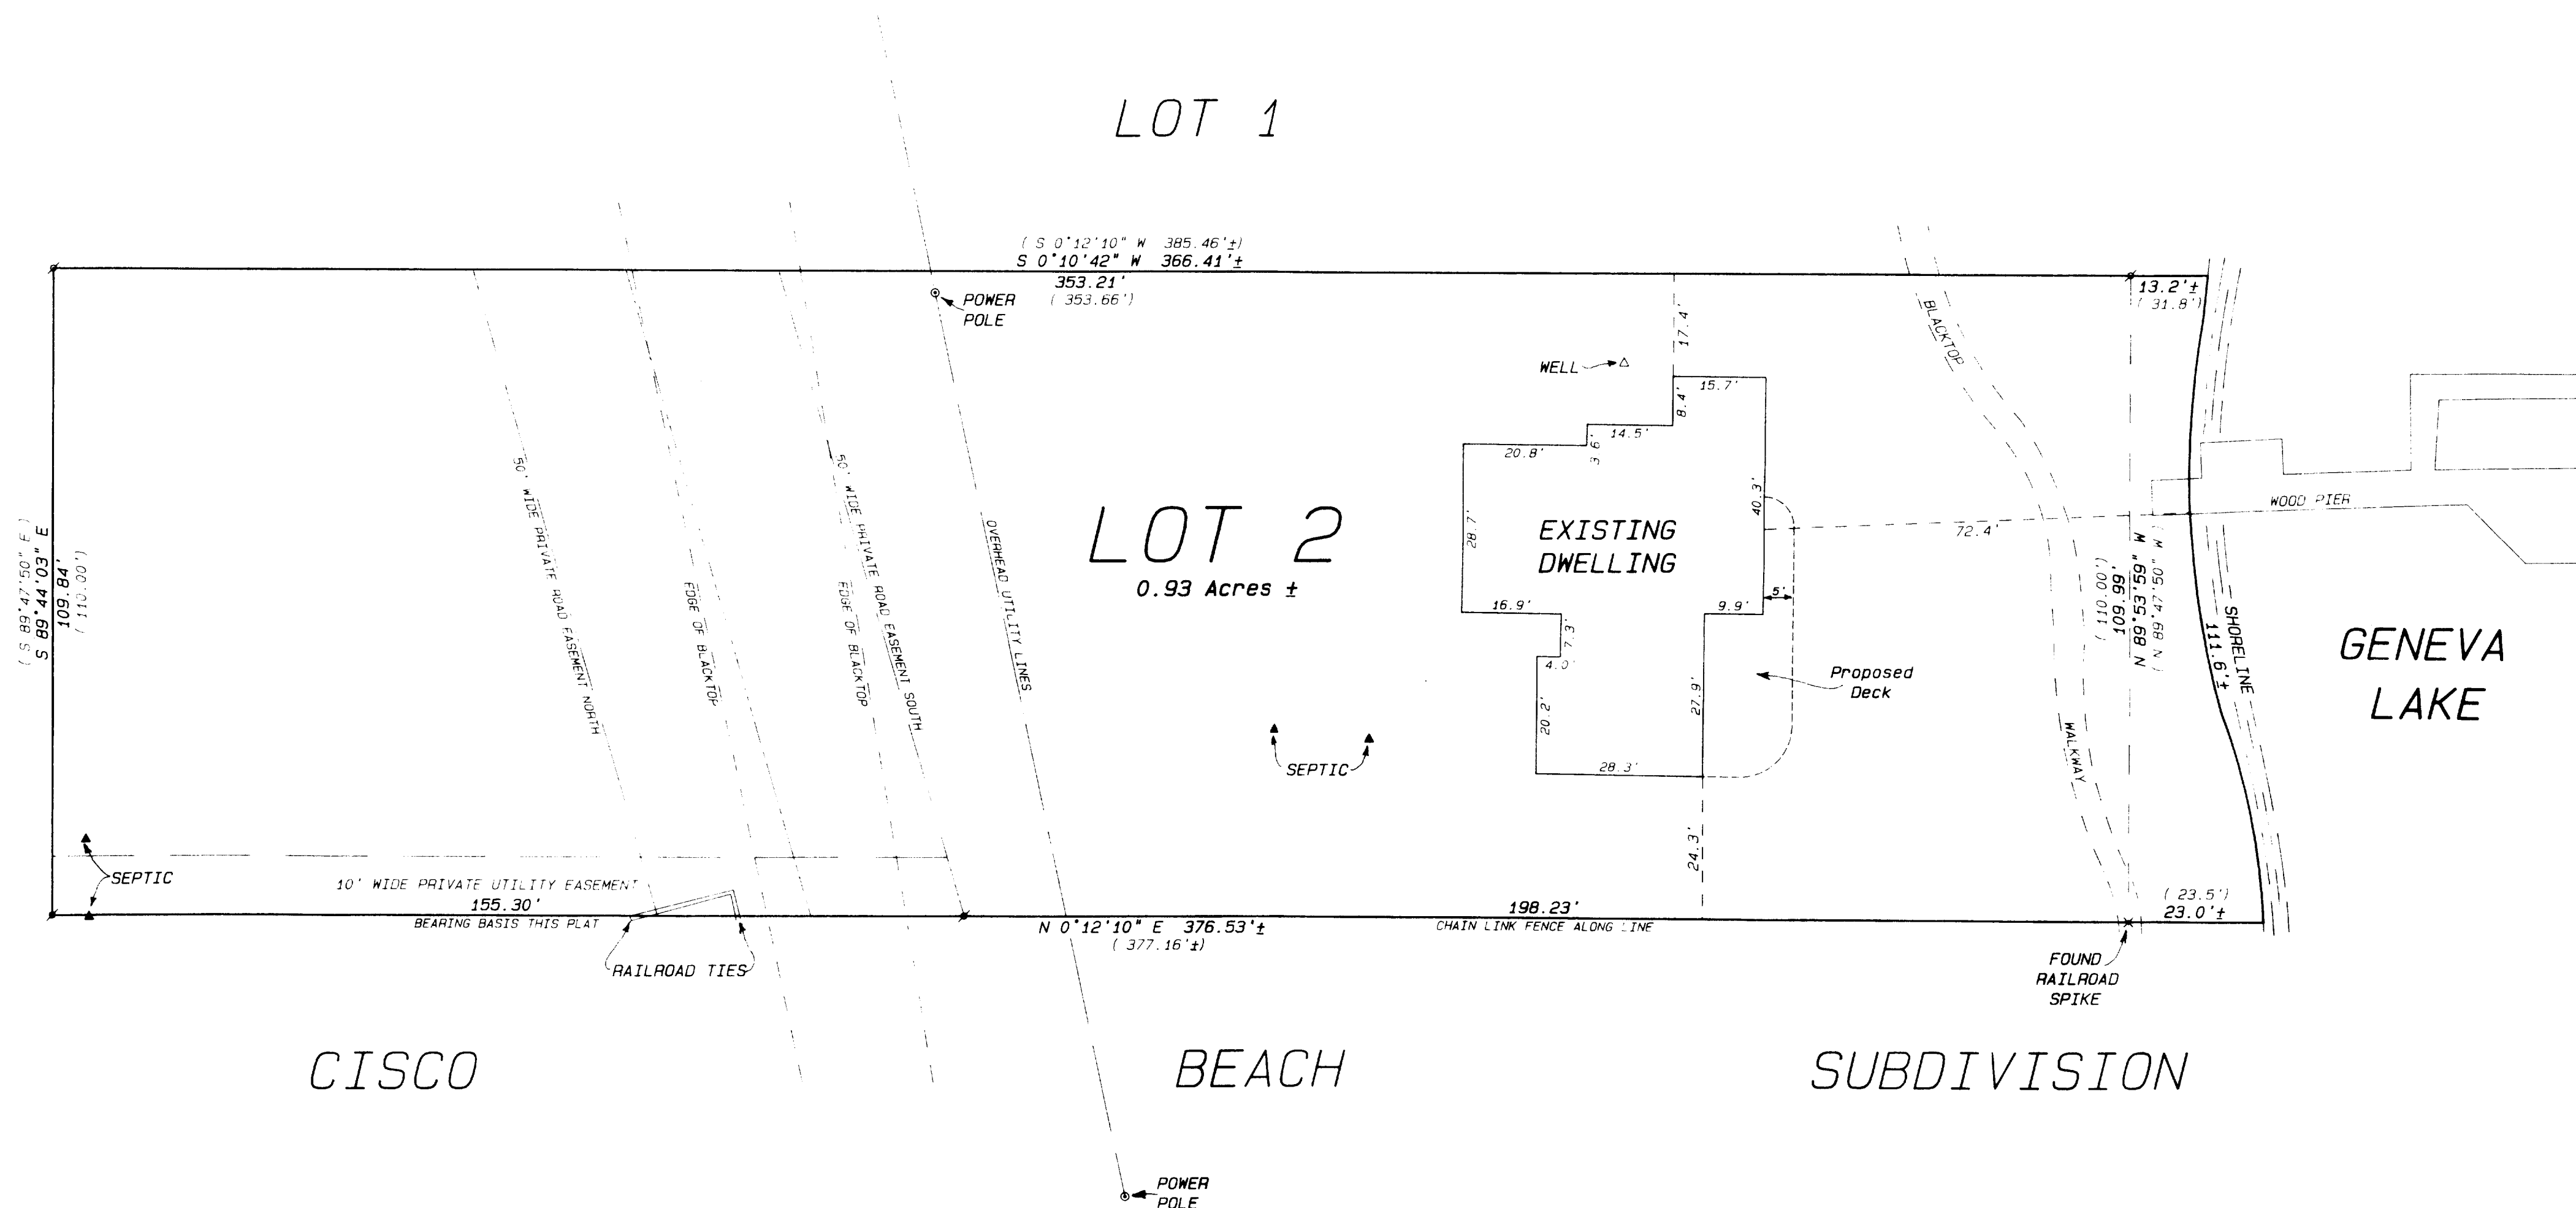

Ordered by: Dale Castleman
B & J Tree & Landscape Service, Inc.
W3041 Kruger Road
Lake Geneva, Wisconsin 53546

Owners: Robert & Karol Karlblom
559 Westminster
Lake Forest, Illinois 60045


NOTE
Subject to easements
recorded or unrecorded.

Legend

- FOUND IRON PIPE
- FOUND IRON ROD
- FOUND BRASS CAPPED MONUMENT
- ✱ FOUND CONCRETE MONUMENT
- CHISEL CUT IN CONCRETE
- SET IRON ROD 24" LONG WEIGHING 15 LBS LINEAL FT. 3/4" DIA.
- SET IRON ROD 10" LONG WEIGHING 4.5 LBS LINEAL FT. 1/2" DIA.
- RECORDED AS DIMENSION
- - - - - EXISTING FENCE



SCALE: 1"= 20 FEET

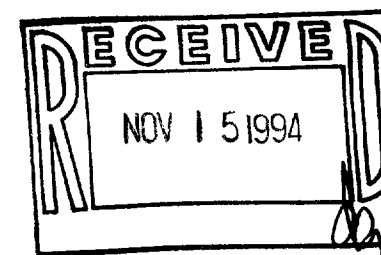

Kenneth B. Abernathy, Jr.
KENNETH B. ABERNATHY, JR.
WISCONSIN REGISTERED LAND SURVEYOR,
S-1594
Date: October 17, 1994 Job No. 1994.922