


HAROLD H. KOLB
 REGISTERED PROFESSIONAL LAND SURVEYOR
 LAKE GENEVA, WISCONSIN

PLAT OF SURVEY OF

Part of Lot 1, The Birches,
 located in Section 10, T 1 N,
 R 17 E, Walworth County, Wis.


Harold H. Kolb
 Harold H. Kolb
 Wisconsin Surveyor, S-157
 DATE: May 22, 1964

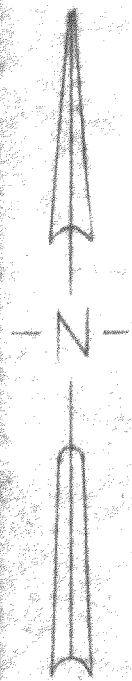

Scale
 1" = 40'

Lincoln Hwy.

Lake Geneva

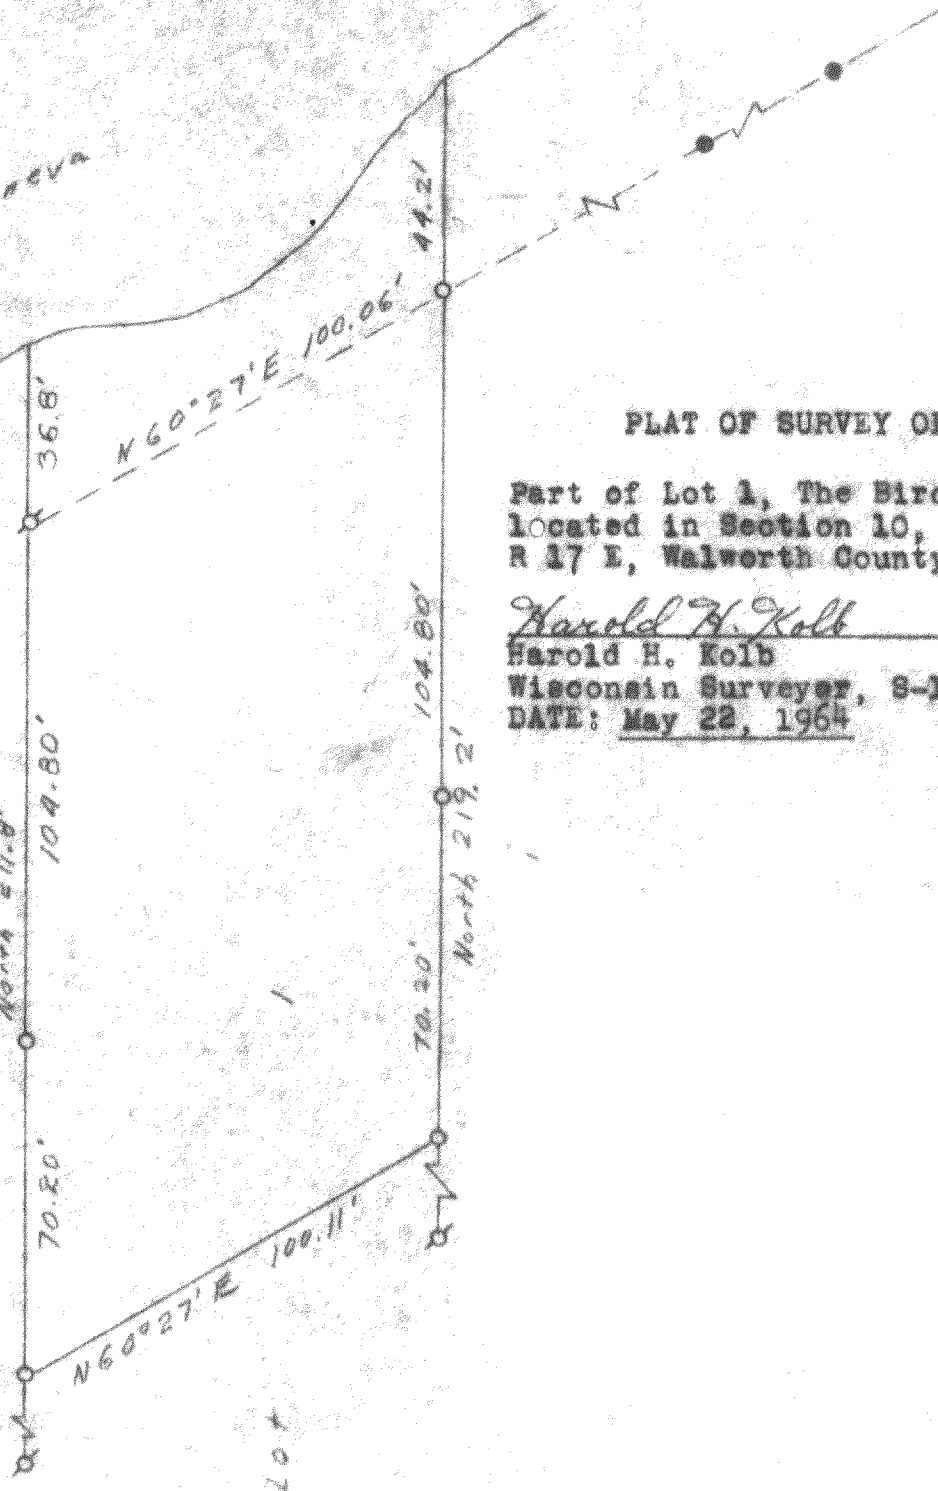

- Concrete Monument Found
- ⊗ Iron Pipe Found
- Iron Pipe Placed

FBA-10

117-143