


ABELL
SURVEYING & MAPPING
DELAVAN, WISCONSIN 53115
414-728-6737

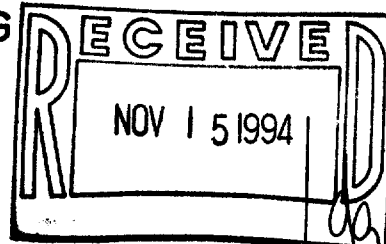


LOT 21

LOT 24

LOT 25

LOT 28

HILLSIDE ROAD

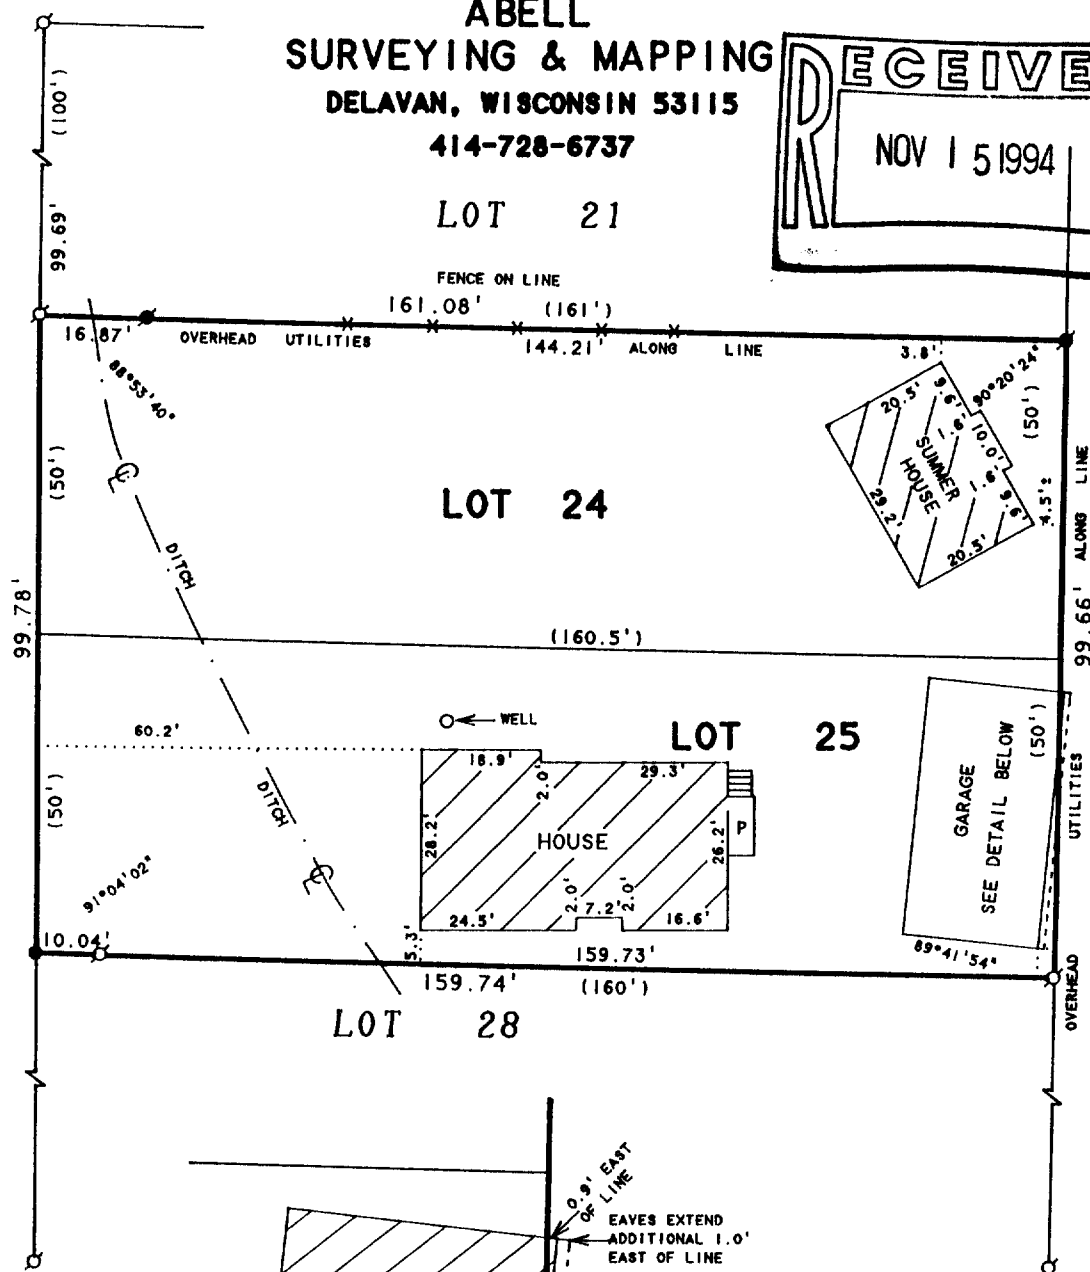

ORDERED BY: JOHN CAVANAUGH
N1796 HILLSIDE ROAD
LAKE GENEVA, WI 53147

PLAT OF SURVEY OF

LOTS 24 AND 25, LAKE GENEVA BEACH,
LOCATED IN T1N. 17E, WALWORTH
COUNTY, WISCONSIN.

N

SCALE 1"=30'

LEGEND

- - IRON PIPE FOUND
- - CONCRETE MONUMENT FOUND
- - IRON ROD FOUND
- P - PORCH
- * - WOOD FENCE
- () - RECORDED AS

I, DAVID F. ABELL, DO HEREBY CERTIFY THAT I HAVE SURVEYED THE PROPERTY HEREON DESCRIBED ACCORDING TO THE OFFICAL RECORDS AND THAT THE PLAT HEREON IS A CORRECT REPRESENTATION OF THE PROPERTY LINES TO THE BEST OF MY KNOWLEDGE AND BELIEF.

David F. Abell

DAVID F. ABELL
WISCONSIN REGISTERED LAND SURVEYOR, S-1596

JANUARY 11, 1994

DATE: JANUARY 11, 1994 JOB NUMBER - 93293
NOTE: THIS IS NOT A CERTIFIED COPY UNLESS SEALED.

REVISED JUNE 29, 1994 TO
SHOW LOCATION OF GARAGE
UNDER CONSTRUCTION

ILGB-19

117-1432