


PLAT OF SURVEY

LOCATION: 2466 Elgin Club Drive, Lynn, Wisconsin

LEGAL DESCRIPTION: Lot 2 of CERTIFIED SURVEY MAP NO. 2, said survey being a part of the Northwest 1/4 of Section 4, Town 1 North, Range 17 East, Walworth County, Wisconsin, ALSO, a strip of land 60 feet in width adjoining the above described premises on the East; the North line of said strip being the North line of Lot 2 extended Easterly and the South line thereof being the South line of Lot 2 extended Easterly, all being a part of the Northwest 1/4 of Section 4, Town 1 North, Range 17 East, Walworth County, Wisconsin.

December 28, 1994

Survey No. 84719

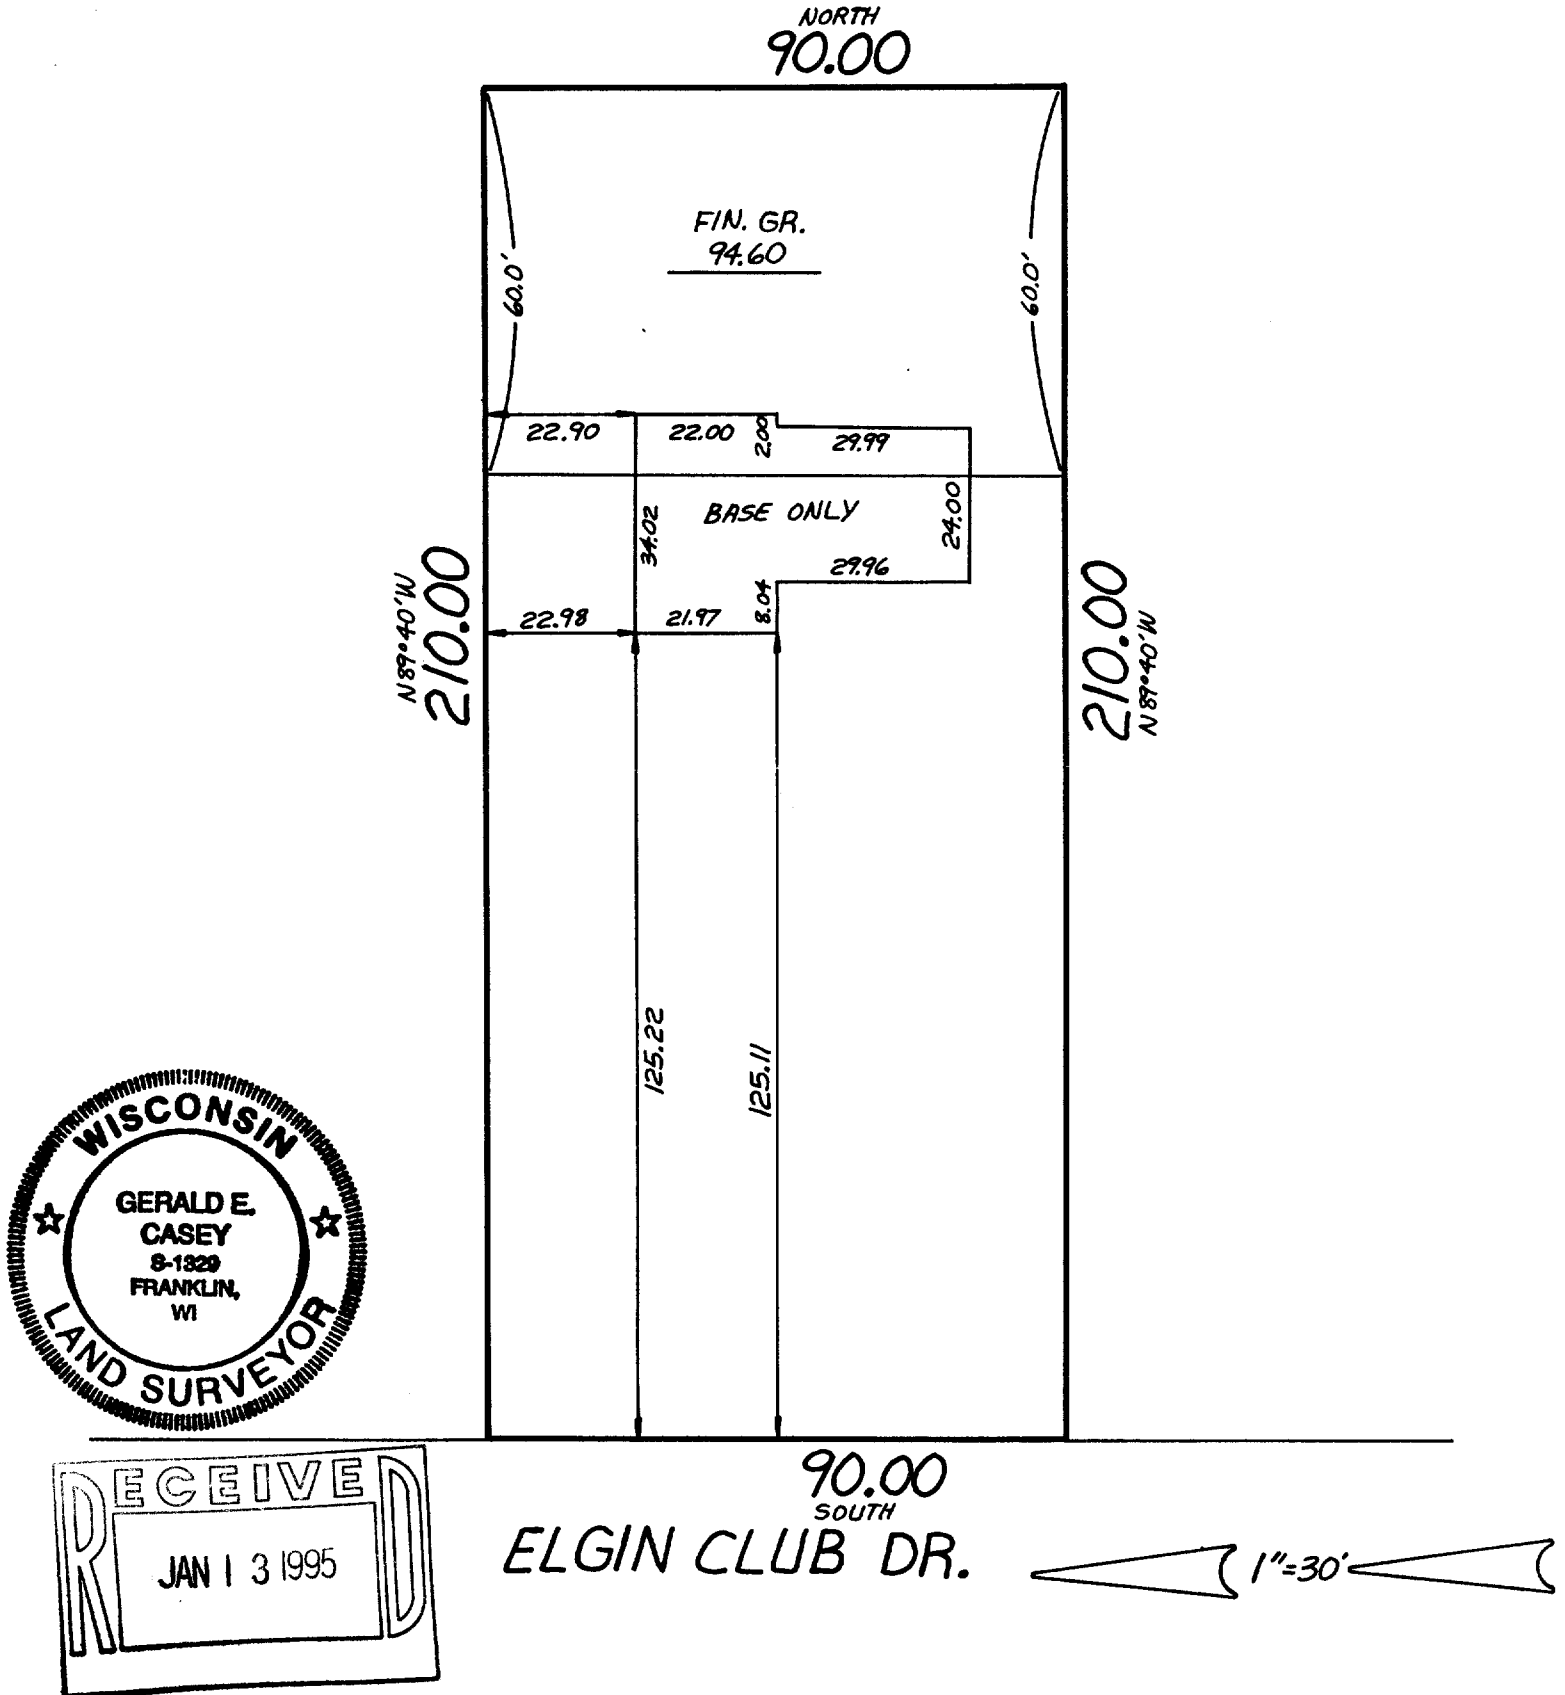

METROPOLITAN SURVEY SERVICE, INC.

REGISTERED LAND SURVEYORS

9415 W. FOREST HOME AVE., SUITE 202, HALES CORNERS, WI 53130

PH. 529-5380 FAX 529-9787

I HEREBY CERTIFY THAT I HAVE SURVEYED THE ABOVE DESCRIBED PROPERTY AND THAT THE ABOVE MAP IS A TRUE REPRESENTATION THEREOF AND SHOWS THE SIZE AND LOCATION OF THE PROPERTY. ITS EXTERIOR BOUNDARIES, THE LOCATION OF ALL VISIBLE STRUCTURES AND DIMENSIONS OF ALL PRINCIPAL BUILDINGS THEREON, BOUNDARY FENCES, APPARENT EASEMENTS AND ROADWAYS AND VISIBLE ENCROACHMENTS, IF ANY.

THIS SURVEY IS MADE FOR THE EXCLUSIVE USE OF THE PRESENT OWNERS OF THE PROPERTY, AND ALSO THOSE WHO PURCHASE, MORTGAGE, OR GUARANTEE THE TITLE THERETO WITHIN ONE (1) YEAR FROM DATE HEREOF.

SIGNED

Gerald E. Casey

Gerald E. Casey
Registered Land Surveyor 8-1329

IA-2-2

117-1442