


KOLB LAND CONSULTING, INC.
LAND SURVEYING • SUBDIVIDING • LAND PLANNING

LAKE GENEVA, WISCONSIN 53147

414-248-3697

LAKEVIEW ROAD


HIGHLAND ROAD 50' WIDE

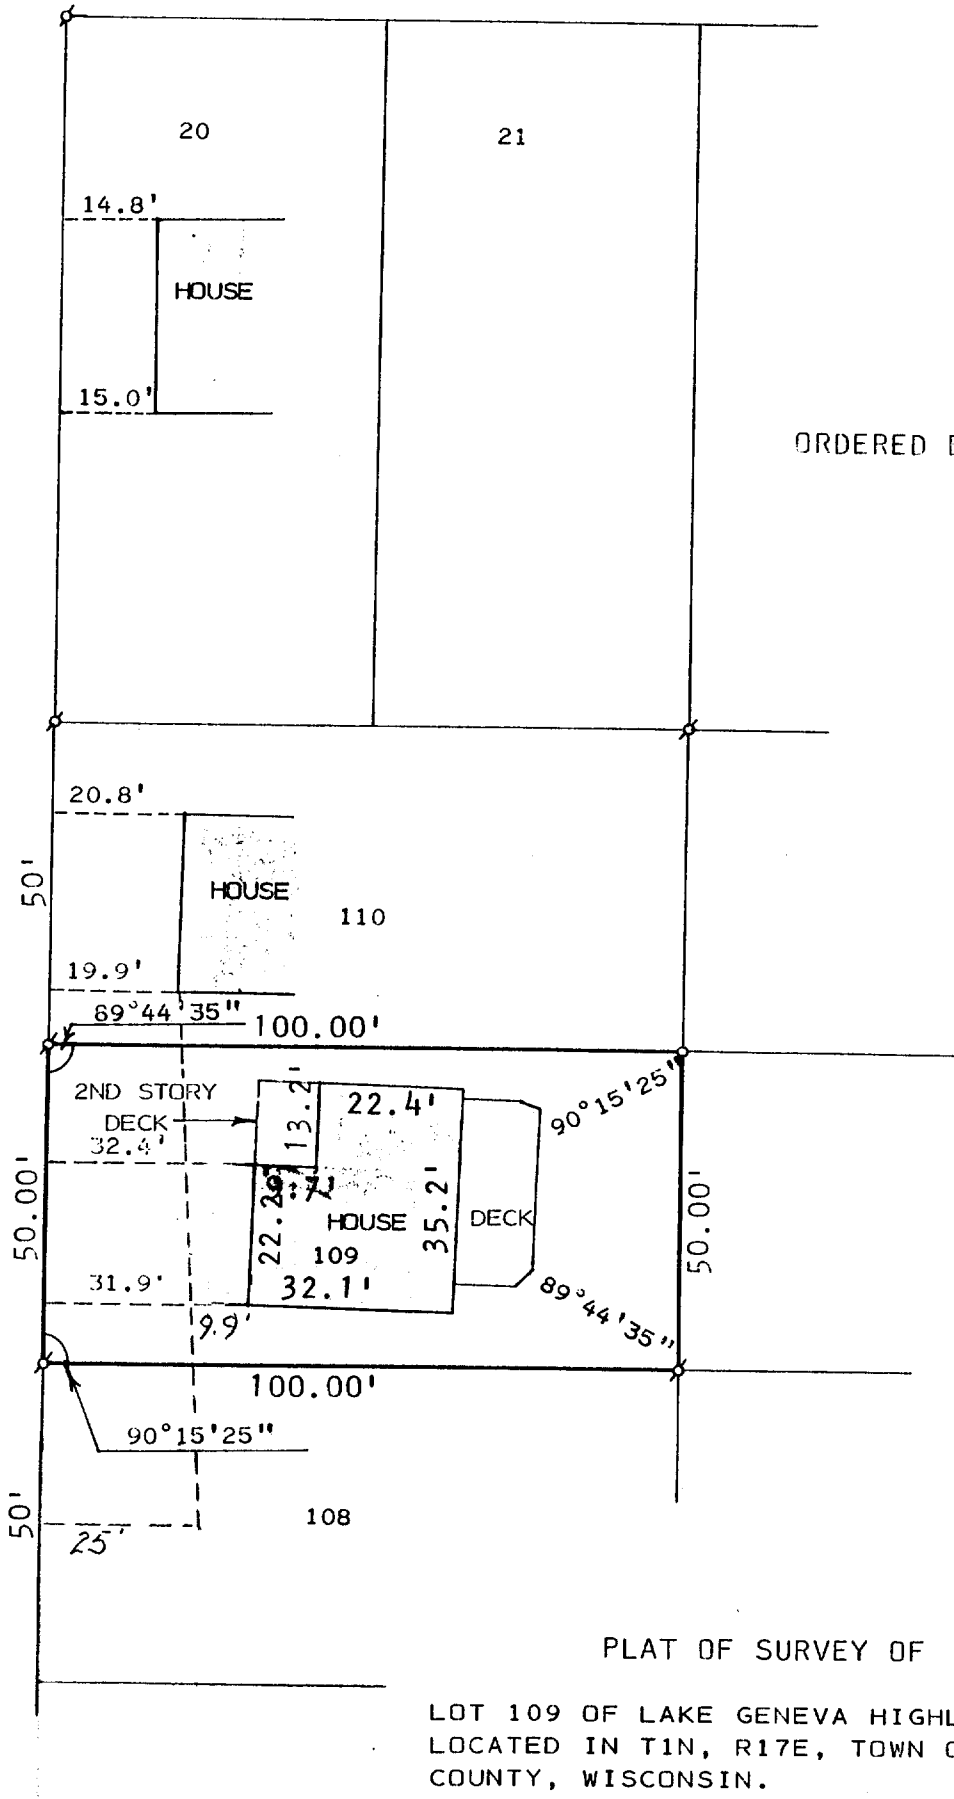

ORDERED BY: JOHN ENGERMAN
W3411 CTY. HWY BB
LAKE GENEVA, WI 53147

PLAT OF SURVEY OF

LOT 109 OF LAKE GENEVA HIGHLANDS, A SUBDIVISION
LOCATED IN T1N, R17E, TOWN OF LINN, WALWORTH
COUNTY, WISCONSIN.

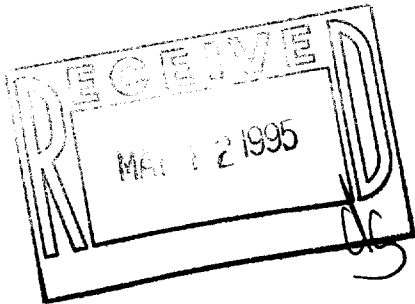

SCALE: 1" = 30'

LEGEND

— - IRON PIPE FOUND
- - IRON PIPE SET

I, HAROLD H. KOLB, DO HEREBY CERTIFY
THAT I HAVE SURVEYED THE PROPERTY
HEREON DESCRIBED ACCORDING TO THE
OFFICIAL RECORDS, AND THAT THE PLAT
HEREON IS A CORRECT REPRESENTATION
OF THE LOT LINES TO THE BEST OF MY
KNOWLEDGE AND BELIEF.
SURVEY NOT VALID UNLESS SURVEYOR'S
SIGNATURE IS IN RED.

HAROLD H. KOLB
WISCONSIN REGISTERED LAND SURVEYOR, S-187
DATE SEPTEMBER 19, 1994

1LGH-106