


KOLB LAND CONSULTING, INC.
 LAND SURVEYING • SUBDIVIDING • LAND PLANNING

LAKE GENEVA, WISCONSIN 53147

414-248-3697

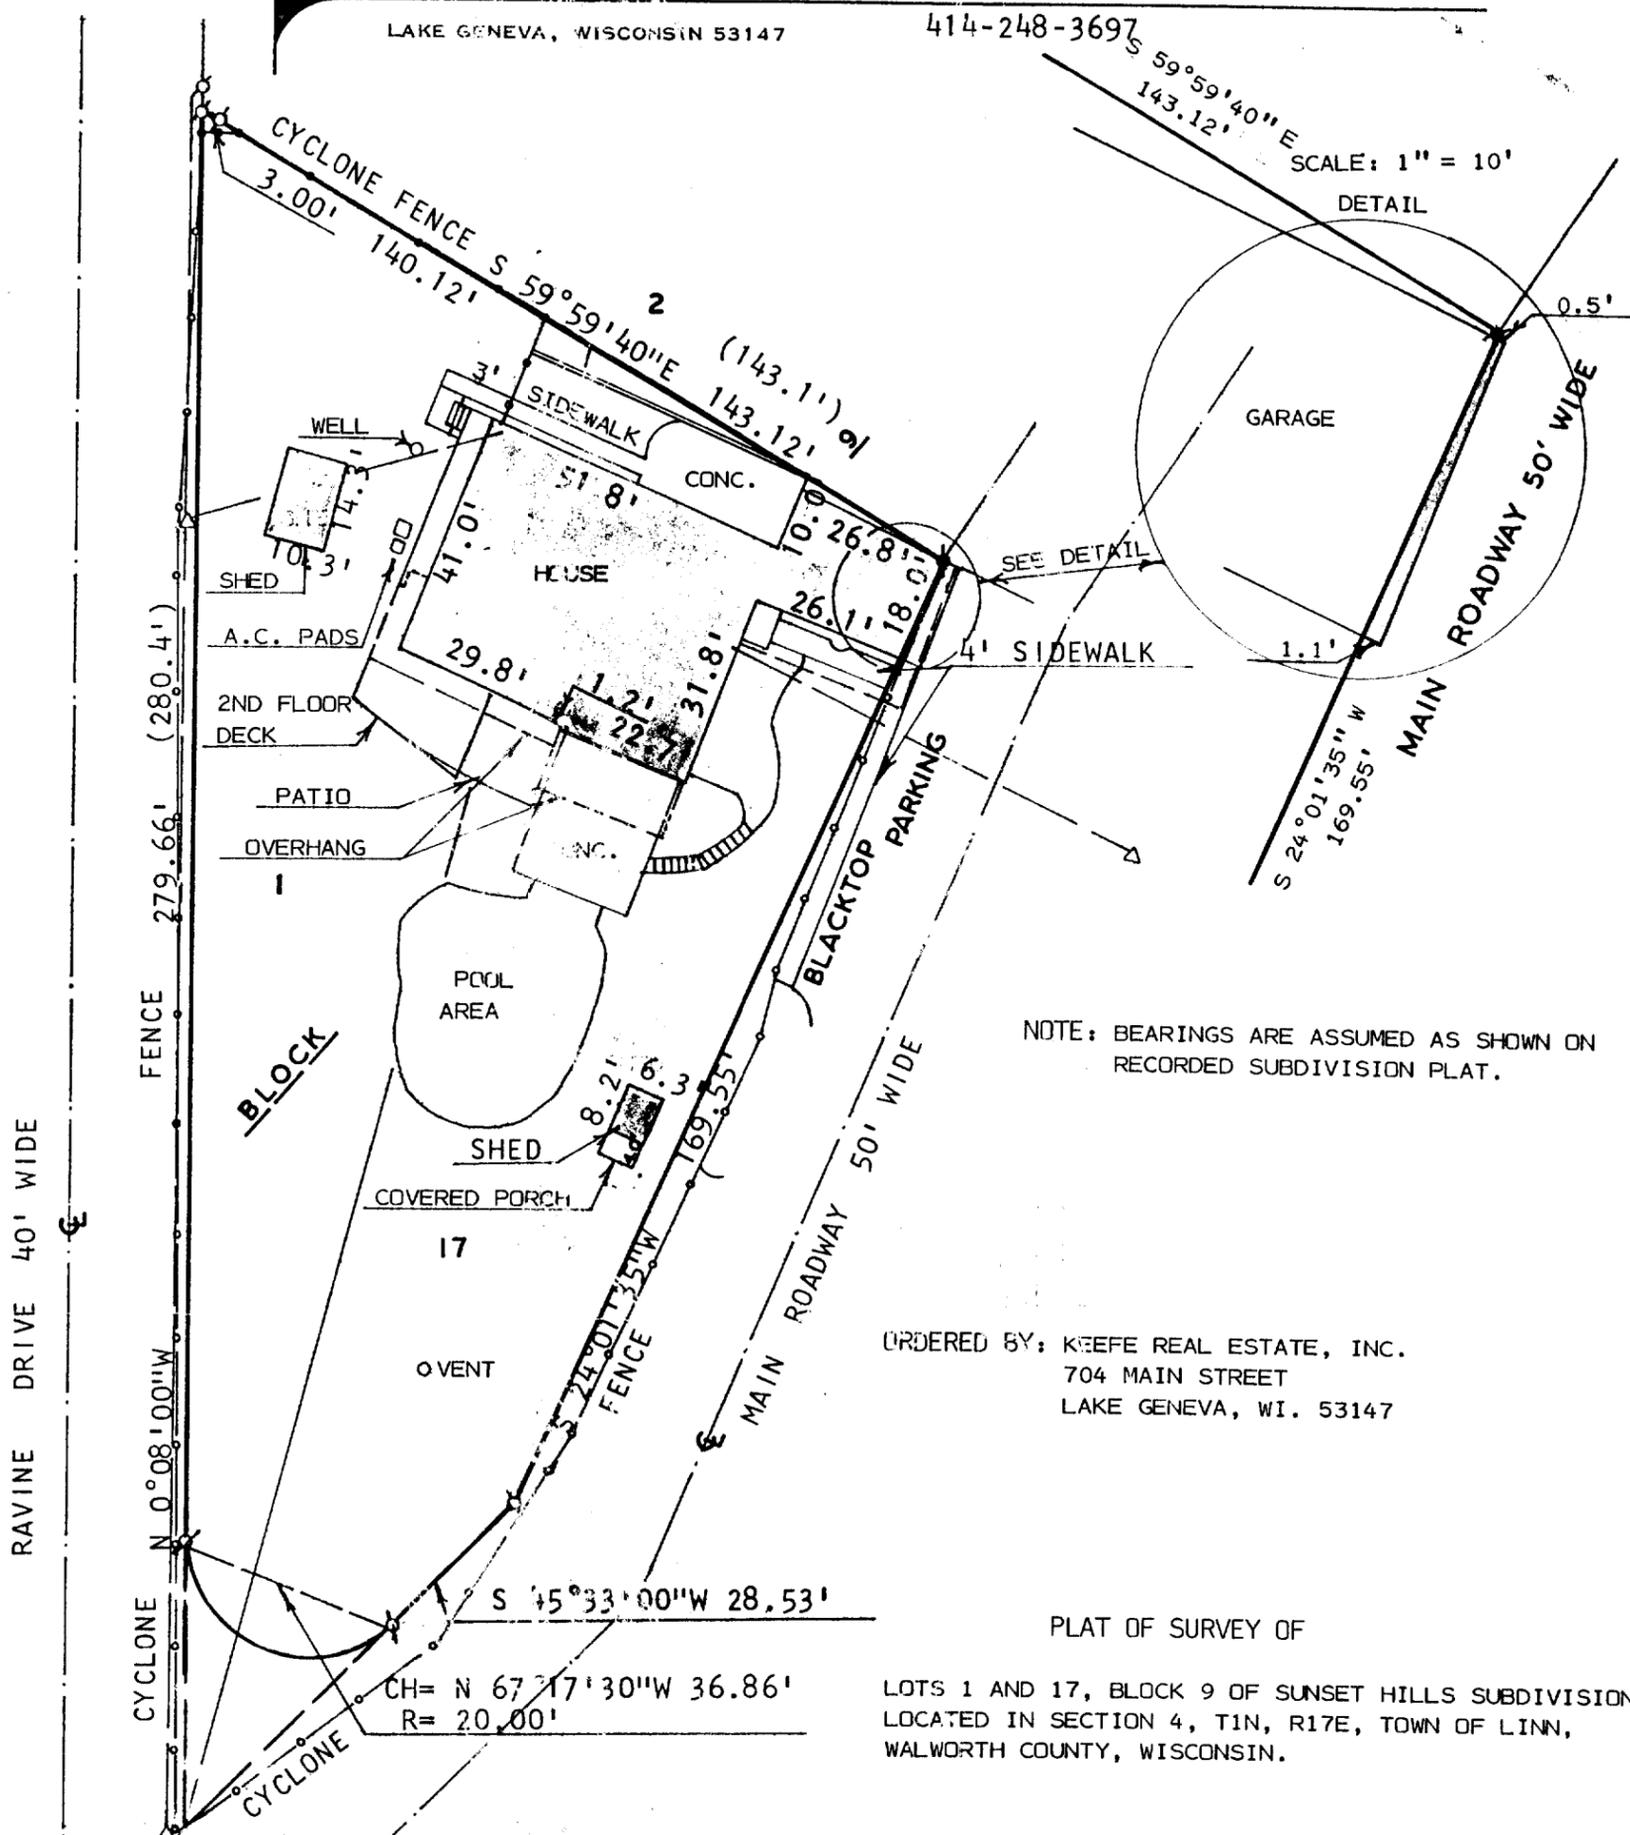

NOTE: BEARINGS ARE ASSUMED AS SHOWN ON RECORDED SUBDIVISION PLAT.

ORDERED BY: KEEFE REAL ESTATE, INC.
 704 MAIN STREET
 LAKE GENEVA, WI. 53147

PLAT OF SURVEY OF

LOTS 1 AND 17, BLOCK 9 OF SUNSET HILLS SUBDIVISION
 LOCATED IN SECTION 4, T1N, R17E, TOWN OF LINN,
 WALWORTH COUNTY, WISCONSIN.

NOTE: ALL PROPERTY CORNERS
 AND IMPROVEMENTS RELOCATED,
 JUNE 20, 1994.


I HEREBY CERTIFY THAT I HAVE SURVEYED THE
 ABOVE DESCRIBED PROPERTY AND THAT THE ABOVE
 MAP IS A TRUE REPRESENTATION THEREOF AND
 SHOWS THE SIZE AND LOCATION OF THE PROPERTY,
 ITS EXTERIOR BOUNDARIES, THE LOCATION OF ALL
 VISIBLE STRUCTURES AND DIMENSIONS OF ALL
 PRINCIPAL BUILDINGS THEREON, BOUNDARY FENCES,
 APPARENT EASEMENTS, ROADWAYS AND VISIBLE
 ENCROACHMENTS, IF ANY, TO THE BEST OF MY
 KNOWLEDGE AND BELIEF.

THIS SURVEY IS MADE FOR THE USE OF THE
 PRESENT OWNERS OF THE PROPERTY AND ALSO
 THOSE WHO PURCHASE, MORTGAGE OR GUARANTEE
 THE TITLE THERETO WITHIN ONE (1) YEAR FROM
 DATE HEREOF.
 SURVEY NOT VALID UNLESS SURVEYOR'S SIGNATURE IS
 IN RED.



SCALE: 1" = 30'
 LEGEND

- ⊕ - IRON PIPE FOUND
- - CONC. MONUMENT FOUND
- - IRON PIPE SET
- △ - UTILITY POLE
- — — OVERHEAD UTILITY LINE
- () - AS RECORDED

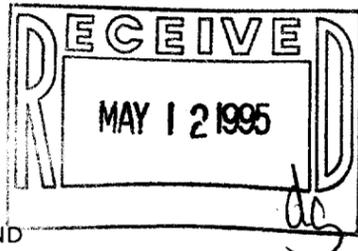

ISH-116

HAROLD H. KOLB
 WISCONSIN REGISTERED LAND SURVEYOR, S-187
 DATE DECEMBER 31, 1992
 REVISED: JUNE 21, 1994